


DATE: \_\_\_\_\_  
 BY: \_\_\_\_\_  
 SURVEYED: \_\_\_\_\_  
 PLOTTED: \_\_\_\_\_  
 CHECKED: \_\_\_\_\_  
 NO. \_\_\_\_\_

DATE: \_\_\_\_\_  
 BY: \_\_\_\_\_  
 SURVEYED: \_\_\_\_\_  
 PLOTTED: \_\_\_\_\_  
 CHECKED: \_\_\_\_\_  
 NO. \_\_\_\_\_

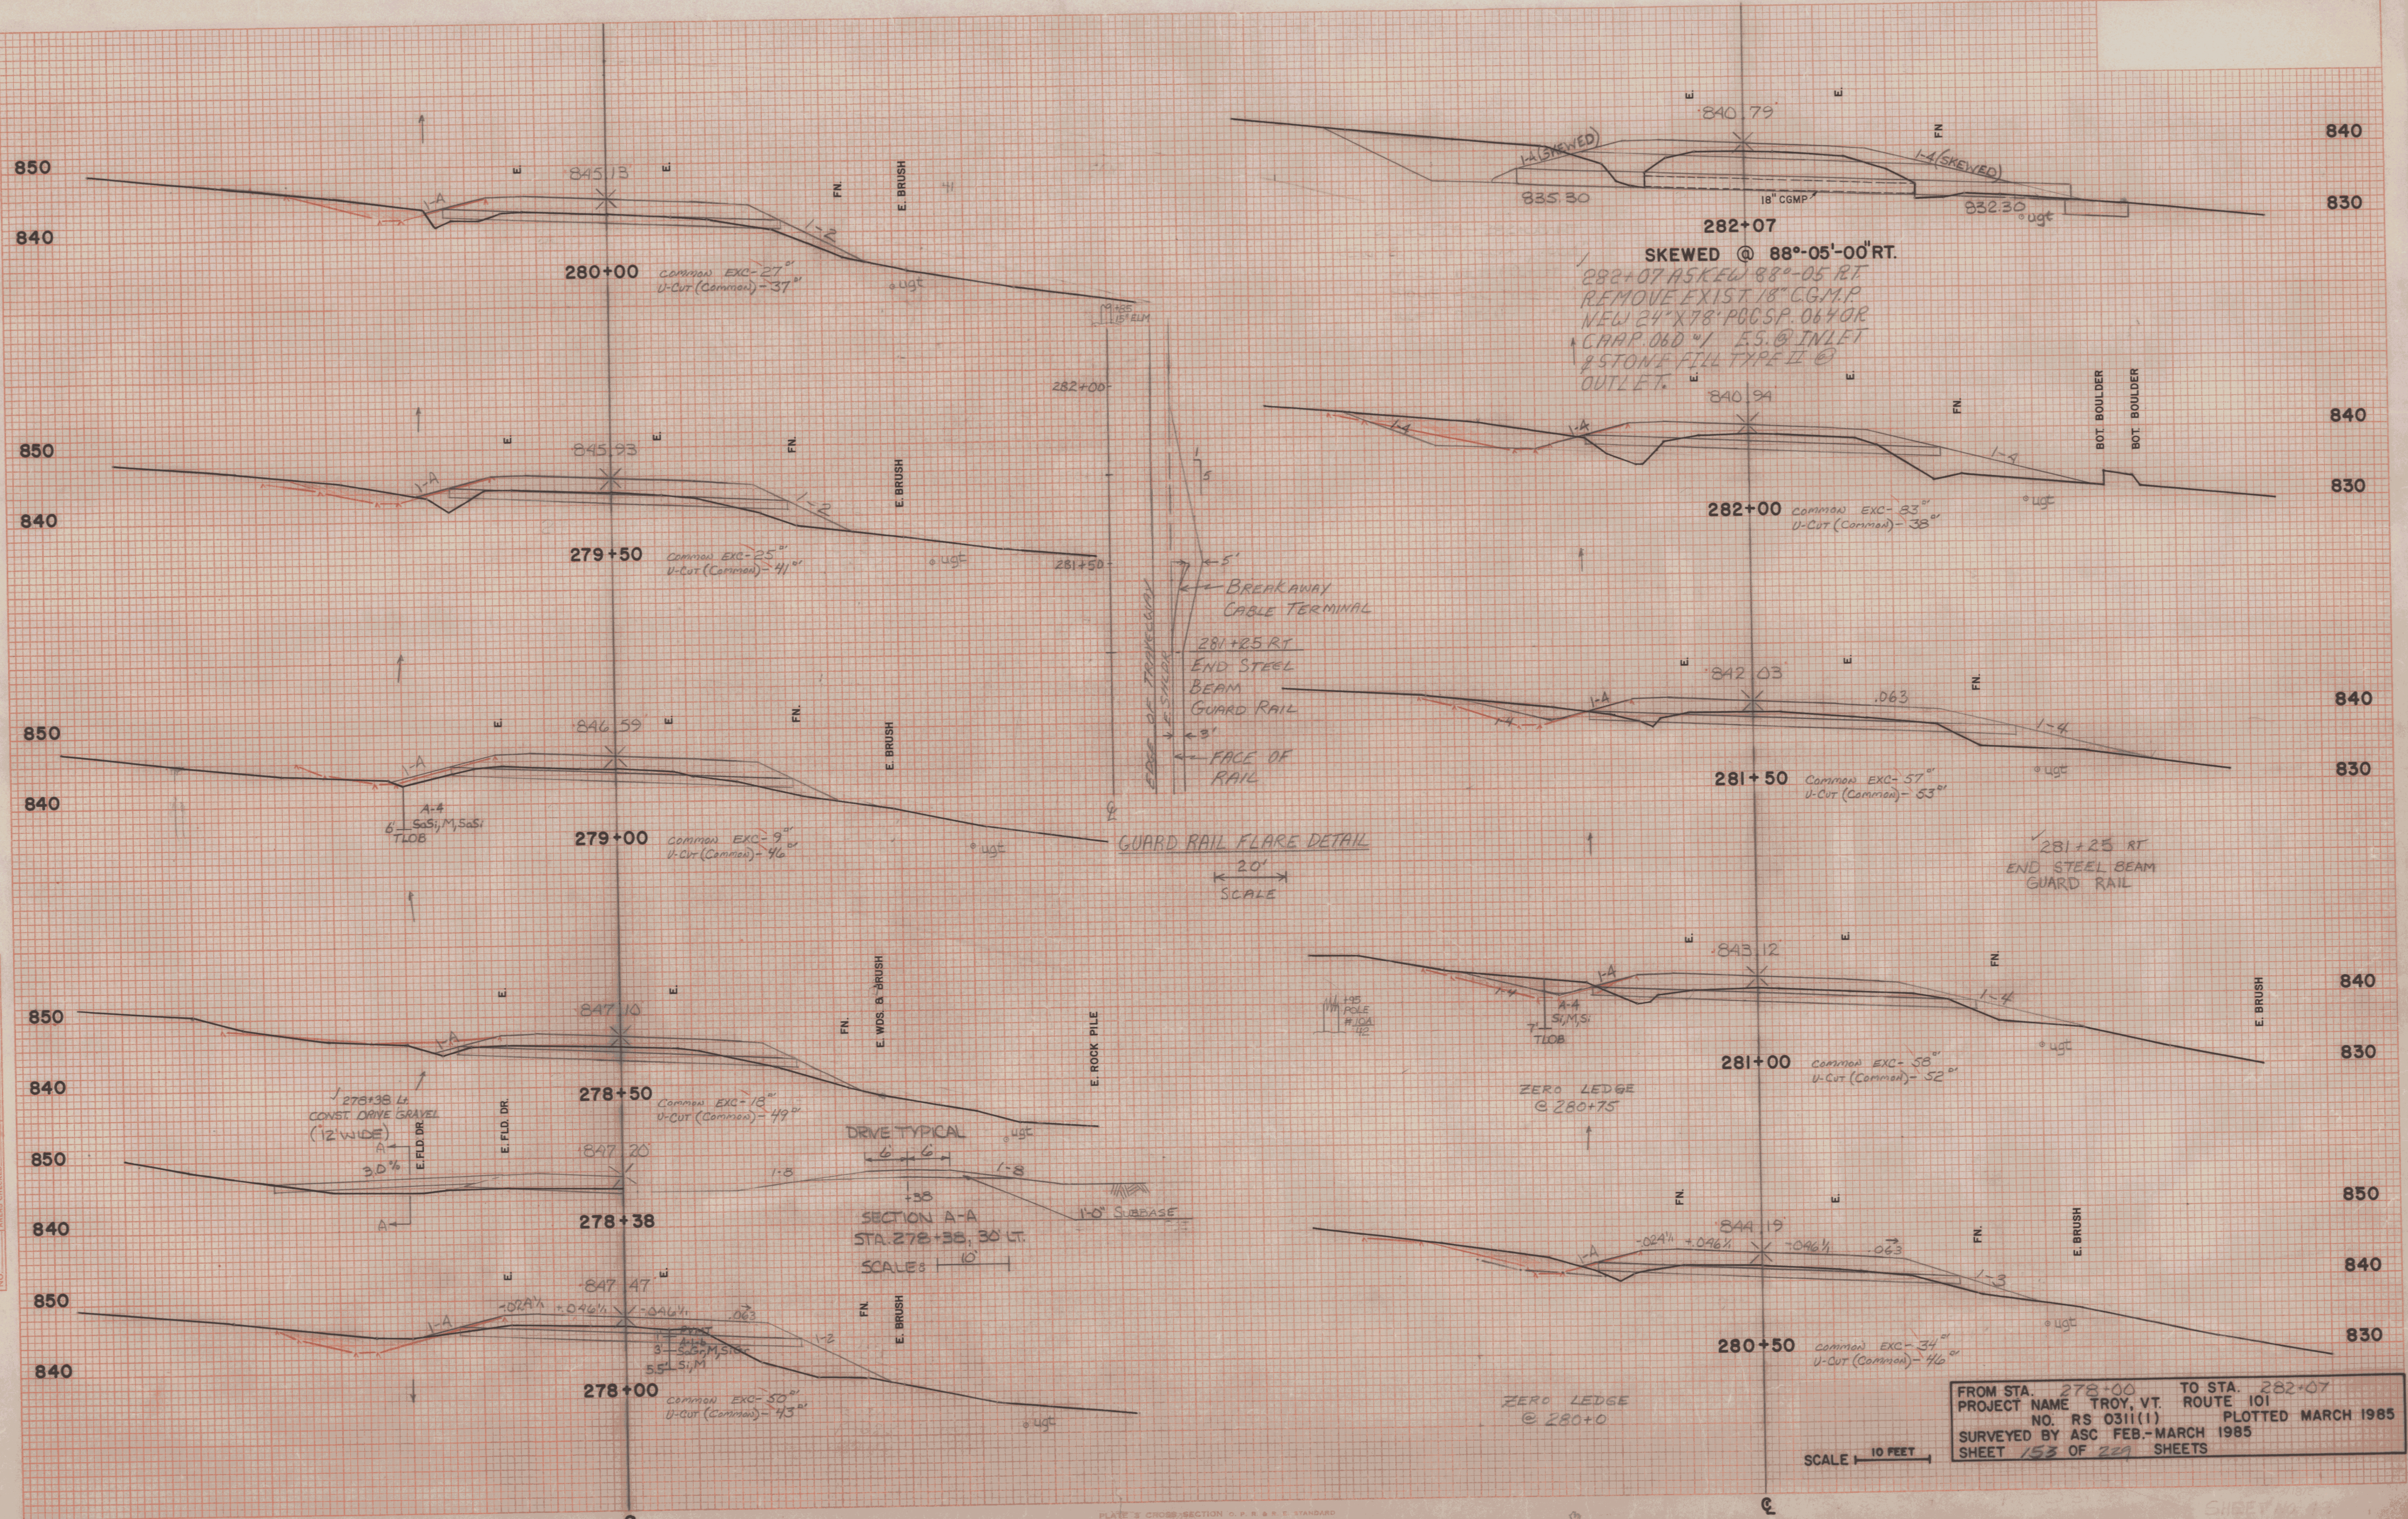

FROM STA. 278+00 TO STA. 282+07  
 PROJECT NAME TROY, VT. ROUTE 101  
 NO. RS 0311(1) PLOTTED MARCH 1985  
 SURVEYED BY ASC FEB.-MARCH 1985  
 SHEET 153 OF 229 SHEETS

SCALE 1" = 10 FEET

PLATE 3 CROSS-SECTION OF R.R. STANDARD  
 (EIGHTH EDITION)

REV - 4-1-72 1983

PLOTTED 12-9-91 LJS  
 REINTERPRETED 1-30-92 JEM

SHEET NO. 153

216 BY TJB 11/85