


DATE: \_\_\_\_\_  
 BY: \_\_\_\_\_  
 NO. \_\_\_\_\_  
 ORIGINAL SURVEY PLOTTED: \_\_\_\_\_  
 NOTE BOOK TEMPLATE: \_\_\_\_\_  
 AREAS CHECKED: \_\_\_\_\_

DATE: \_\_\_\_\_  
 BY: \_\_\_\_\_  
 NO. \_\_\_\_\_  
 ORIGINAL SURVEY PLOTTED: \_\_\_\_\_  
 NOTE BOOK TEMPLATE: \_\_\_\_\_  
 AREAS CHECKED: \_\_\_\_\_

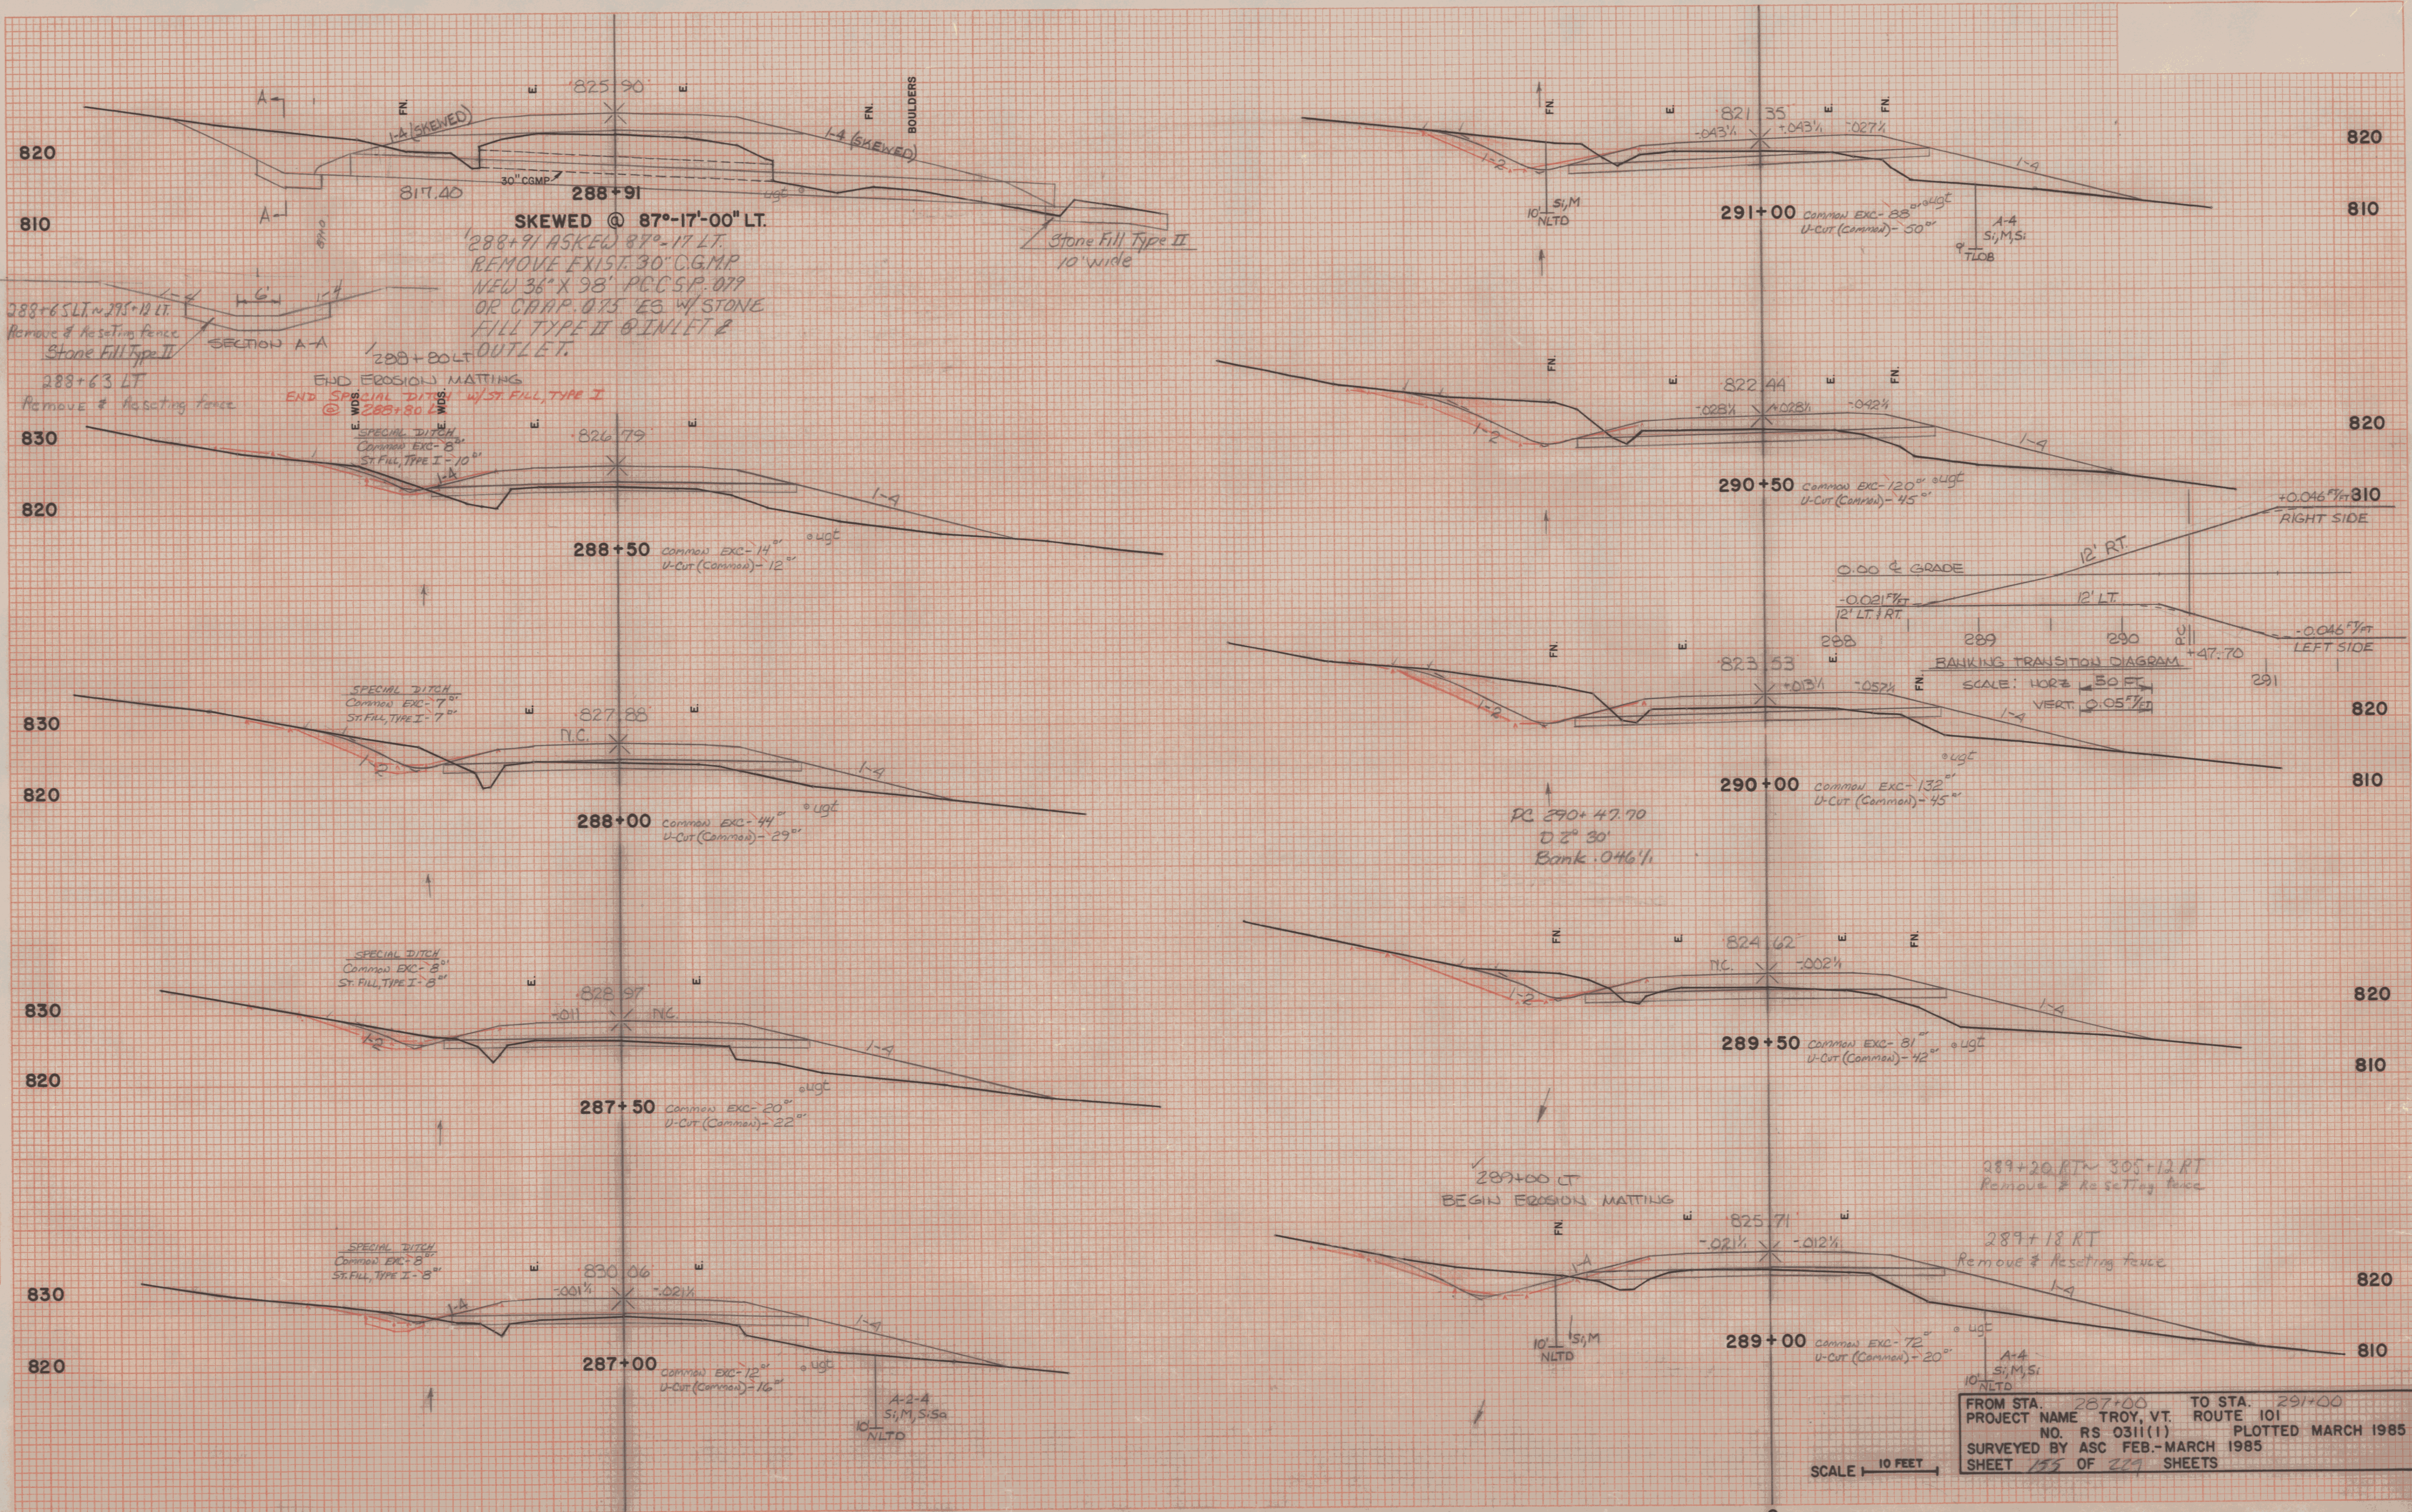

RAW - 4-1-92 GCS

SCALE 10 FEET  
 PLOTTED 12-10-85 LOS  
 PLANNED 1-31-92 LSP