
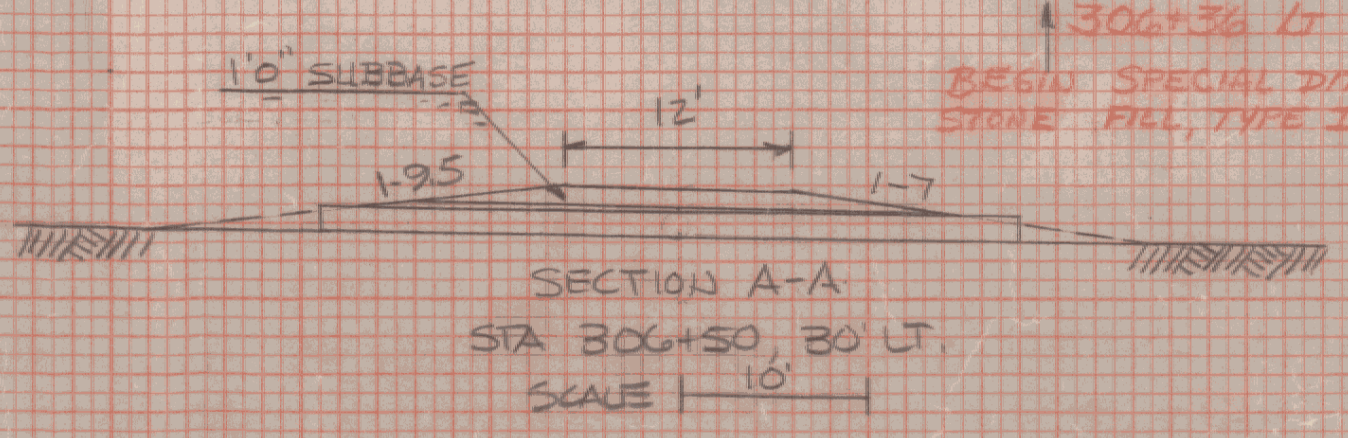


FINAL SURVEY NOTE BOOK

ORIGINAL SURVEY NOTE BOOK

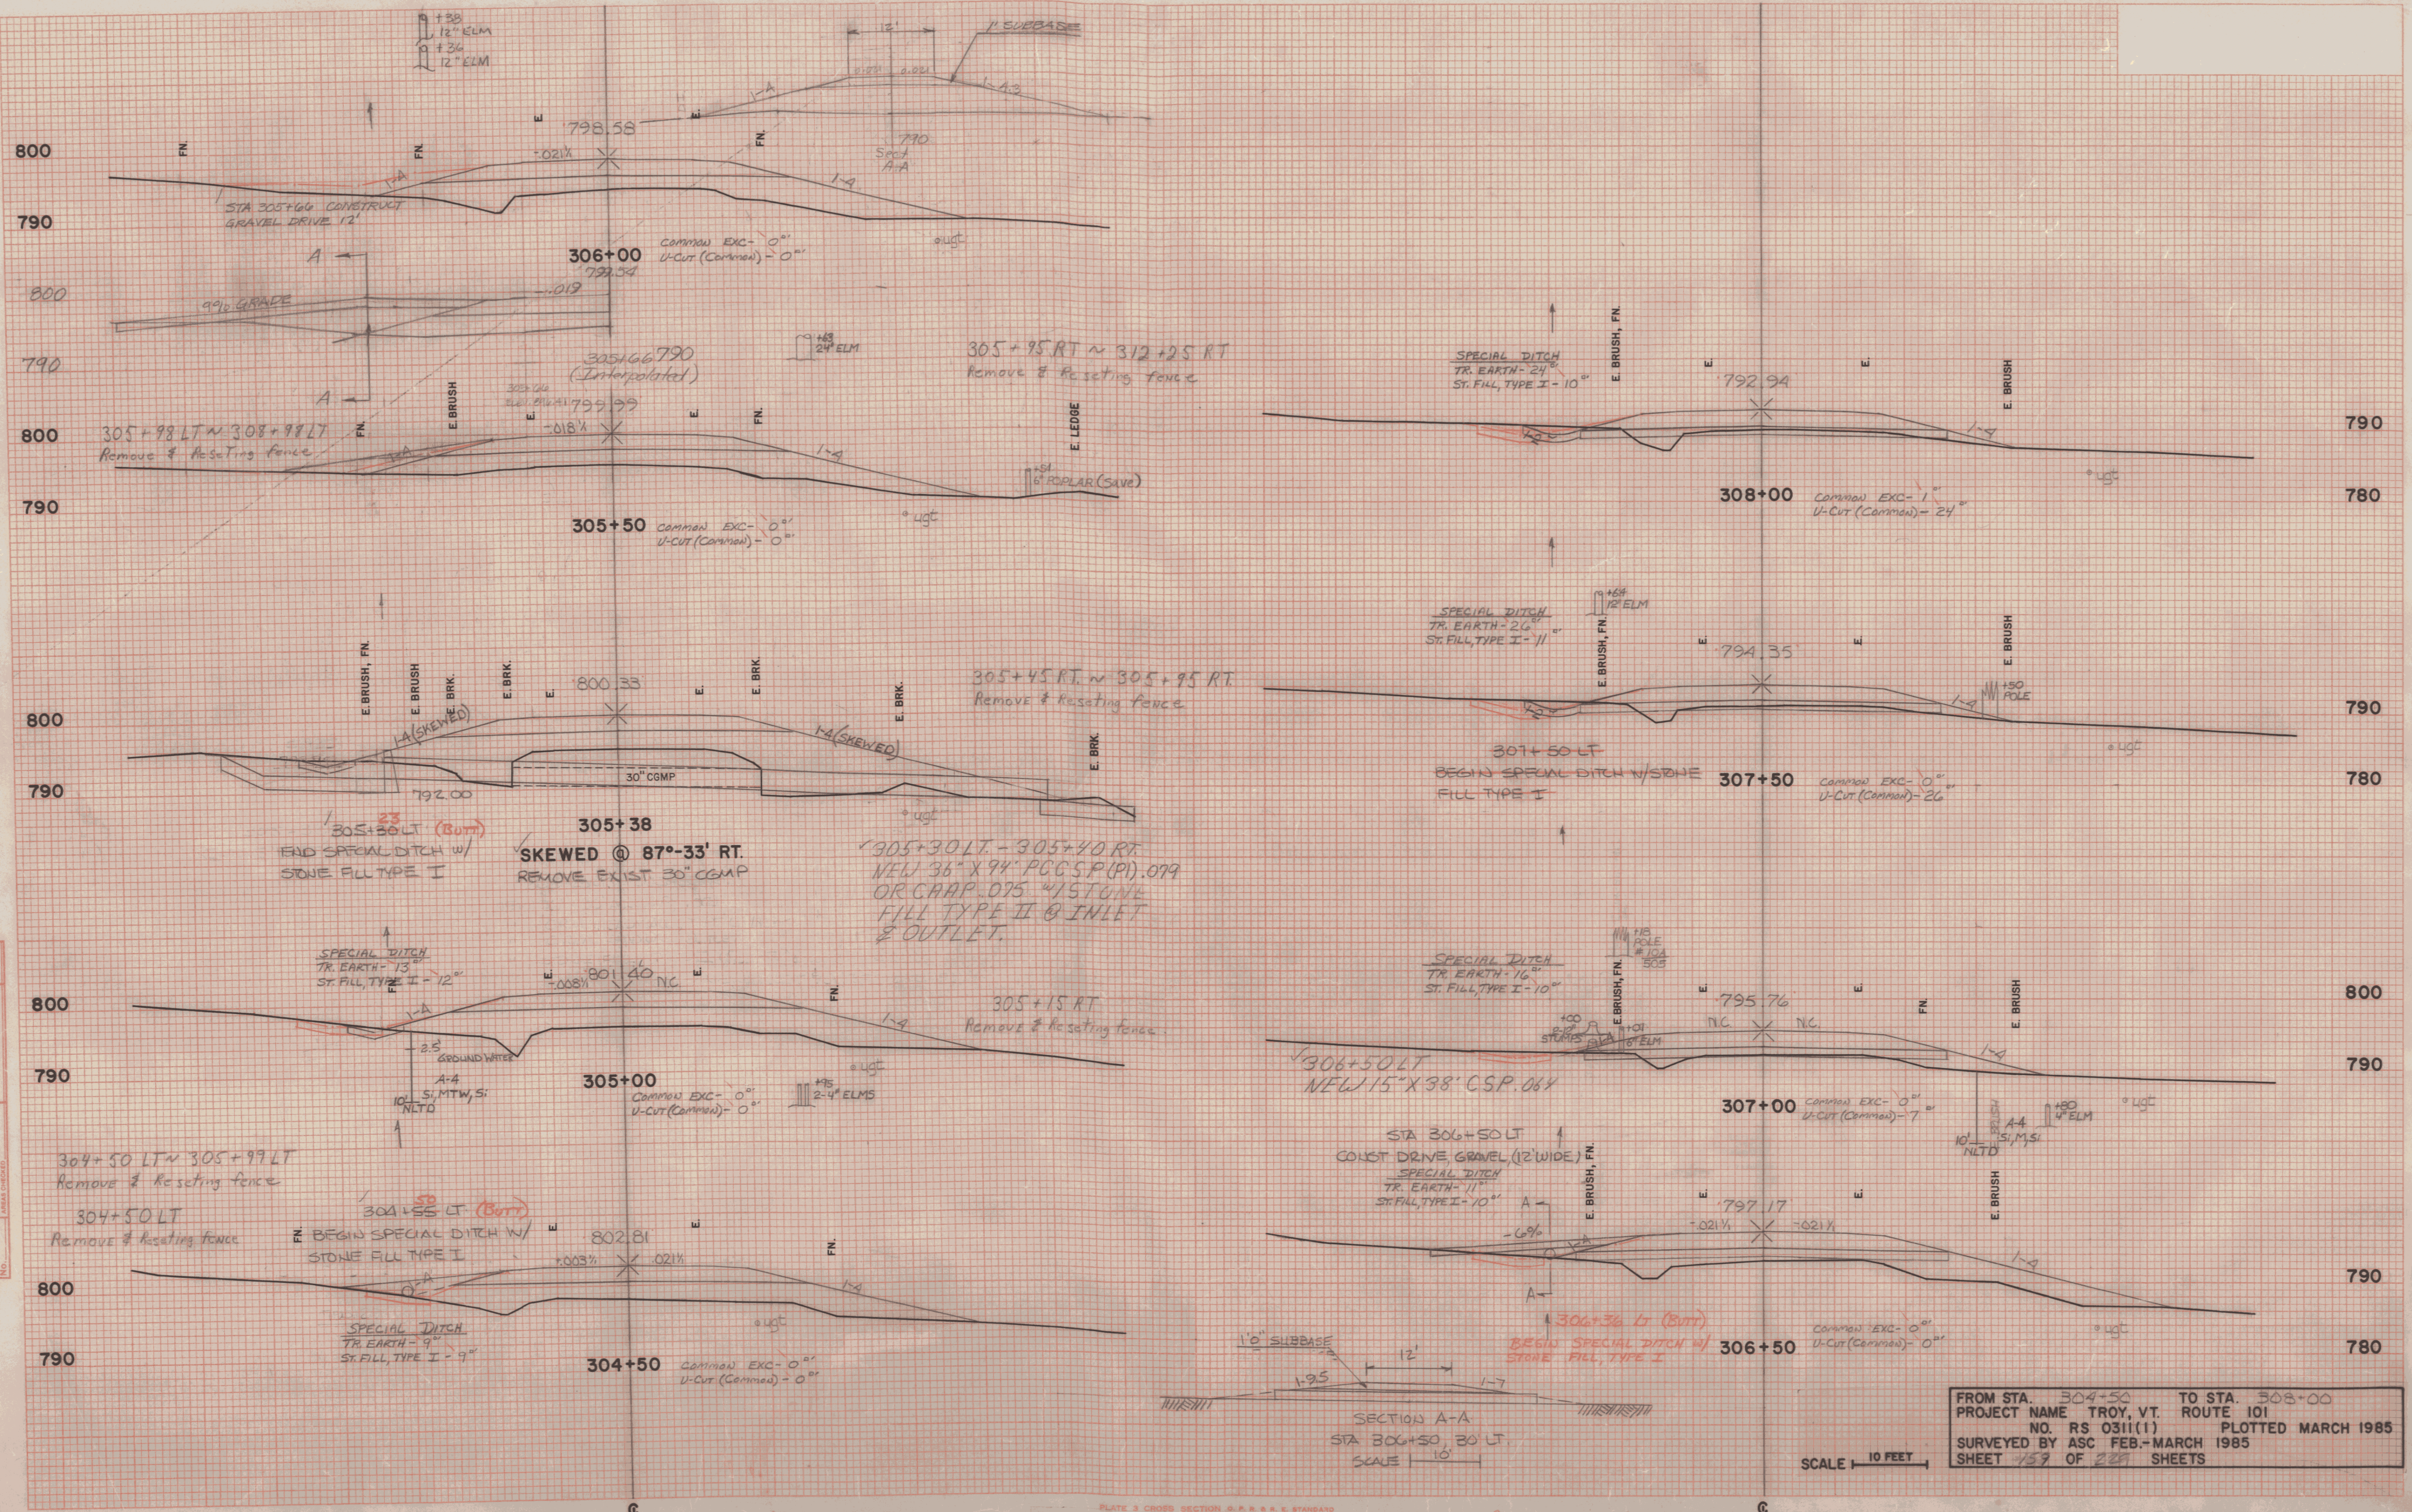

FROM STA. 304+50 TO STA. 308+00
PROJECT NAME TROY, VT. ROUTE 101
NO. RS 0311(1) PLOTTED MARCH 1985
SURVEYED BY ASC FEB.-MARCH 1985
SHEET 159 OF 229 SHEETS

SCALE 10 FEET

PL-4-1-92 D-3

PLOTTED 12-2-85
PARAMETERED 2-4-92 XEM