
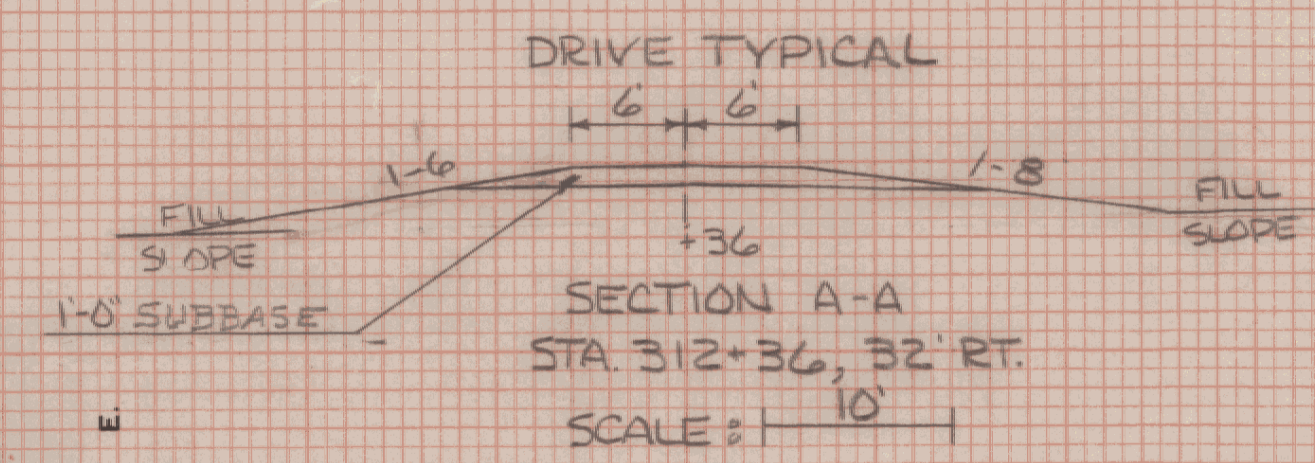
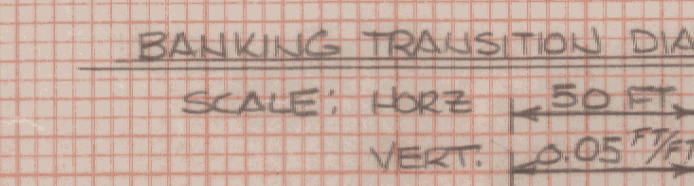


DATE: \_\_\_\_\_ BY: \_\_\_\_\_  
 ORIGINAL SURVEY PLOTTED: \_\_\_\_\_  
 NOTE BOOK: \_\_\_\_\_  
 NO. \_\_\_\_\_

DATE: \_\_\_\_\_ BY: \_\_\_\_\_  
 ORIGINAL SURVEY PLOTTED: \_\_\_\_\_  
 NOTE BOOK: \_\_\_\_\_  
 NO. \_\_\_\_\_

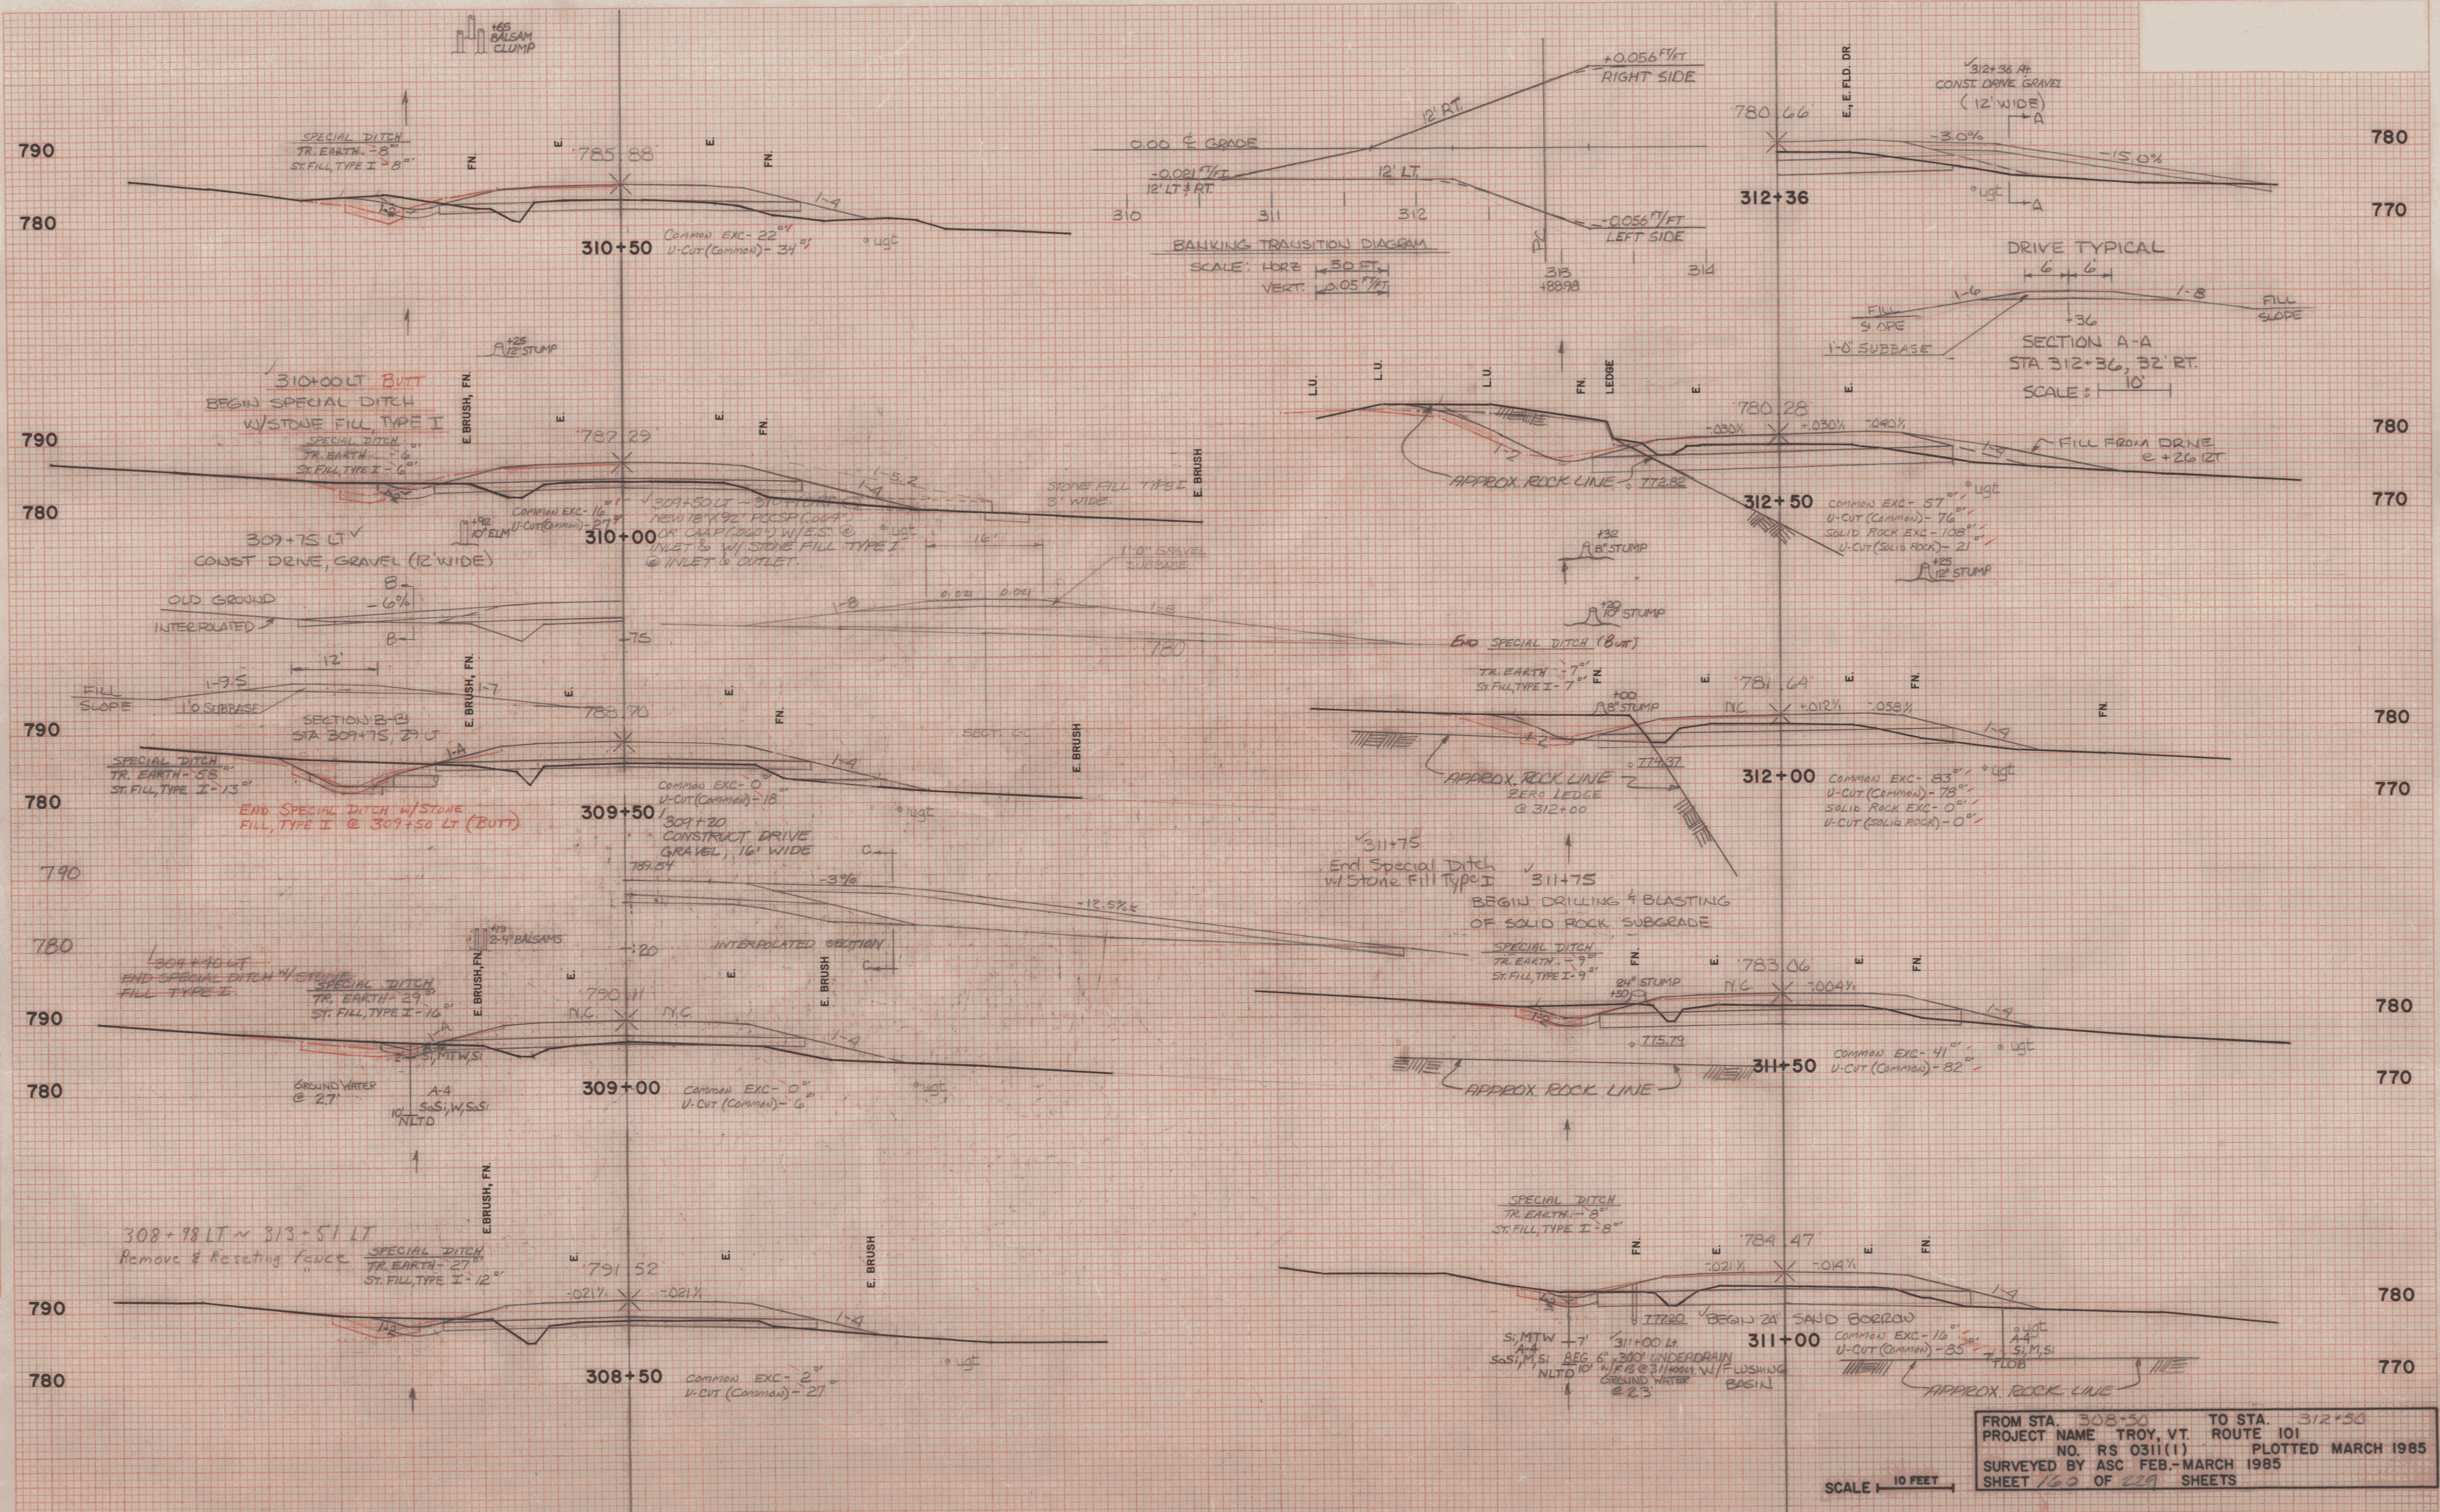

FROM STA. 308+50 TO STA. 312+50  
 PROJECT NAME TROY, VT. ROUTE 101  
 NO. RS 0311(1) PLOTTED MARCH 1985  
 SURVEYED BY ASC FEB.-MARCH 1985  
 SHEET 160 OF 219 SHEETS

PLANIMETERED 2-4-92

PLATE 3 CROSS SECTION O.P.R.R.E. STANDARD  
 DIETZEN CORPORATION

SCALE 1" = 10 FEET  
 PLOTTED 4-7-92  
 PLANIMETERED 4-8-92  
 1" = 10' 4-9-92