


DATE: \_\_\_\_\_  
 BY: \_\_\_\_\_  
 SURVEYED: \_\_\_\_\_  
 PLOTTED: \_\_\_\_\_  
 TEMPLATE: \_\_\_\_\_  
 NOTE BOOK: \_\_\_\_\_  
 NO. \_\_\_\_\_

DATE: \_\_\_\_\_  
 BY: \_\_\_\_\_  
 SURVEYED: \_\_\_\_\_  
 PLOTTED: \_\_\_\_\_  
 TEMPLATE: \_\_\_\_\_  
 NOTE BOOK: \_\_\_\_\_  
 NO. \_\_\_\_\_

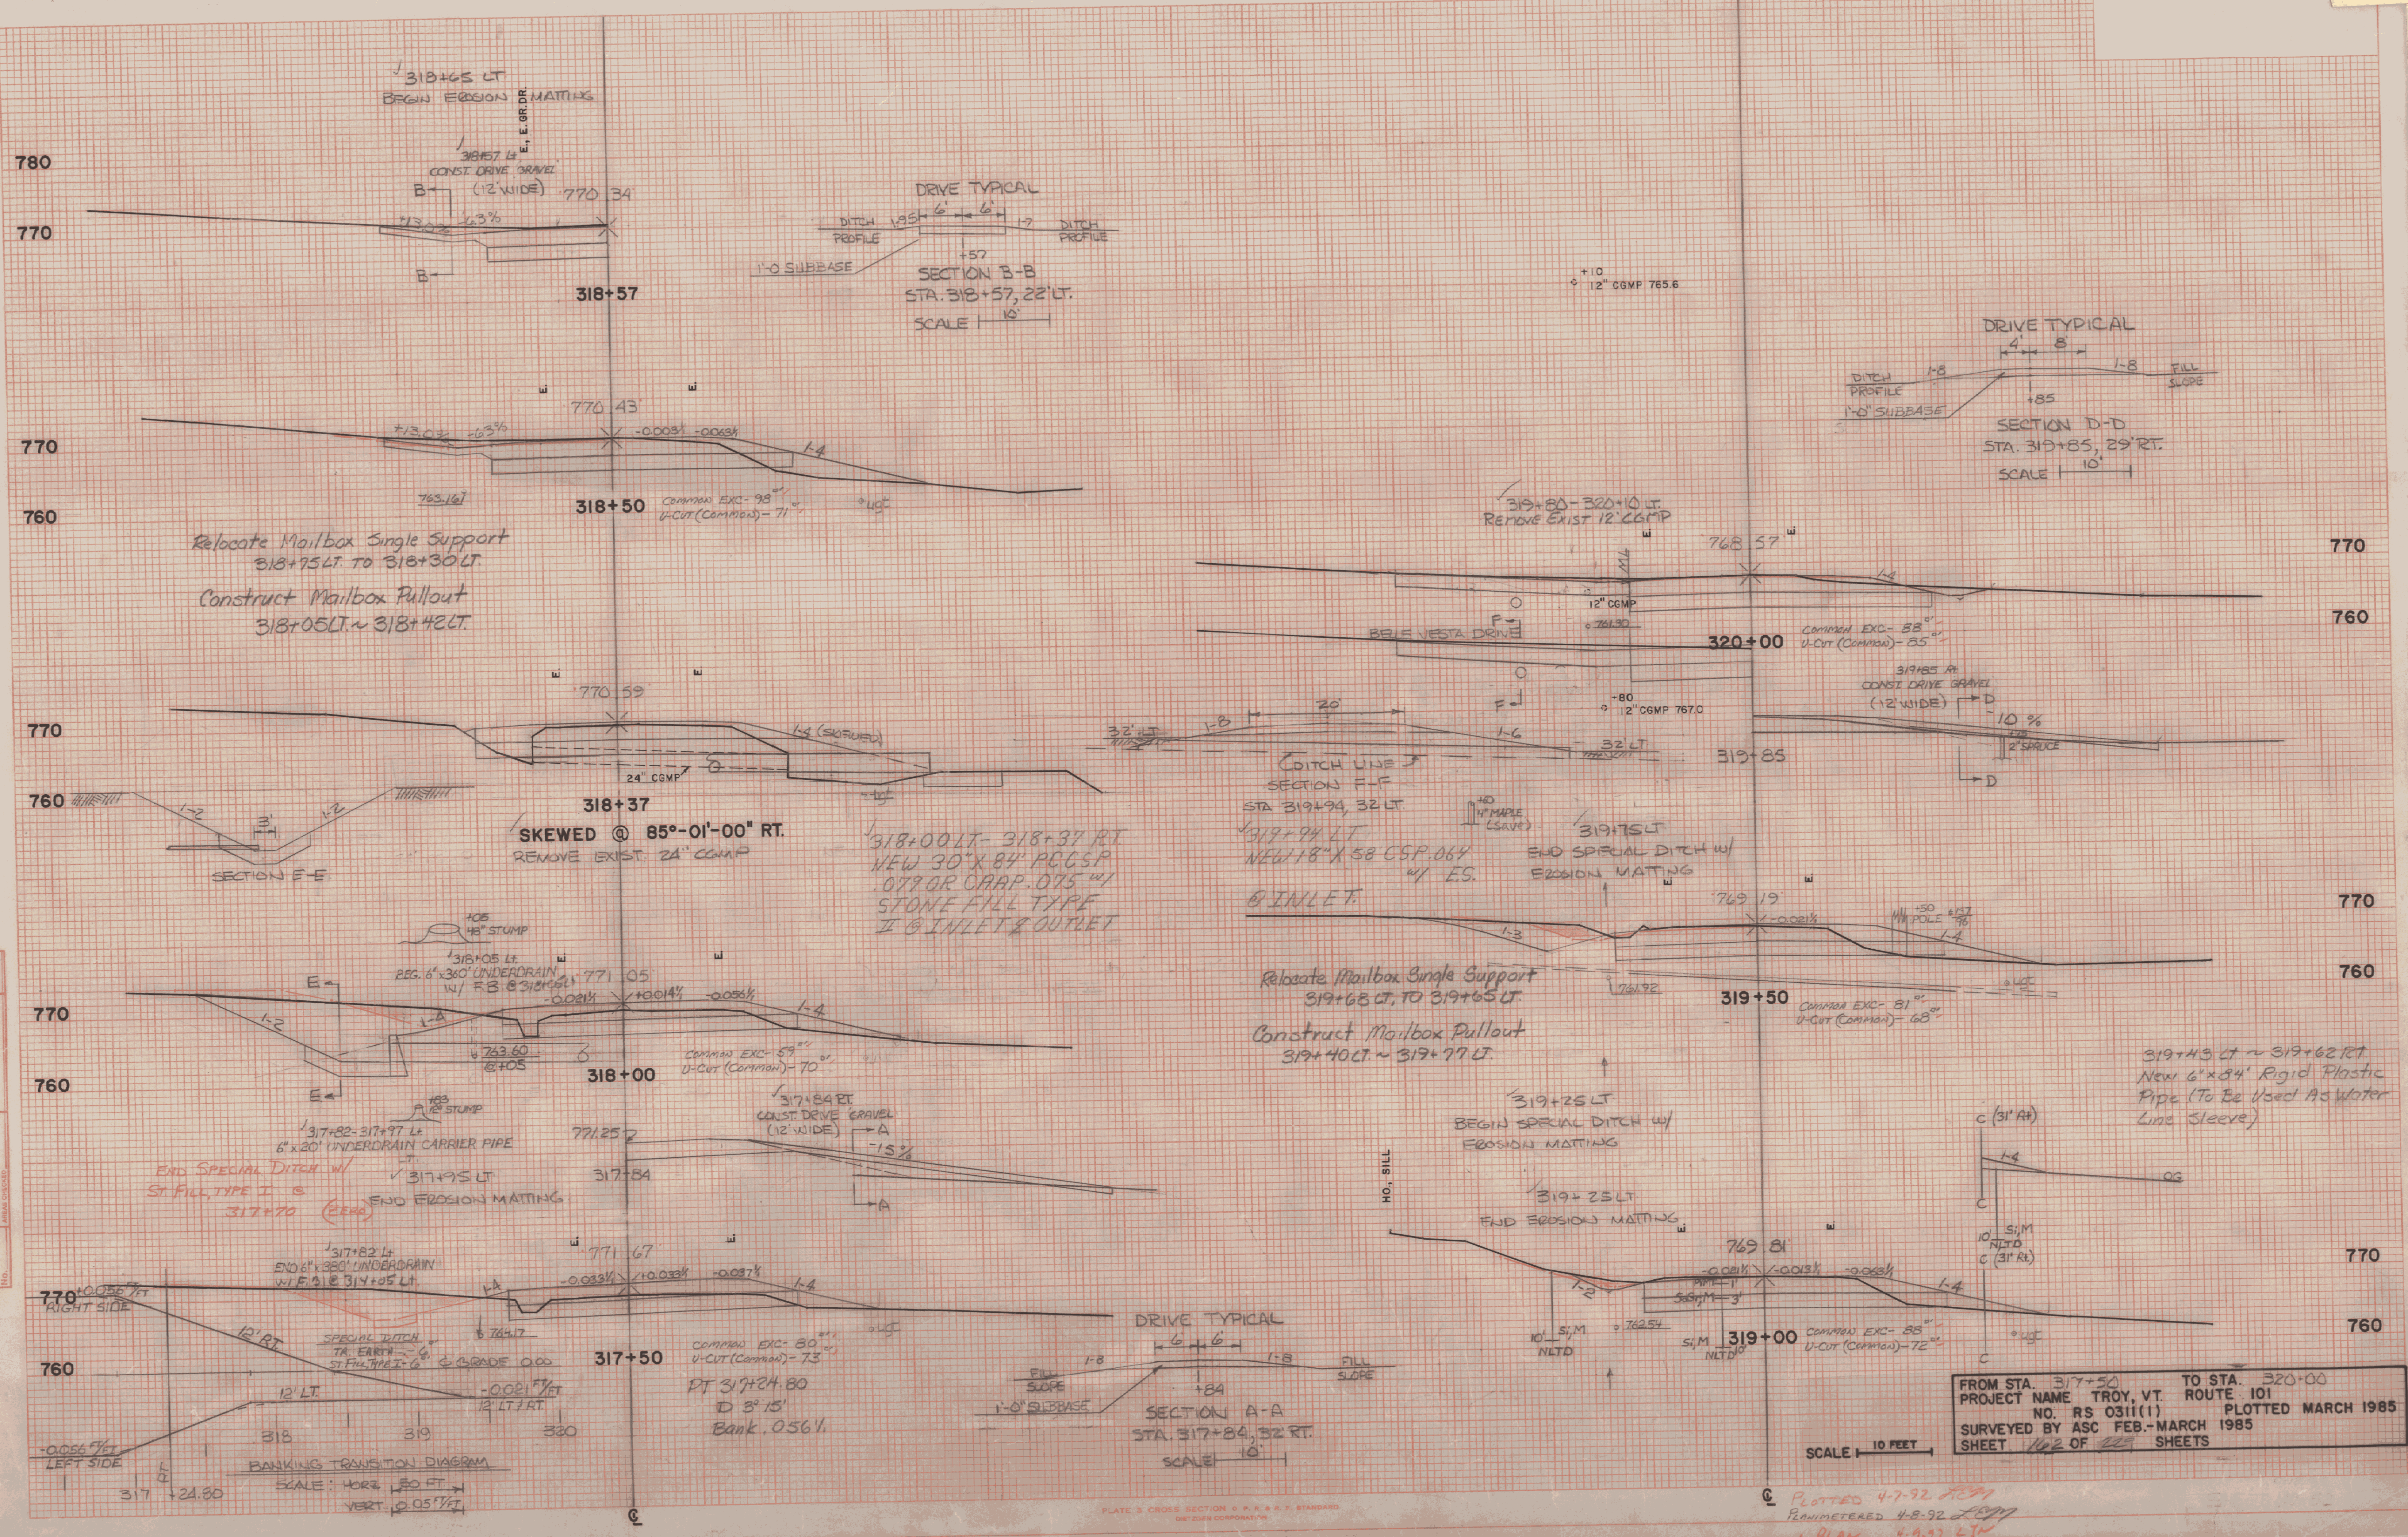

FROM STA. 317+50 TO STA. 320+00  
 PROJECT NAME TROY, VT. ROUTE 101  
 NO. RS 0311(1) PLOTTED MARCH 1985  
 SURVEYED BY ASC FEB.-MARCH 1985  
 SHEET 102 OF 122 SHEETS

SCALE 1" = 10 FEET  
 PLOTTED 4-7-92 JCM  
 RANIMETERED 4-8-92 JCM  
 PLAN 4-9-92 LHM