
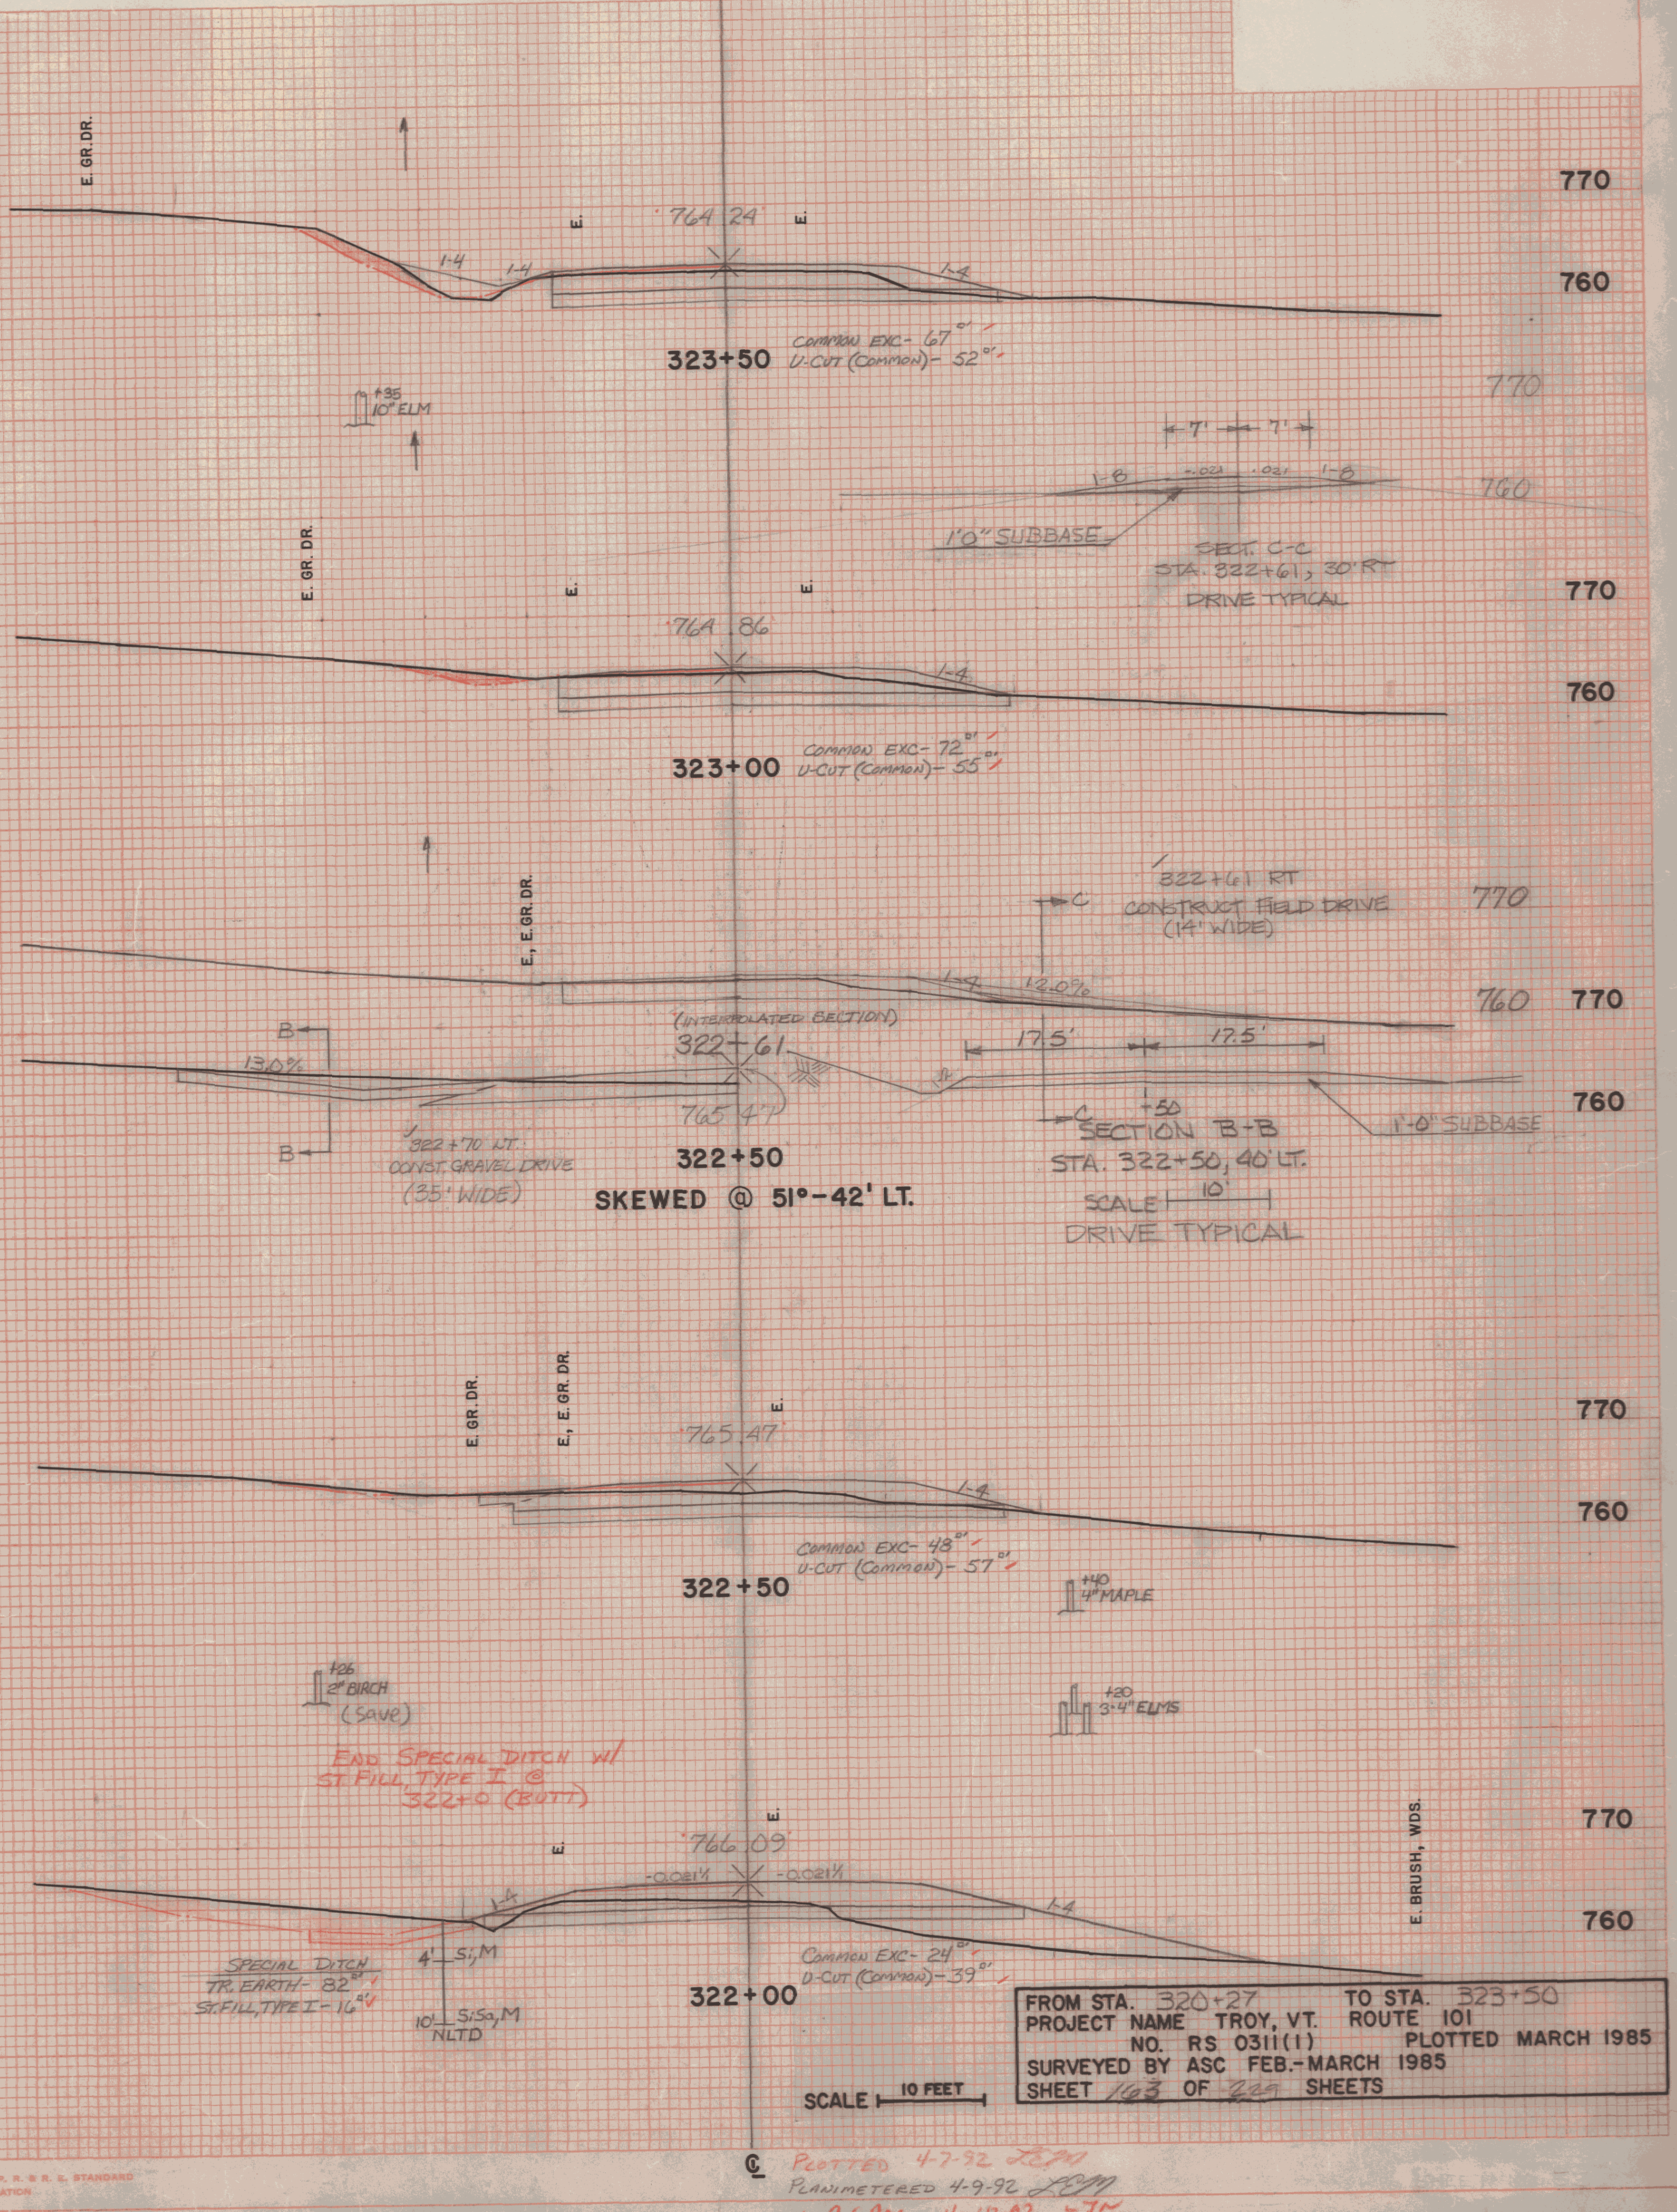


DATE
BY
REVISIONS
NO. DATE
APPROVED
DATE
ORIGINAL SURVEY NOTE BOOK NO. DATE

DATE
BY
REVISIONS
NO. DATE
APPROVED
DATE
ORIGINAL SURVEY NOTE BOOK NO. DATE

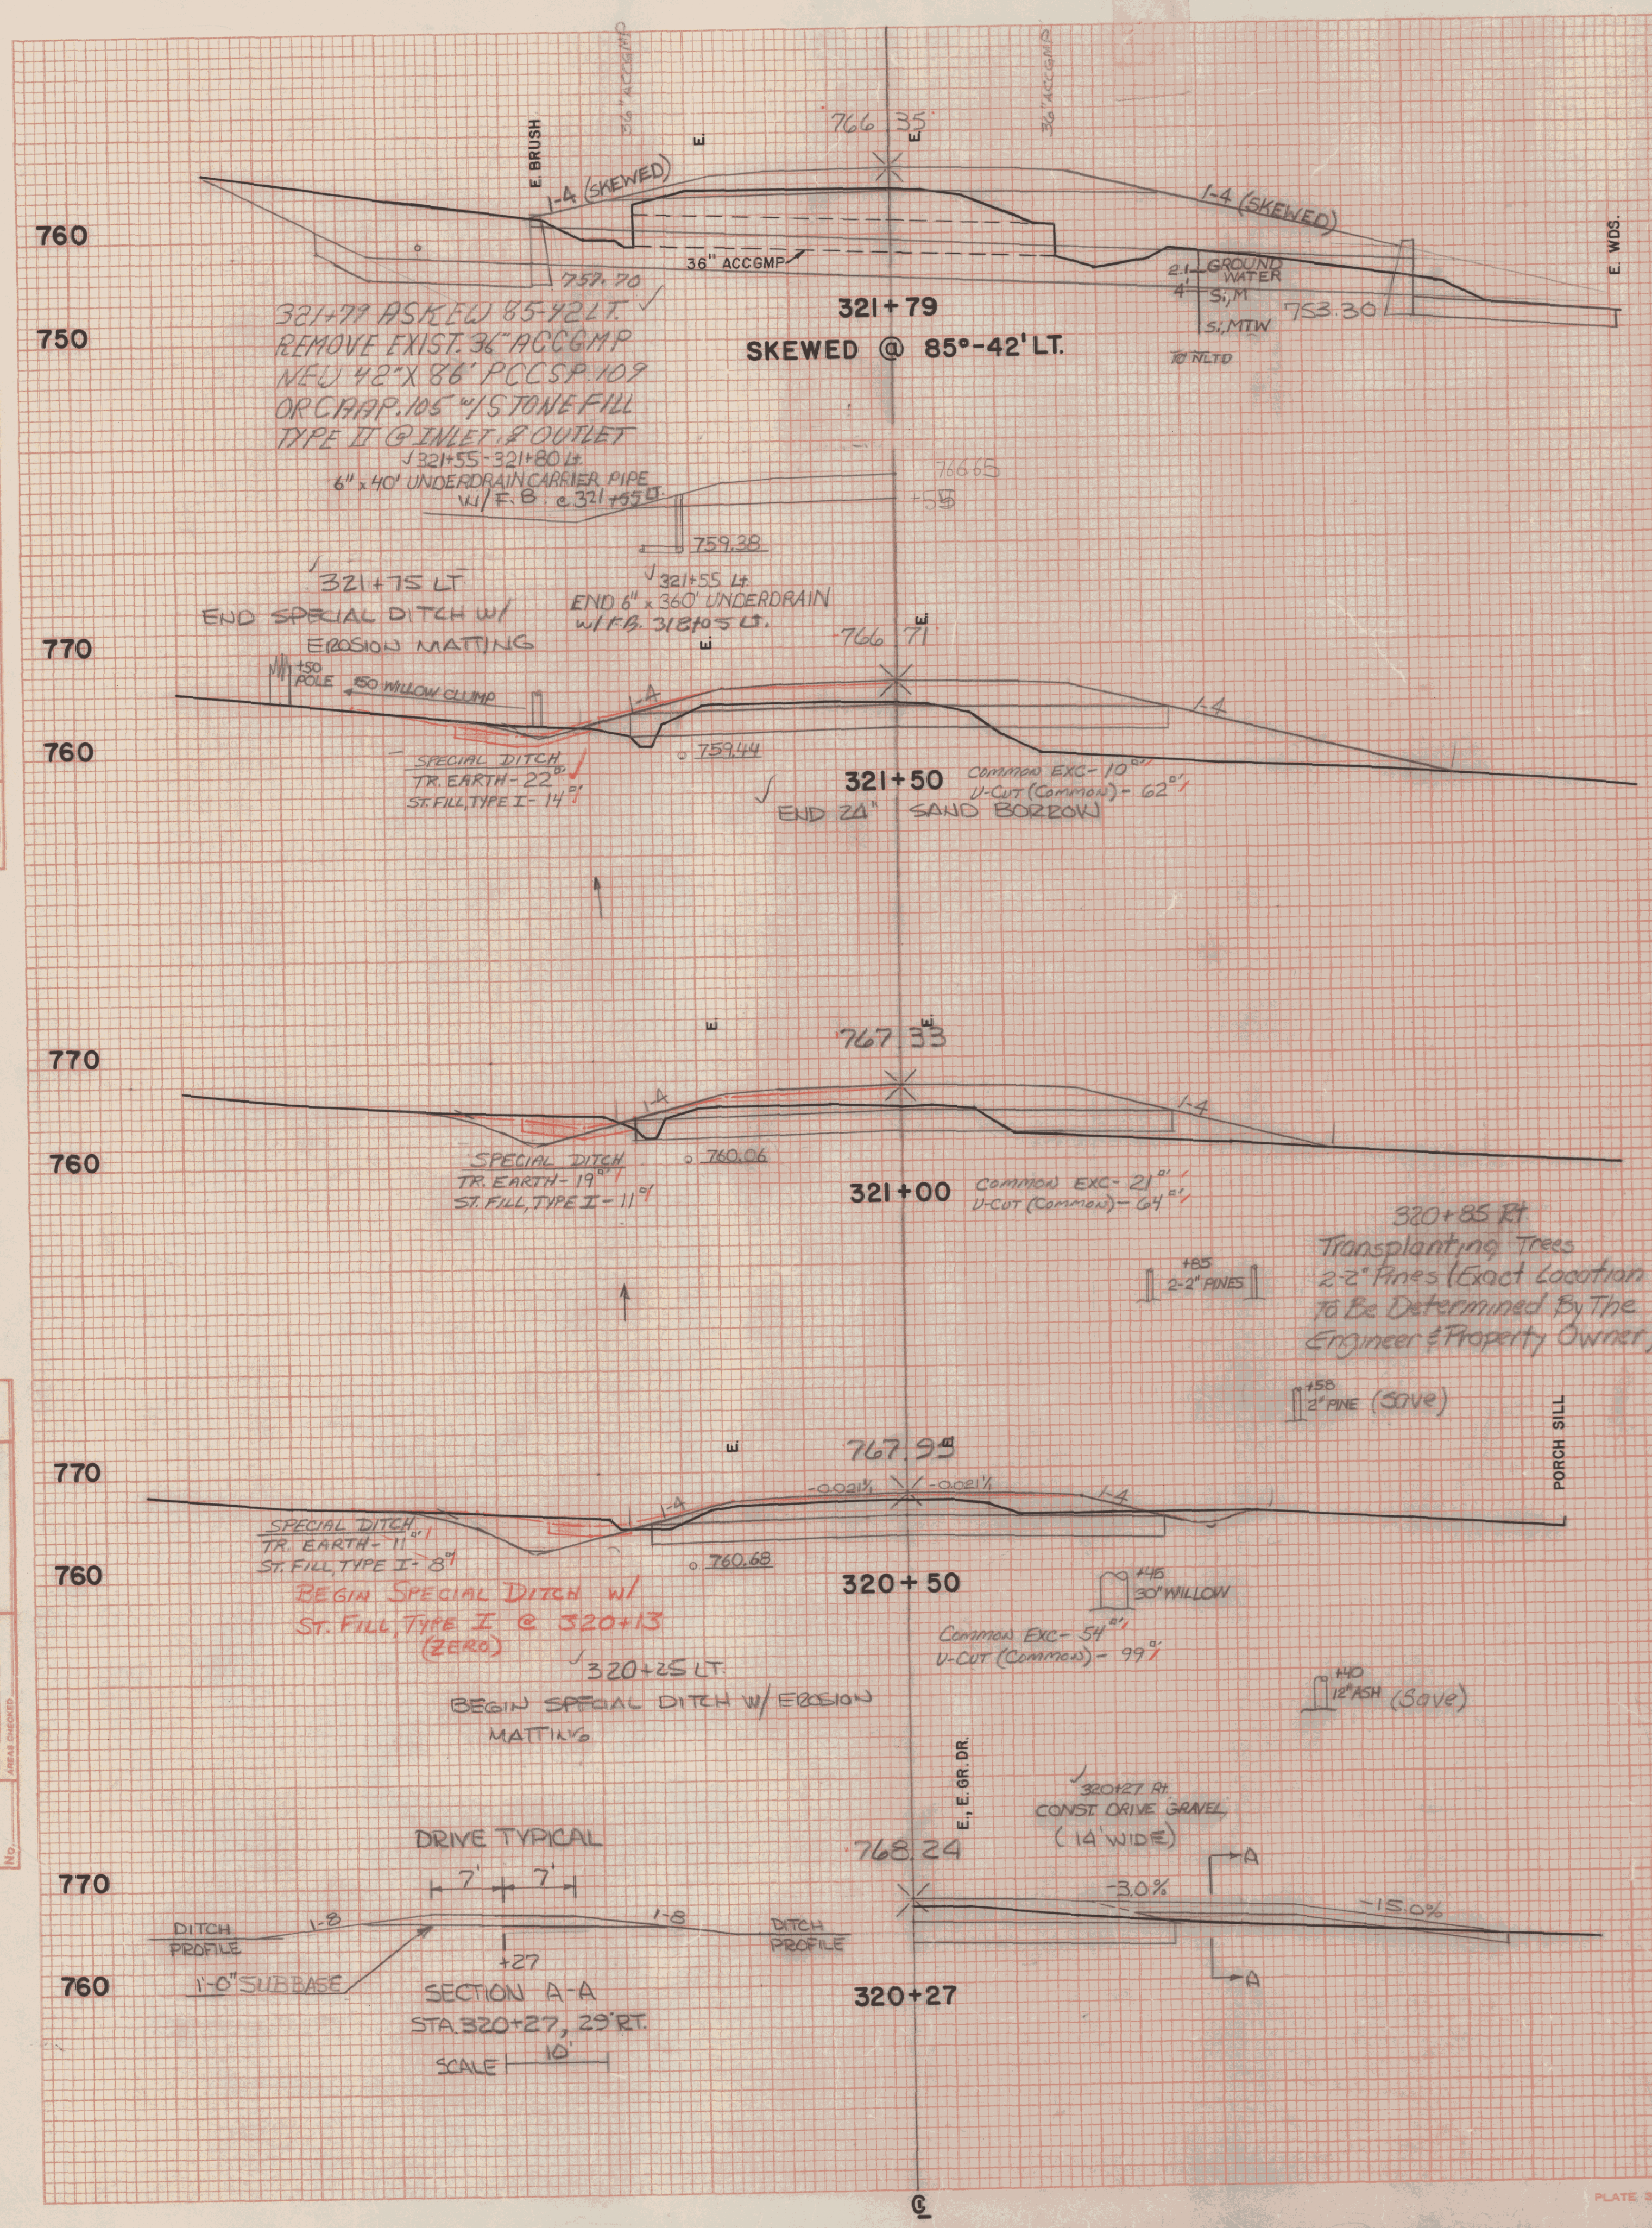

FROM STA. 320+27 TO STA. 323+50
PROJECT NAME TROY, VT. ROUTE 101
NO. RS 0311(1) PLOTTED MARCH 1985
SURVEYED BY ASC FEB.-MARCH 1985
SHEET 103 OF 200 SHEETS

SCALE 10 FEET

PLOTTED 4-7-92 JEM
PLANIMETERED 4-9-92 LCM
PLAN 4-10-92 JEM