


FINAL SURVEY NO. DATE  
 APPROVED BY  
 DATE  
 ORIGINAL SURVEY NO. DATE  
 NOTE BOOK NO. DATE  
 APPROVED BY

ORIGINAL SURVEY NO. DATE  
 APPROVED BY  
 DATE  
 ORIGINAL SURVEY NO. DATE  
 NOTE BOOK NO. DATE  
 APPROVED BY

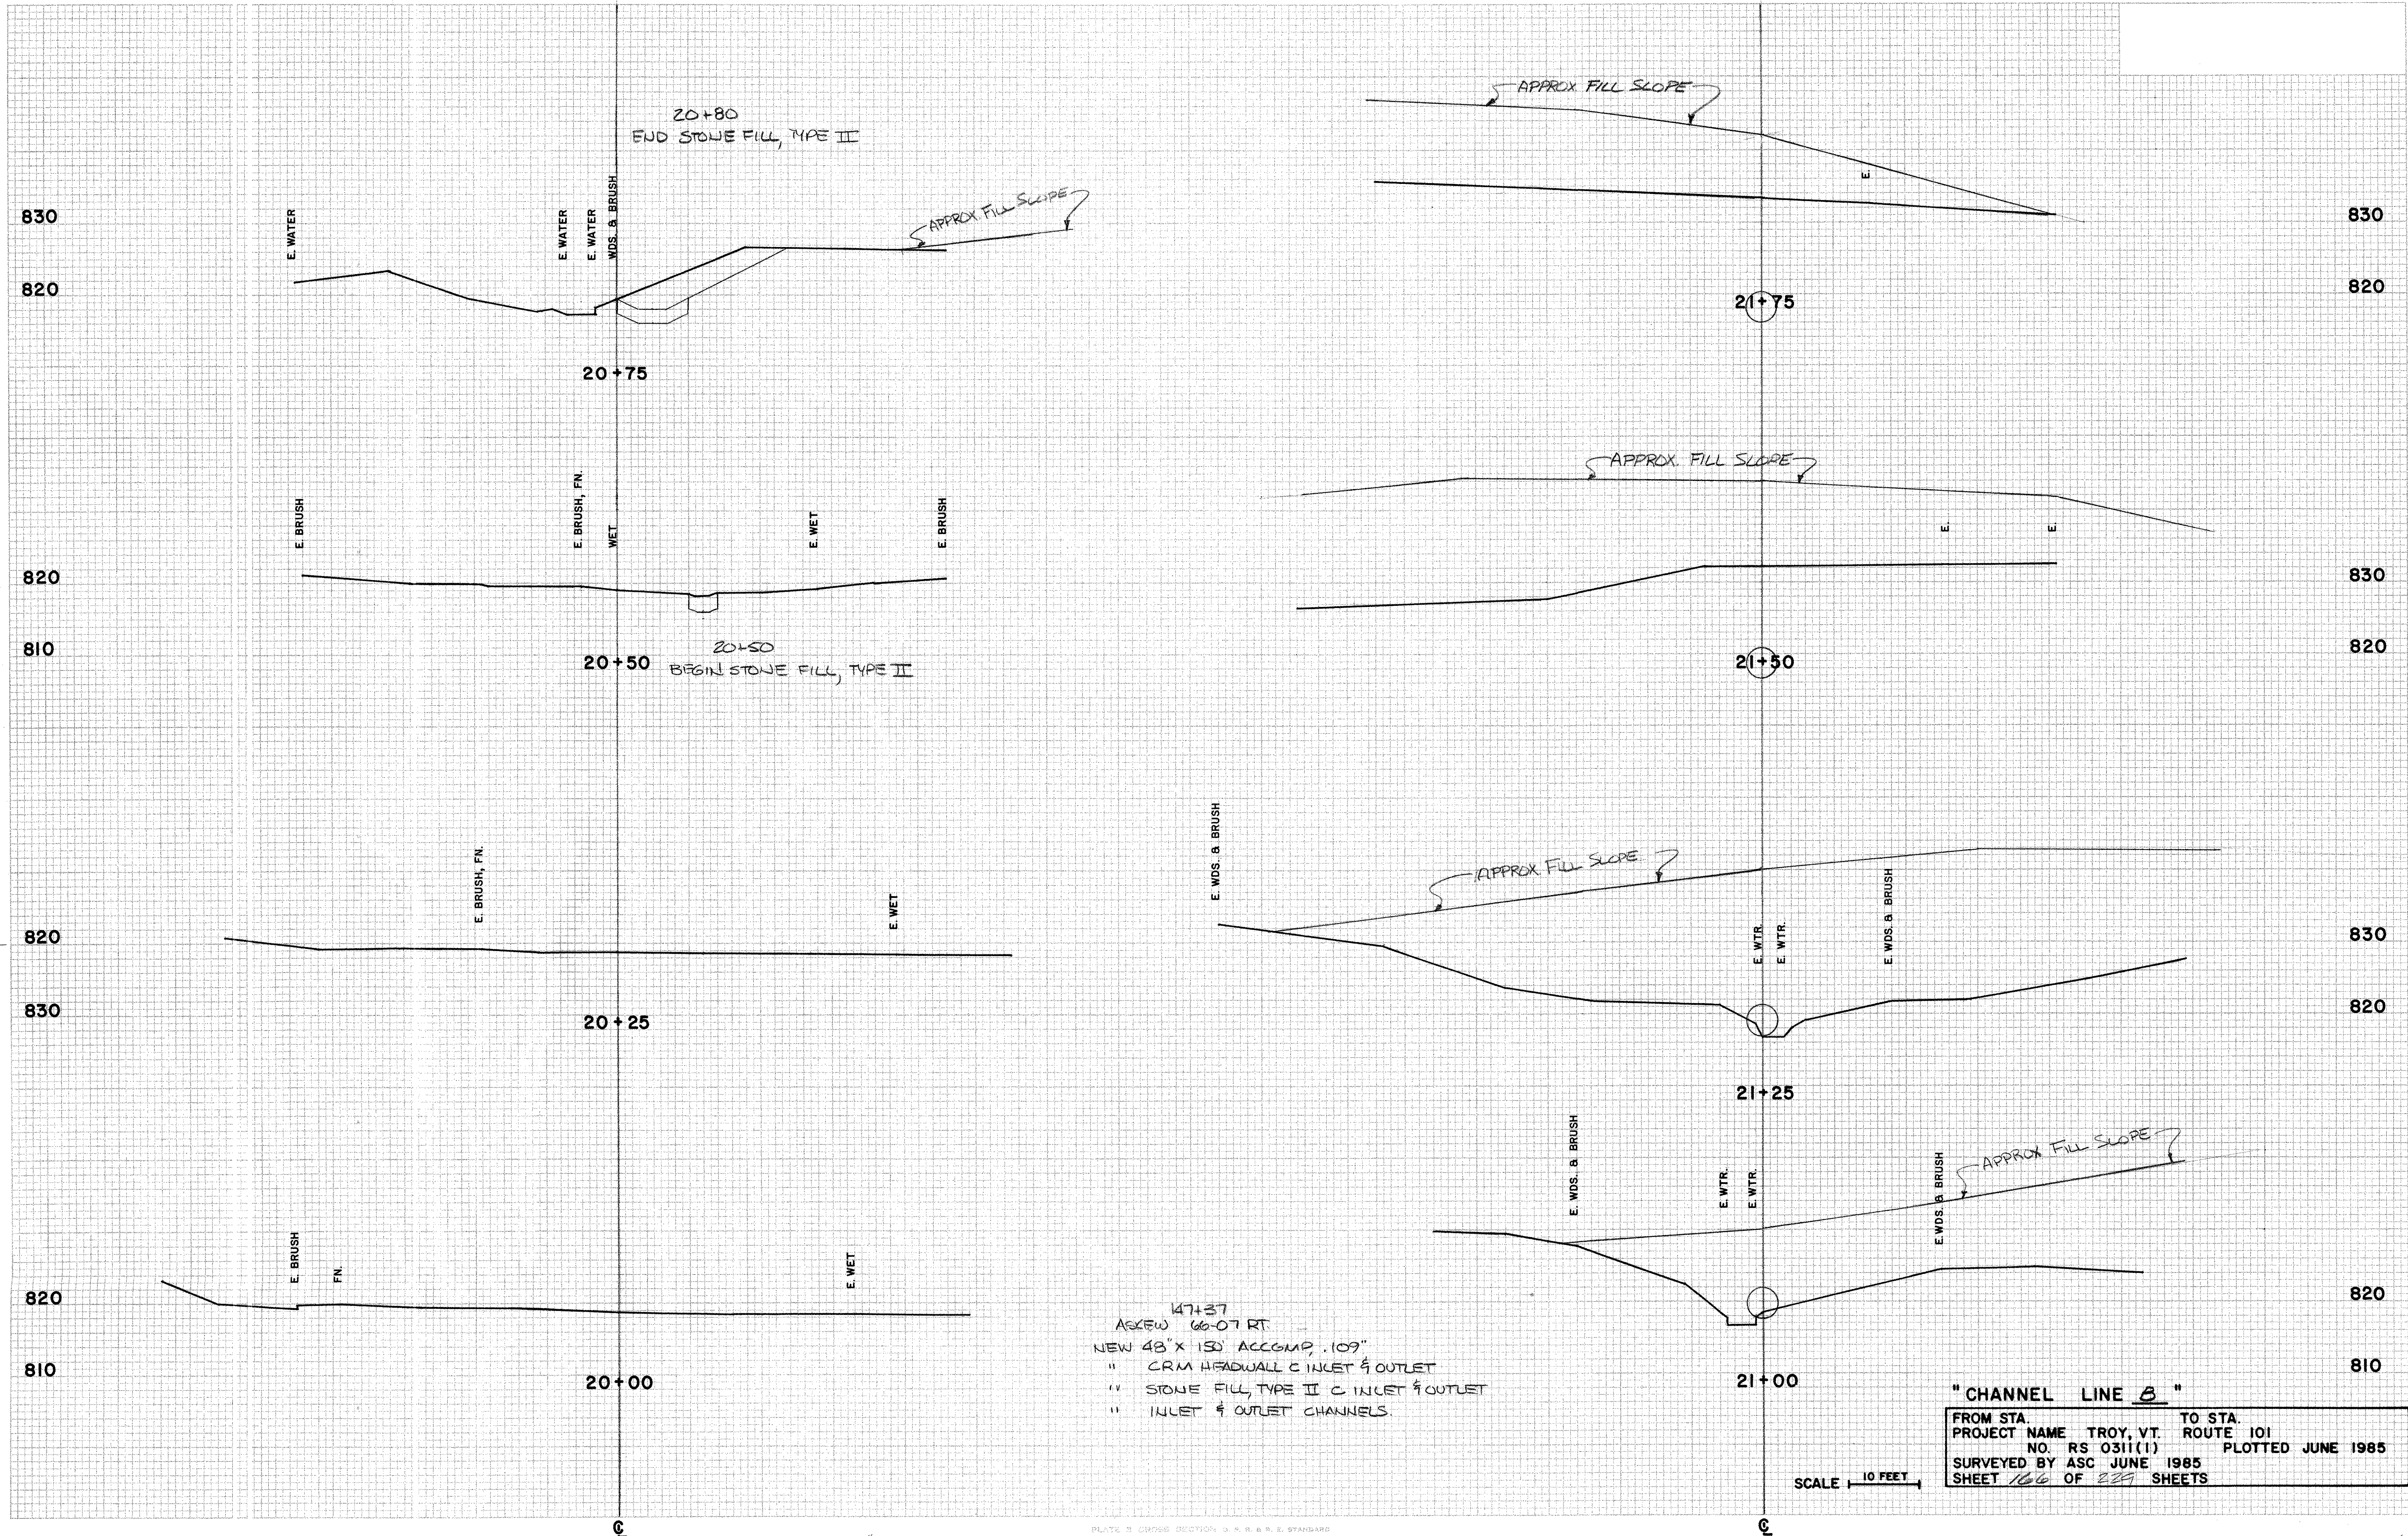

47+37  
 ASKEW 66-07 RT  
 NEW 48" X 150' ACCOMP. 109"  
 " CRM HEADWALL C INLET & OUTLET  
 " STONE FILL, TYPE II C INLET & OUTLET  
 " INLET & OUTLET CHANNELS.

"CHANNEL LINE B"  
 FROM STA. TO STA.  
 PROJECT NAME TROY, VT. ROUTE 101  
 NO. RS 0311(1) PLOTTED JUNE 1985  
 SURVEYED BY ASC JUNE 1985  
 SHEET 166 OF 229 SHEETS

SCALE 10 FEET