


DATE	
BY	
REVISION	
PLOTTED	
NOTE BOOK	
NO.	

DATE	
BY	
REVISION	
PLOTTED	
NOTE BOOK	
NO.	

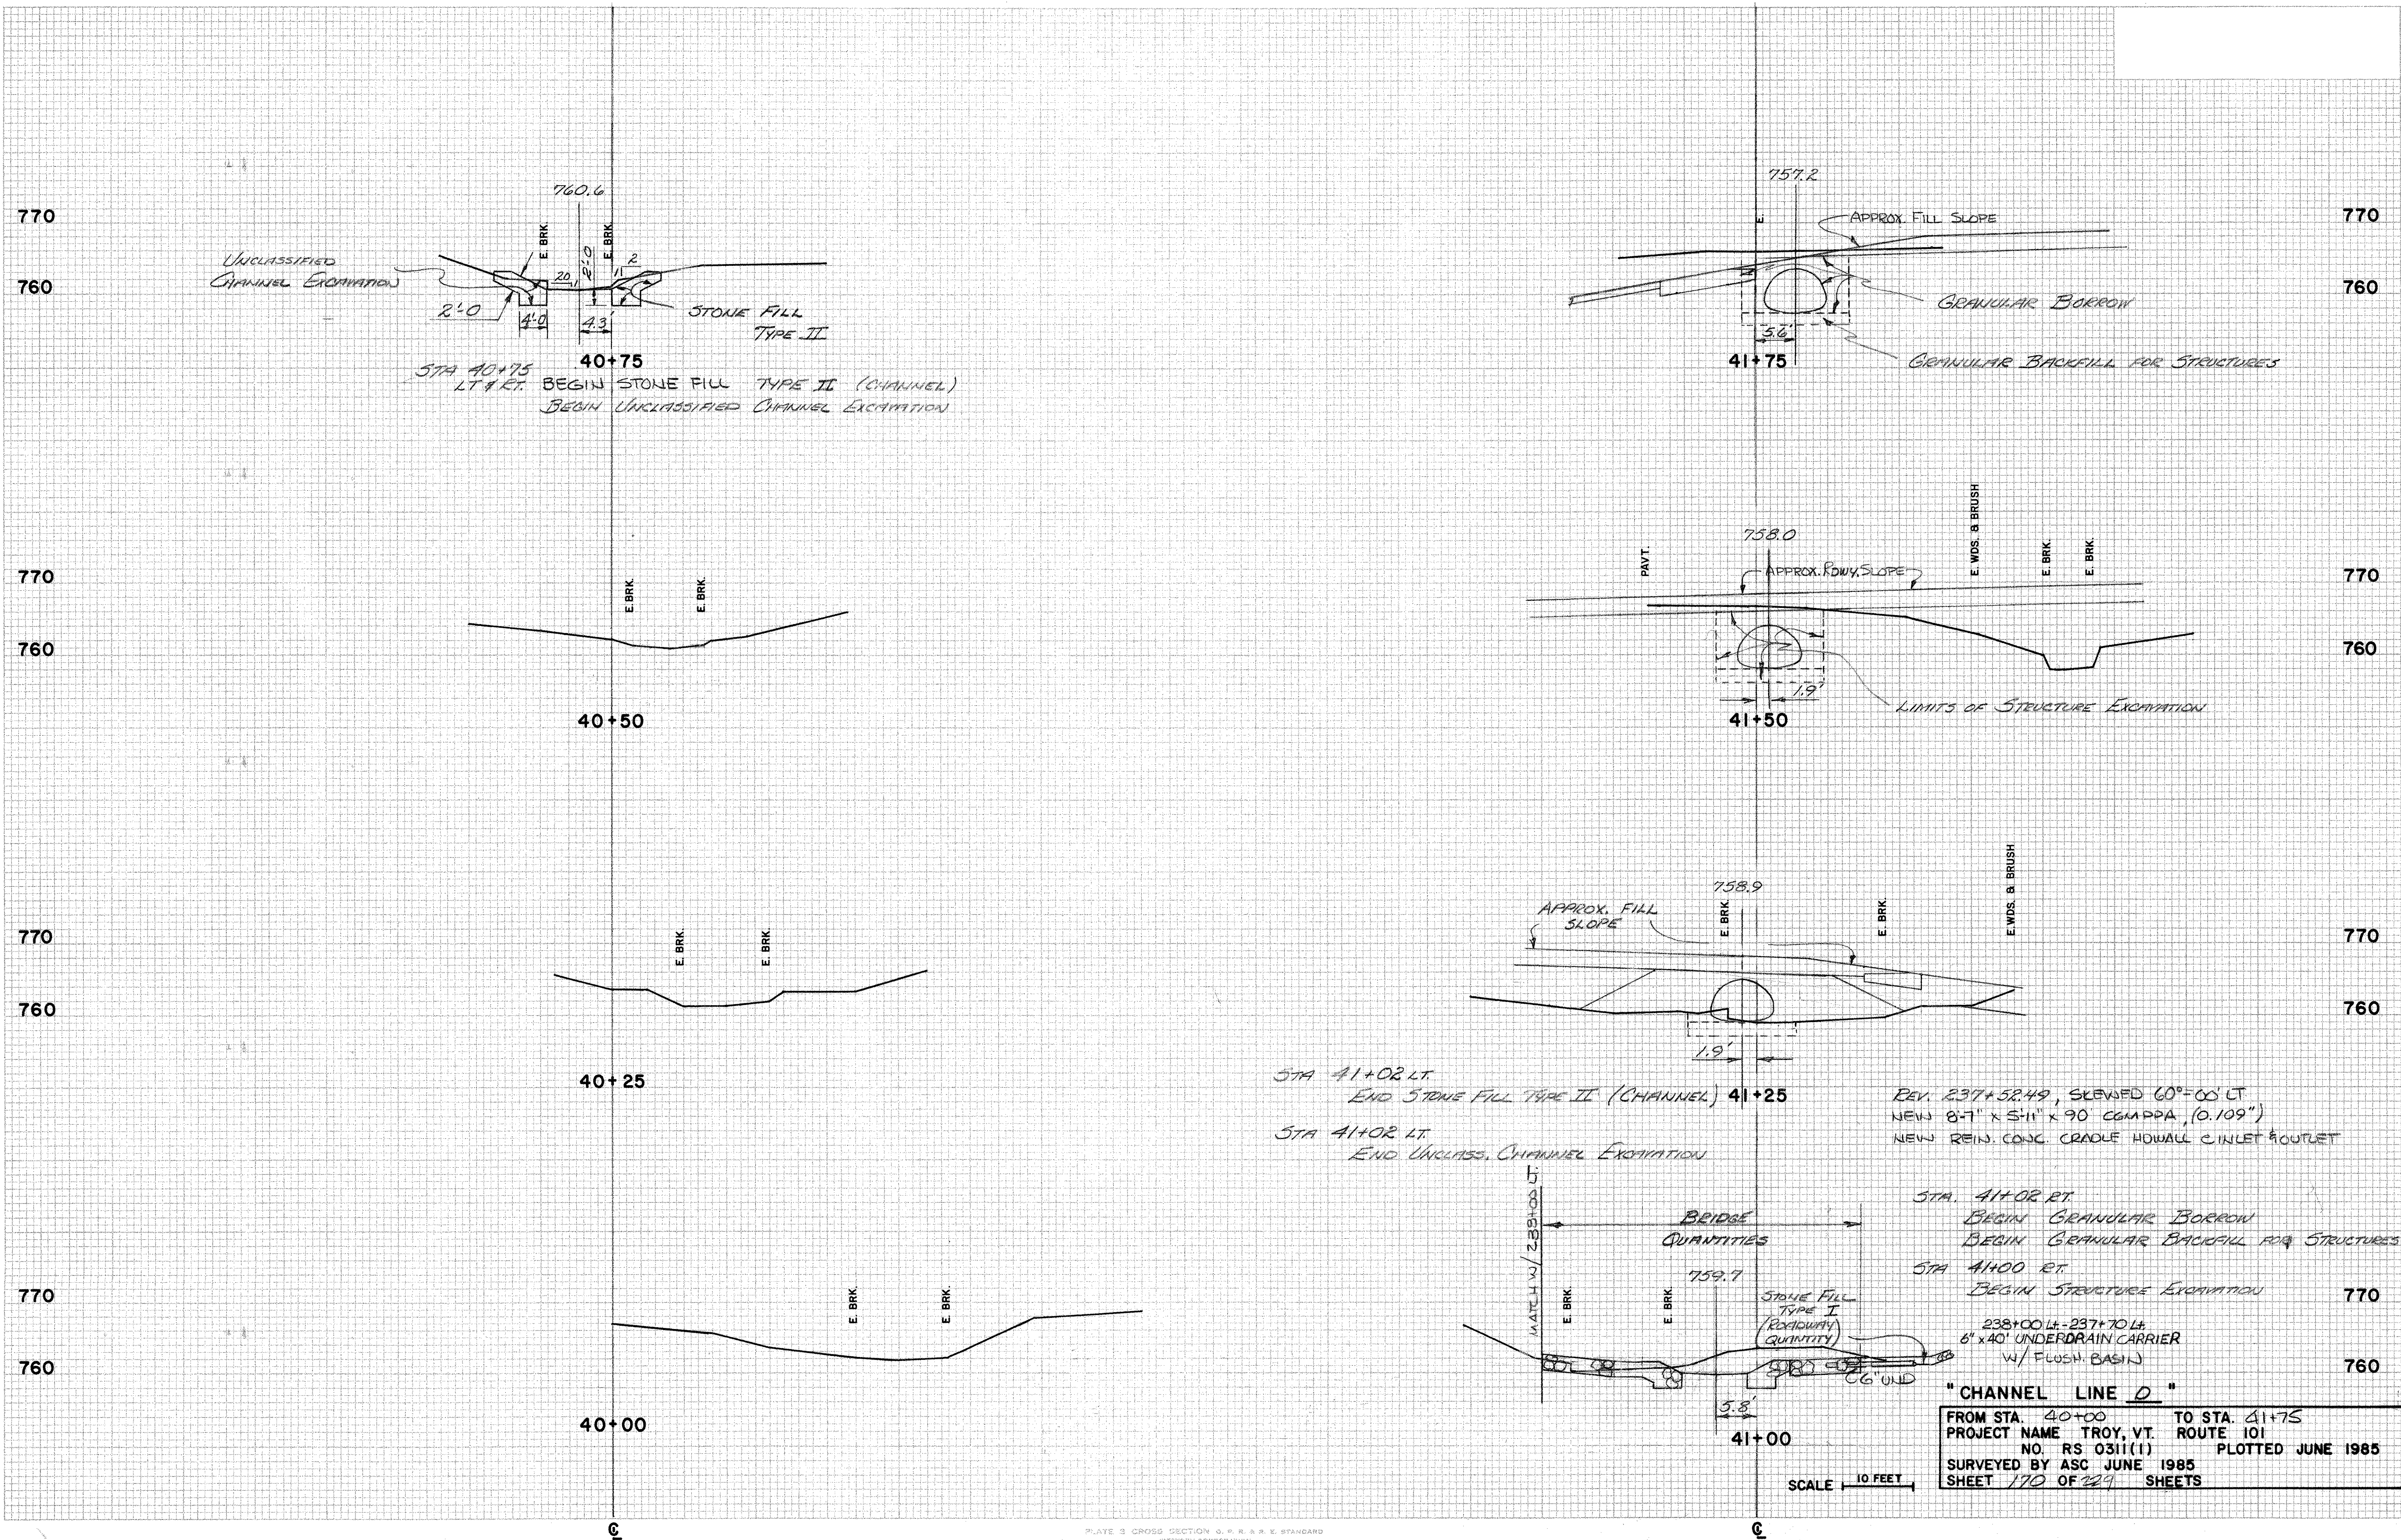

STA 40+75  
 LT & RT. BEGIN STONE FILL TYPE II (CHANNEL)  
 BEGIN UNCLASSIFIED CHANNEL EXCAVATION

STA 41+02 LT  
 END STONE FILL TYPE II (CHANNEL) 41+25  
 STA 41+02 RT  
 END UNCLASS. CHANNEL EXCAVATION

REV. 237+52.49, SKEWED 60°-00' LT  
 NEW 8'-7" x 51" x 90 CGAPPA (0.109")  
 NEW REIN. CONC CRADLE HOWALL C/INLET & OUTLET

STA 41+02 RT  
 BEGIN GRANULAR BORROW  
 BEGIN GRANULAR BACKFILL FOR STRUCTURES  
 STA 41+00 RT  
 BEGIN STRUCTURE EXCAVATION

238+00 LT - 237+70 LT  
 6' x 40' UNDERDRAIN CARRIER  
 W/ FLOSH BASIN

**"CHANNEL LINE D"**  
 FROM STA. 40+00 TO STA. 41+75  
 PROJECT NAME TROY, VT. ROUTE 101  
 NO. RS 0311(1) PLOTTED JUNE 1985  
 SURVEYED BY ASC JUNE 1985  
 SHEET 170 OF 229 SHEETS