


DATE	
BY	
PROJECT	
NOTE BOOK	
NO.	

DATE	
BY	
PROJECT	
NOTE BOOK	
NO.	

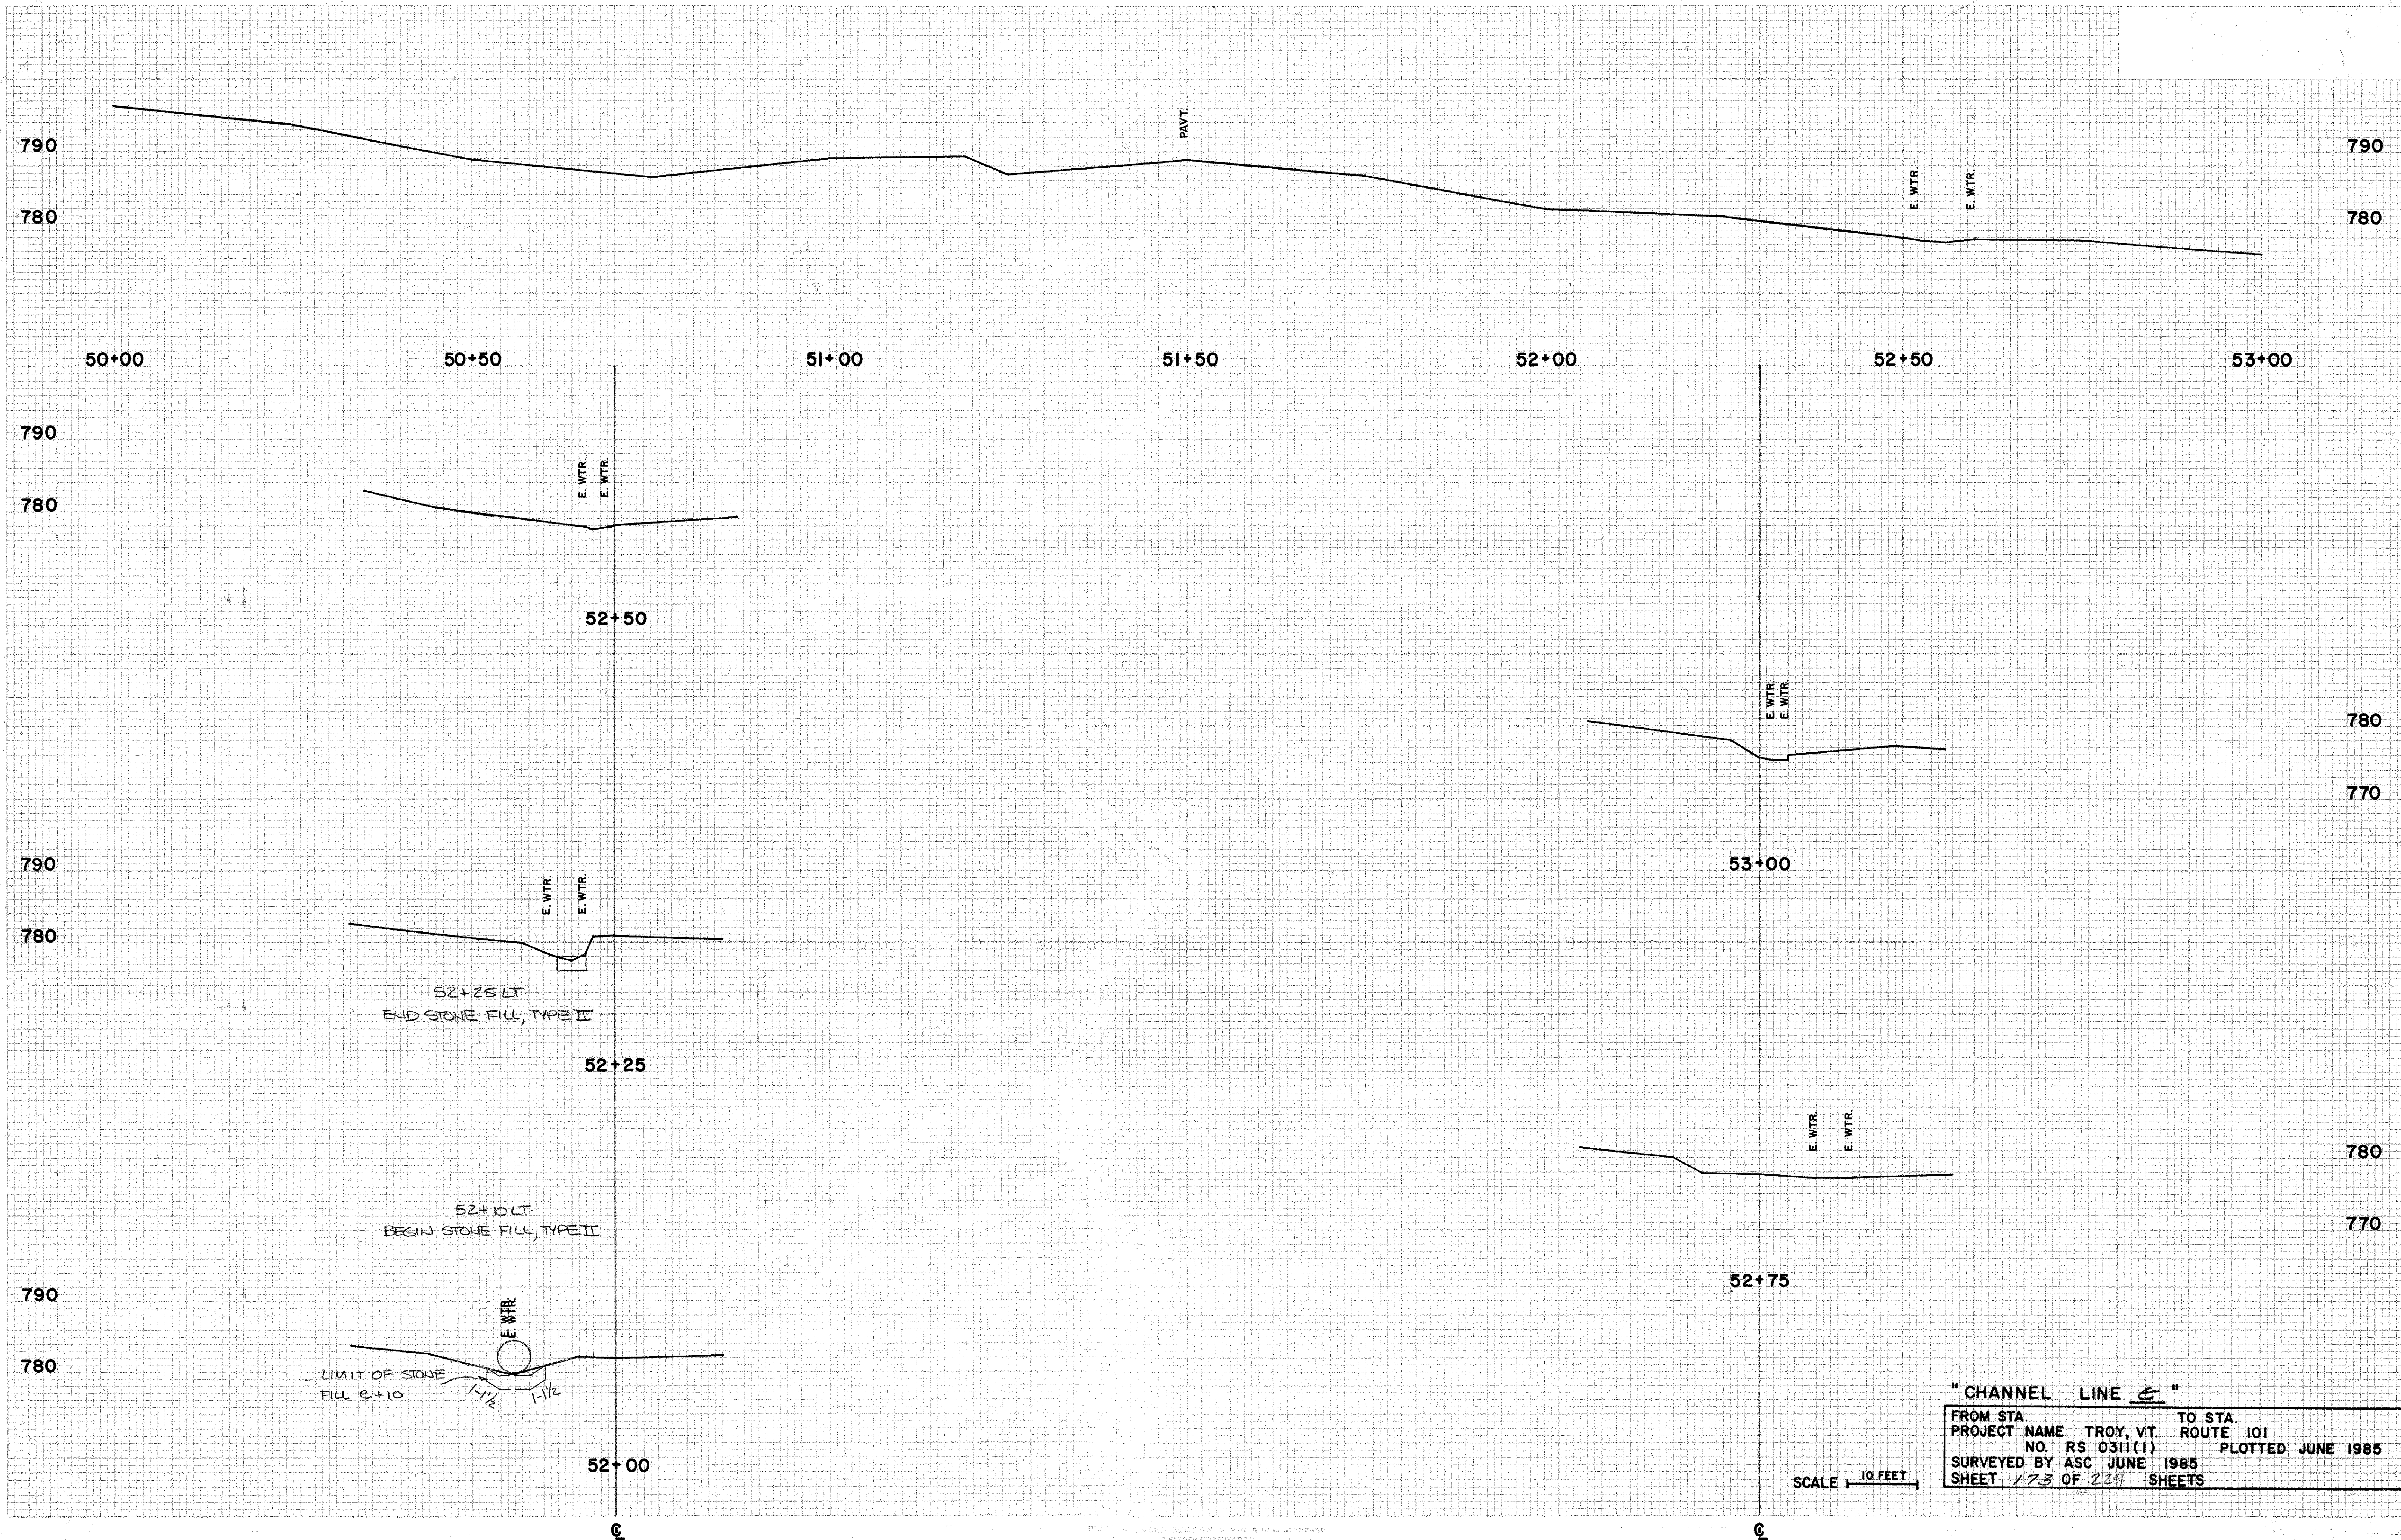

"CHANNEL LINE E"
 FROM STA. TO STA.
 PROJECT NAME TROY, VT. ROUTE 101
 NO. RS 0311(1) PLOTTED JUNE 1985
 SURVEYED BY ASC JUNE 1985
 SHEET 173 OF 239 SHEETS

SCALE 10 FEET