


FINAL SURVEY NOTE BOOK No. \_\_\_\_\_  
 SURVEYED BY \_\_\_\_\_ DATE \_\_\_\_\_  
 PLOTTED BY \_\_\_\_\_  
 AREA CHECKED \_\_\_\_\_

ORIGINAL SURVEY NOTE BOOK No. \_\_\_\_\_  
 SURVEYED BY \_\_\_\_\_ DATE \_\_\_\_\_  
 PLOTTED BY \_\_\_\_\_  
 AREA CHECKED \_\_\_\_\_

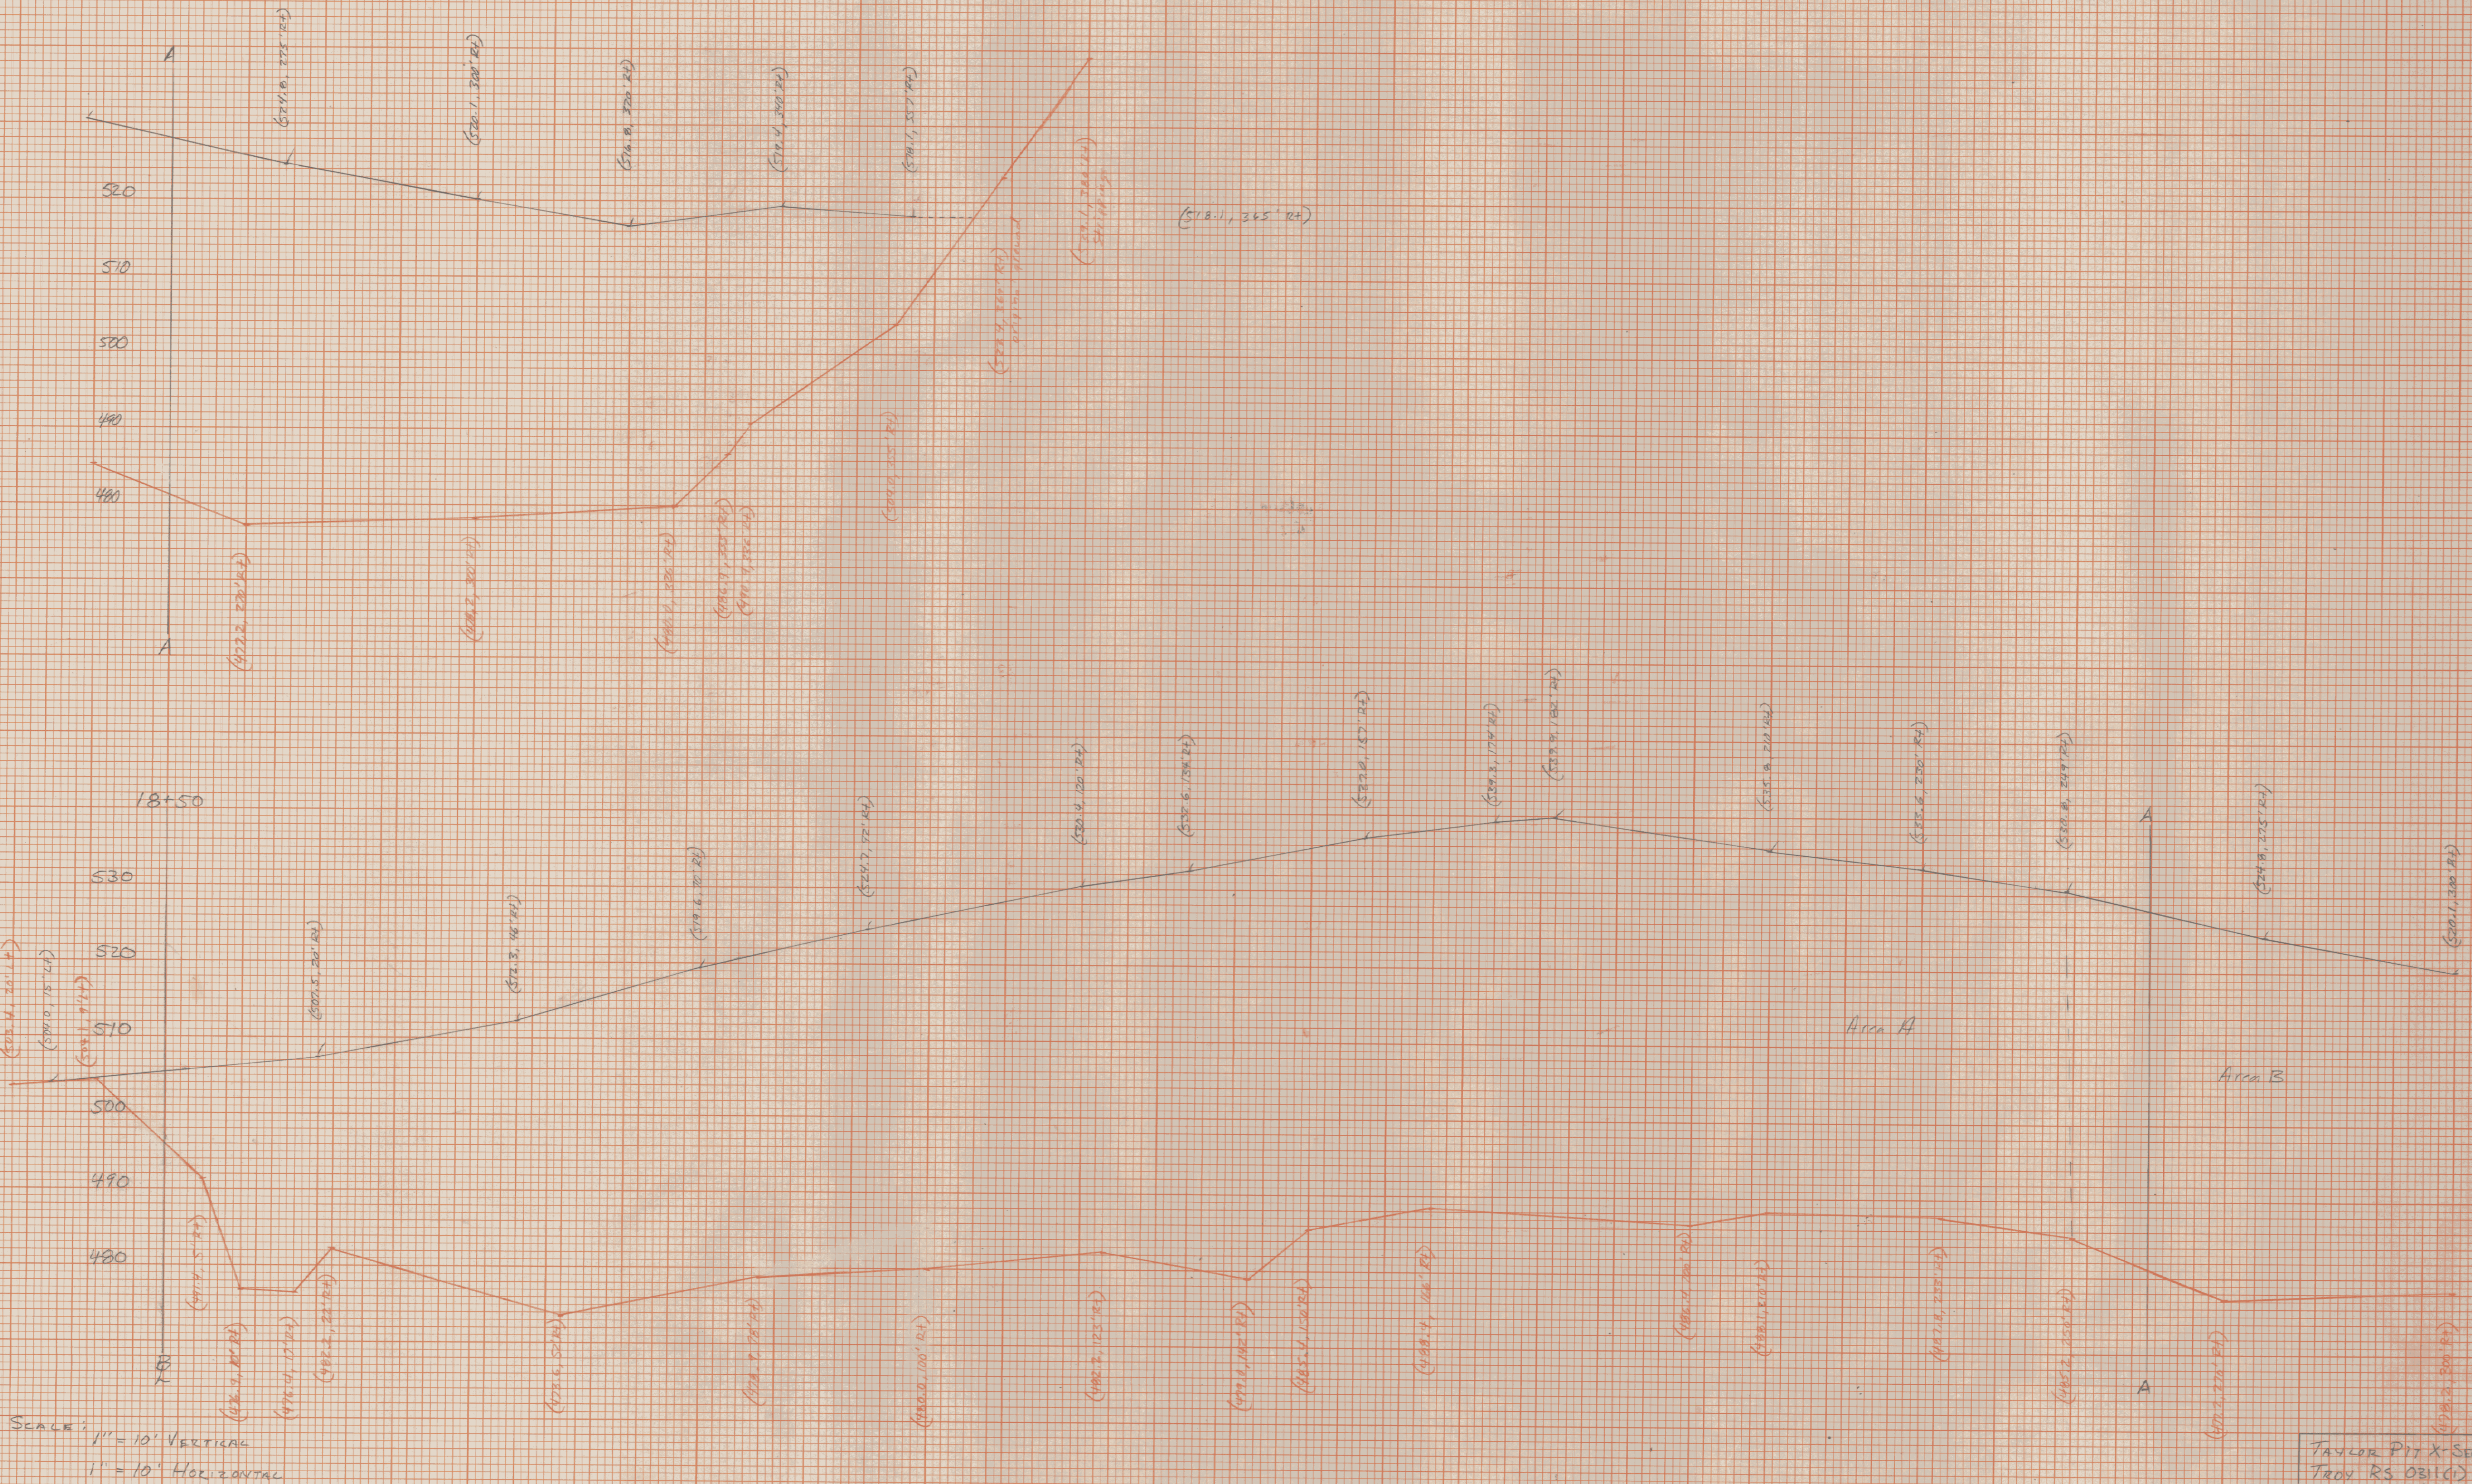

Scale: 1" = 10' Vertical  
 1" = 10' Horizontal

Taylor Pit X-Sections  
 Troy RS 031(C)  
 SHEET # 5 of 13  
 S.G.N. 8-20-71