
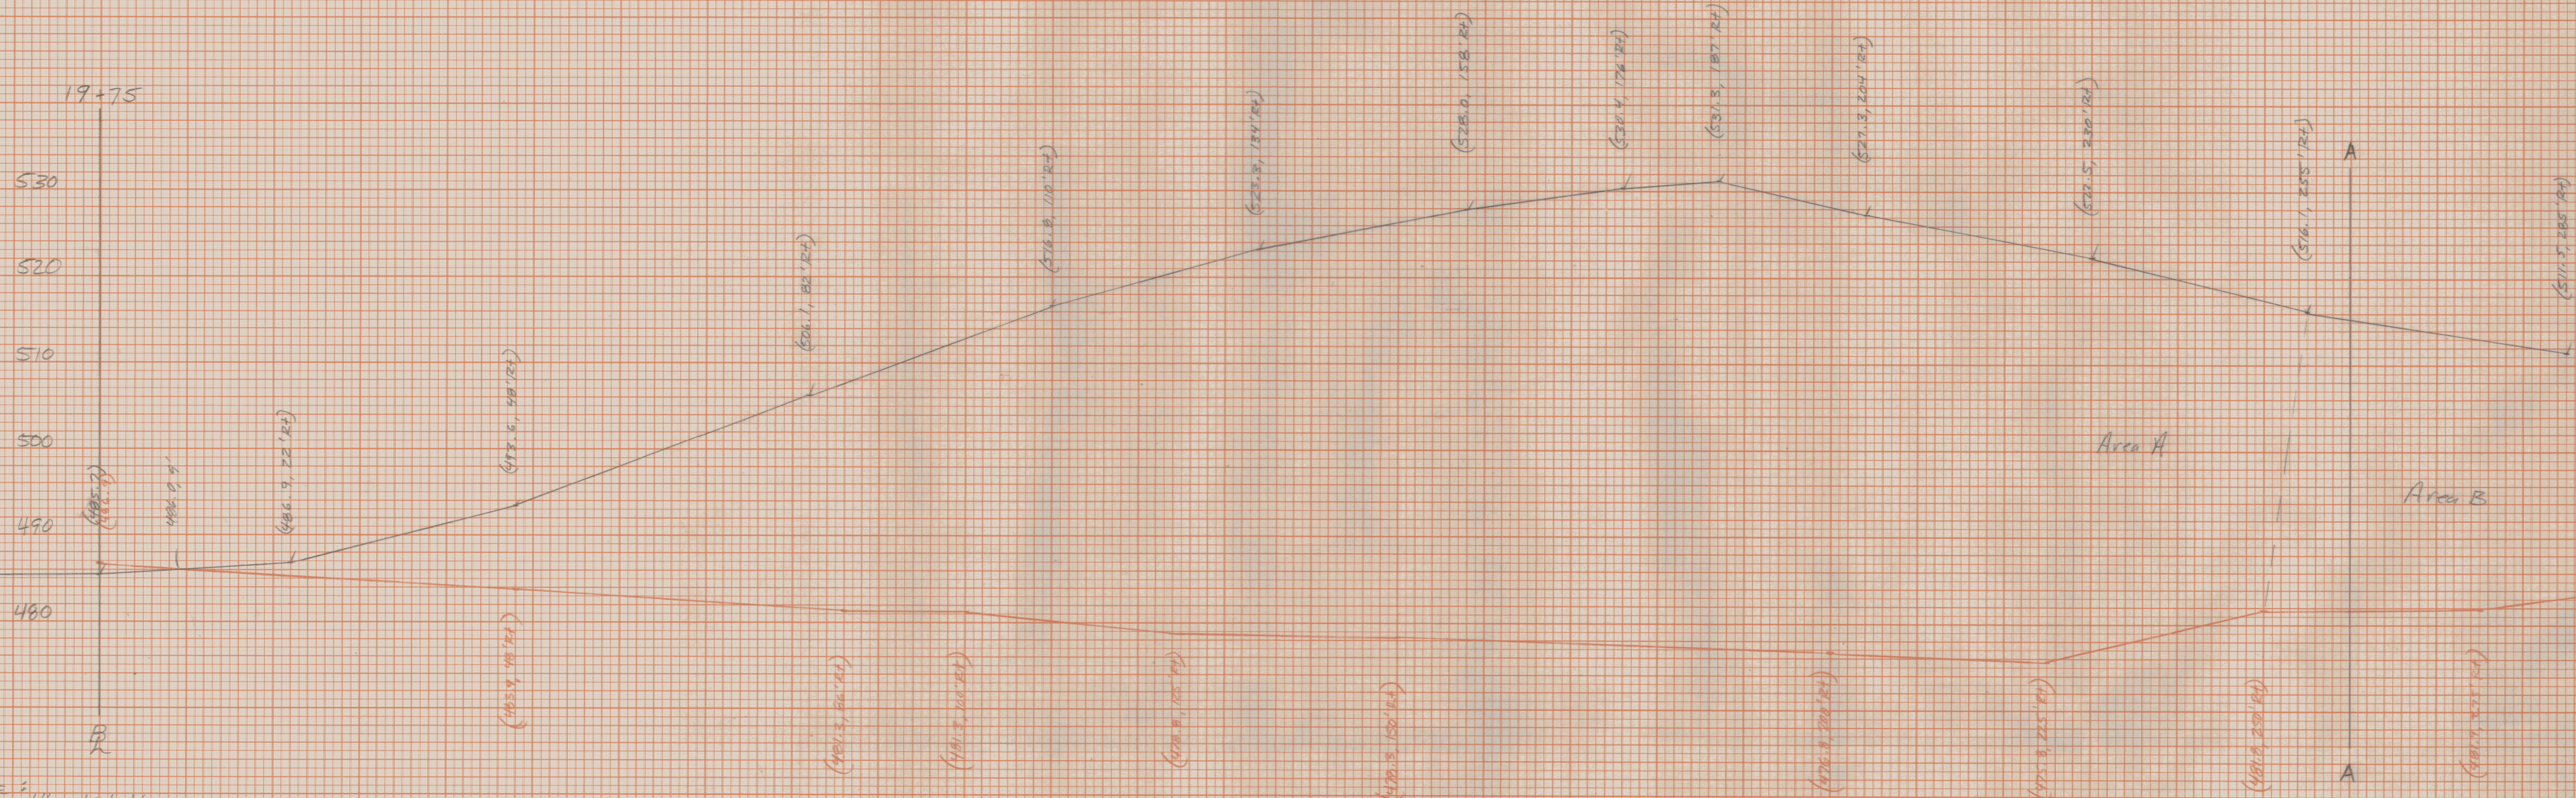


DATE	
BY	
REGISTERED SURVEYOR	
STATE	
PROJECT	
AREA	
FIELD CHECKED	
NO.	

DATE	
BY	
BUREAU	
TEMPERATURE	
AREA	
FIELD CHECKED	
NO.	

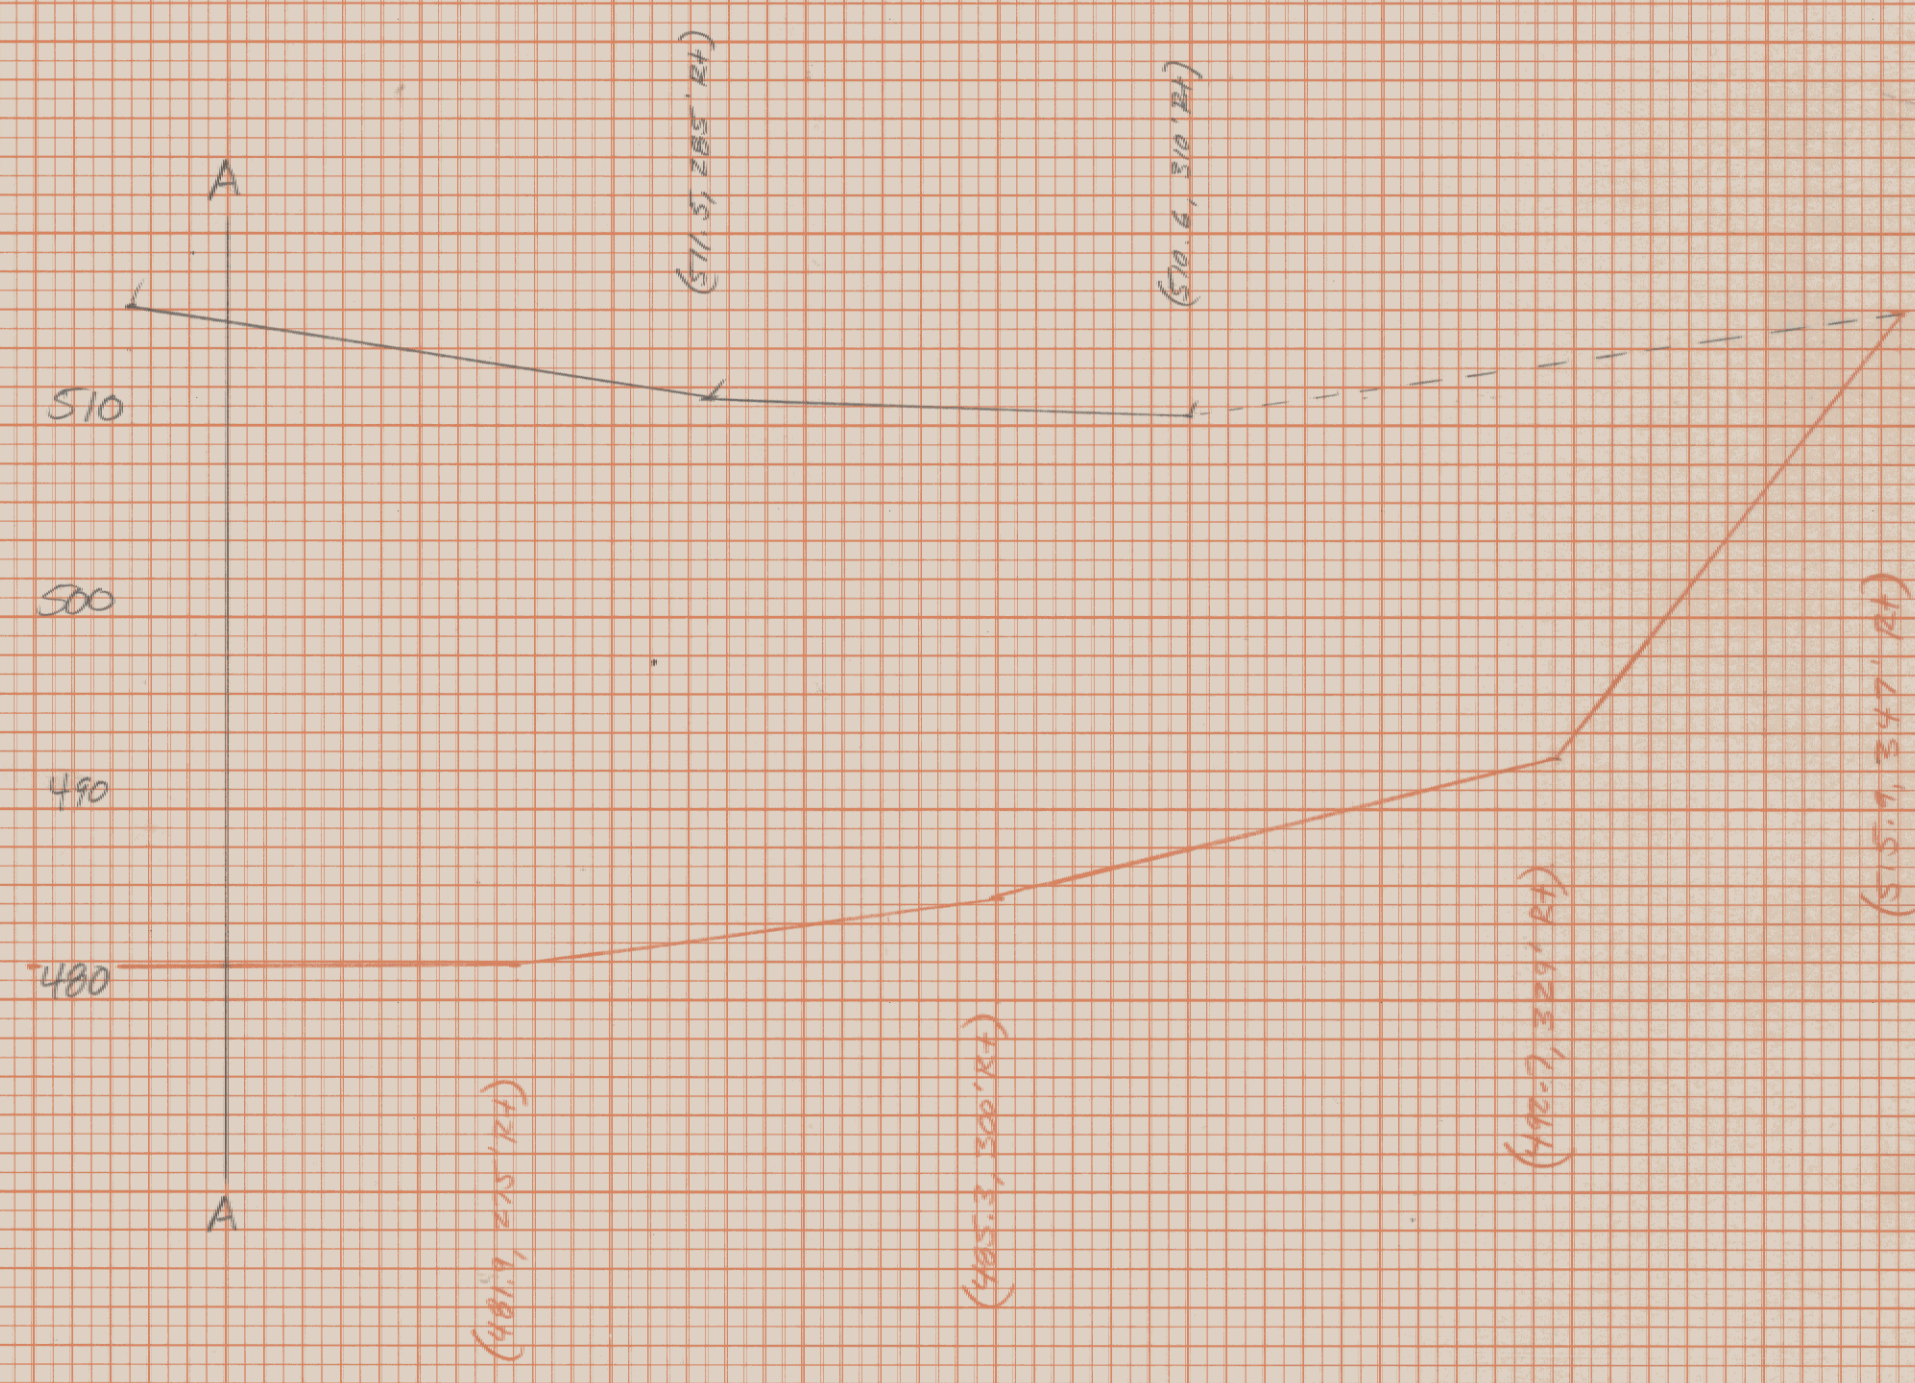

SCALE: 1" = 10' VERTICAL
1" = 10' HORIZONTAL

TAYLOR PIT X-SECTIONS
TRAY RS 0311(4)
SHEET # 10 of 13
S. C. N.
8'22.71