


DATE	
BY	
BURNED	
PLATTED	
TEMPLATE	
AREA	
AREAS CHECKED	
FINAL SURVEY NOTE BOOK NO.	

DATE	
BY	
BURNED	
PLATTED	
TEMPLATE	
AREA	
AREAS CHECKED	
ORIGINAL SURVEY NOTE BOOK NO.	

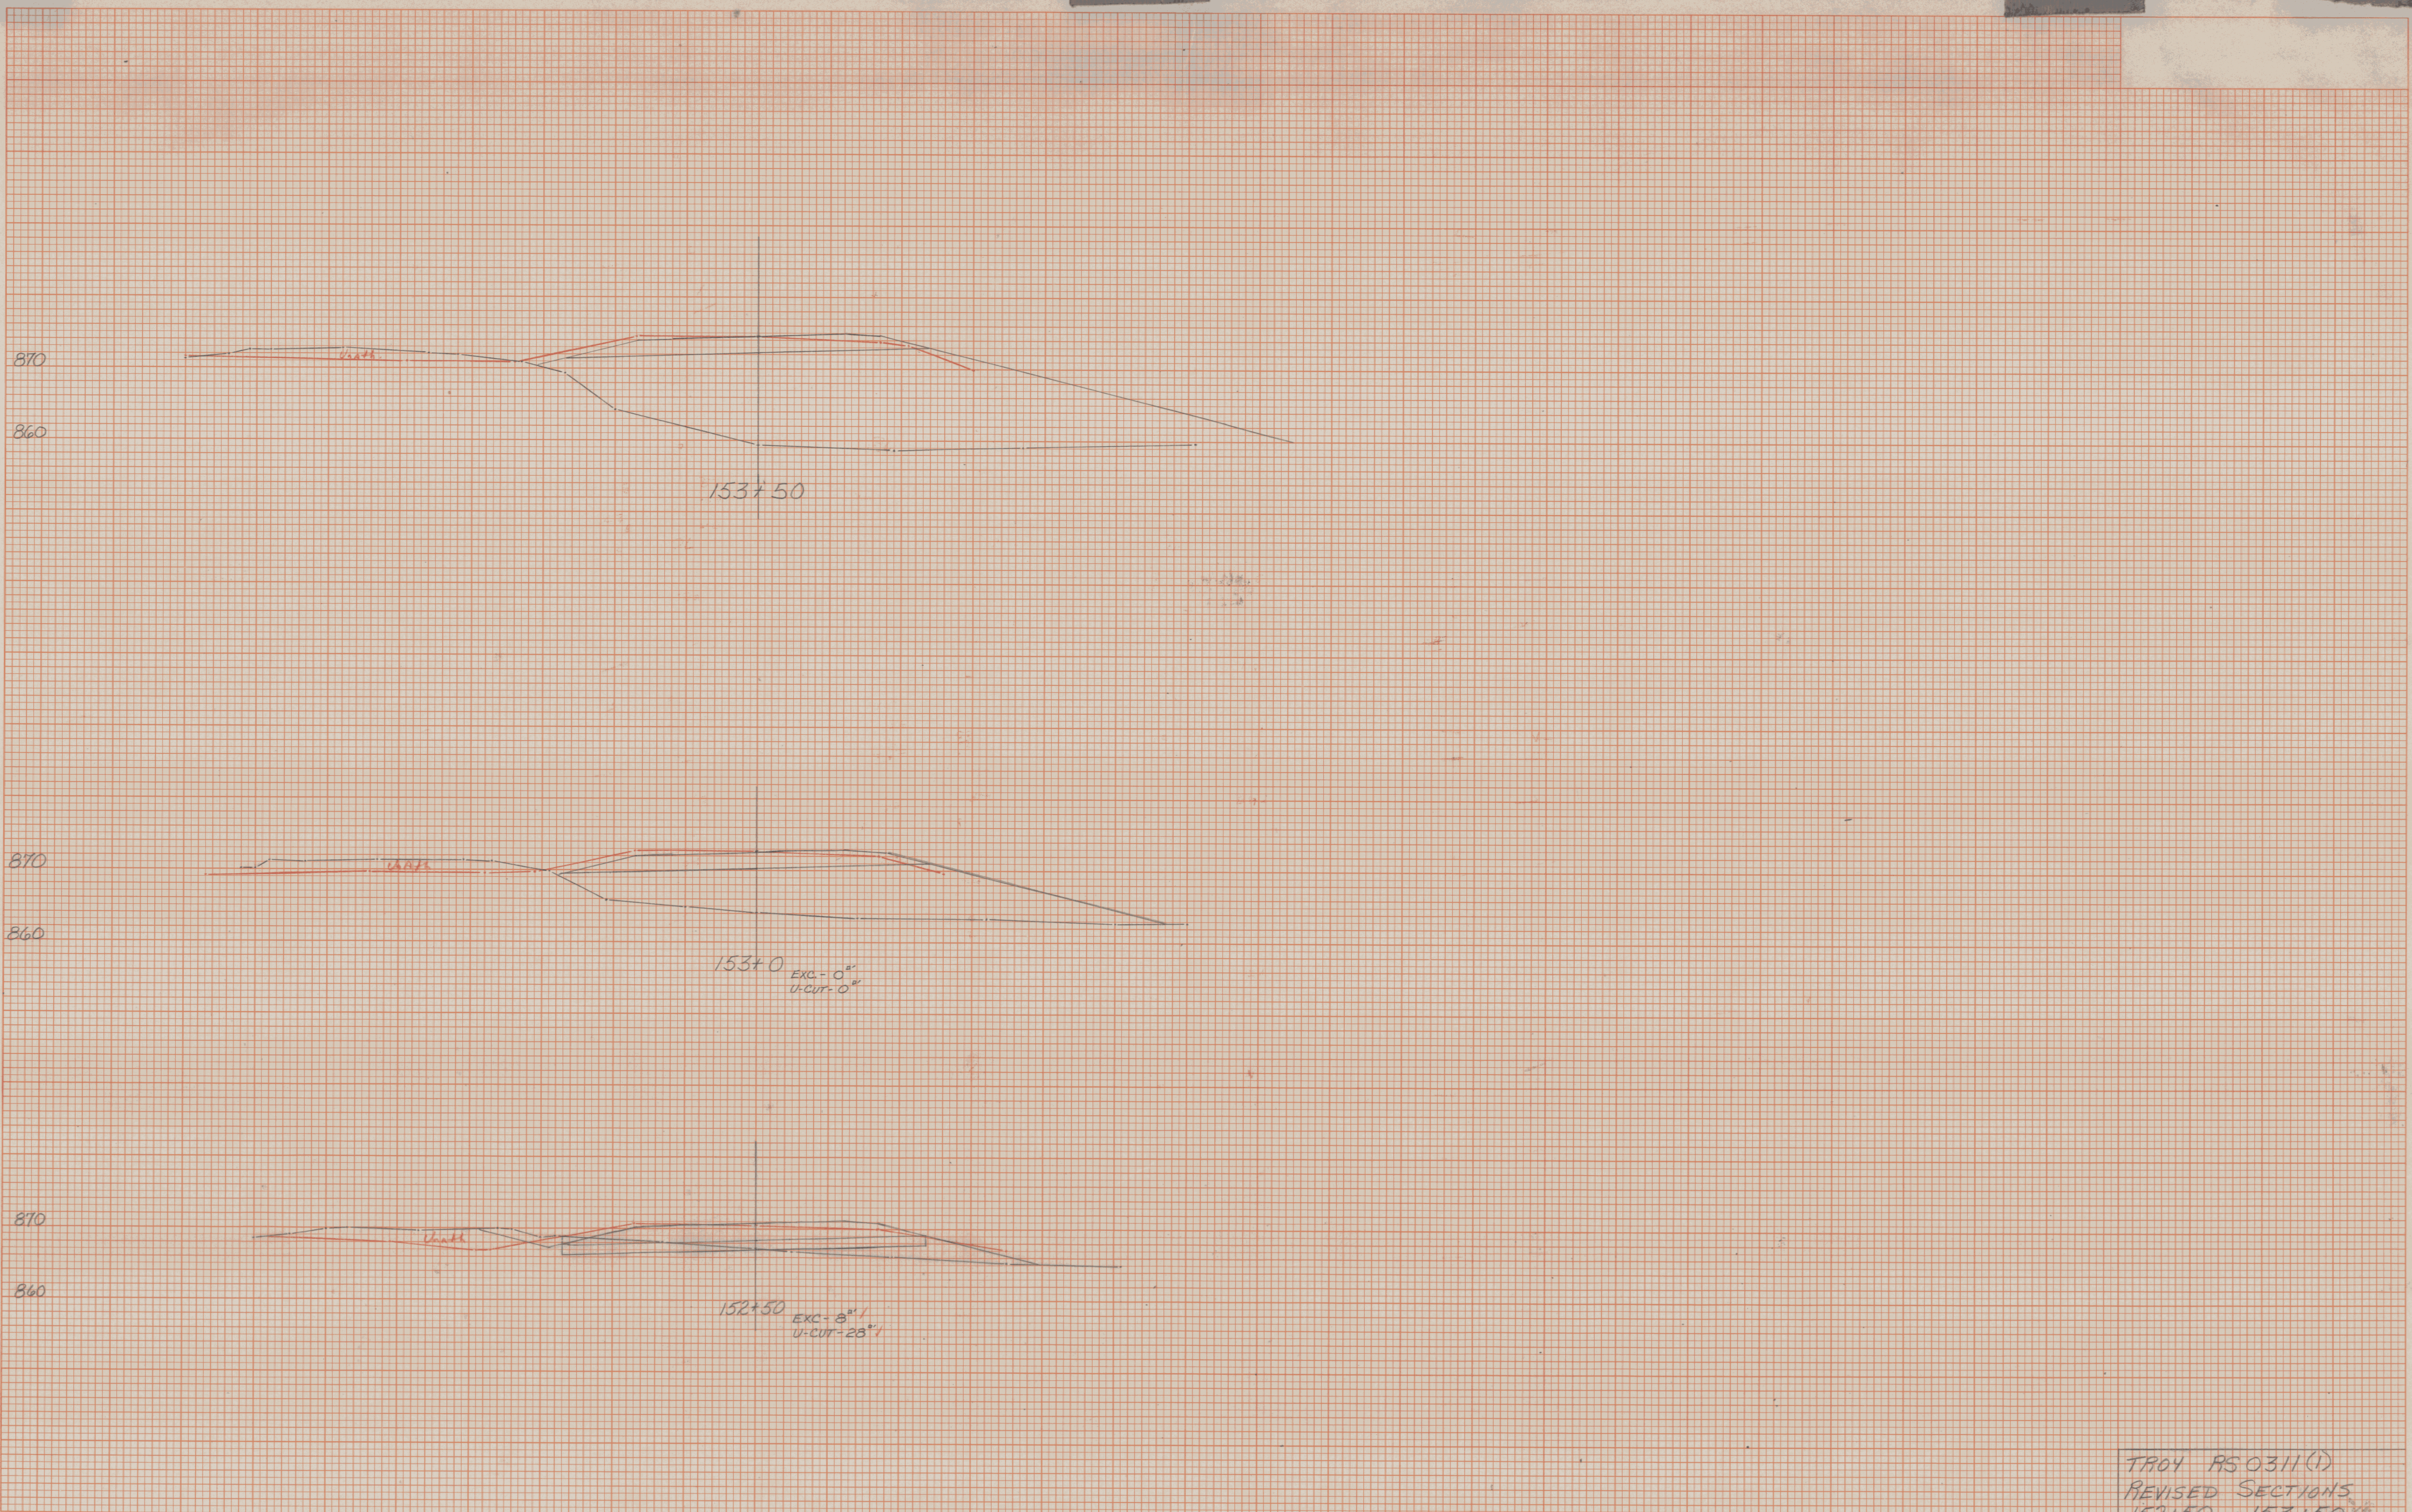

PARAMETERED 1-10-92 JEM

PLATE 3 CROSS SECTION O. P. & R. E. STANDARD
DETROIT CORPORATION

12-16-91 TMM L03

TROY R50311(1)
REVISED SECTIONS
152+50 ~ 153+50

SHEET 2 of 18
272 2/12