


DATE	
BY	
REVISIONS	
PLOTTED	
TEMPERATURE	
AREA CHECKED	
FINAL SURVEY NOTE BOOK No.	

DATE	
BY	
REVISIONS	
PLOTTED	
TEMPERATURE	
AREA CHECKED	
ORIGINAL SURVEY NOTE BOOK No.	

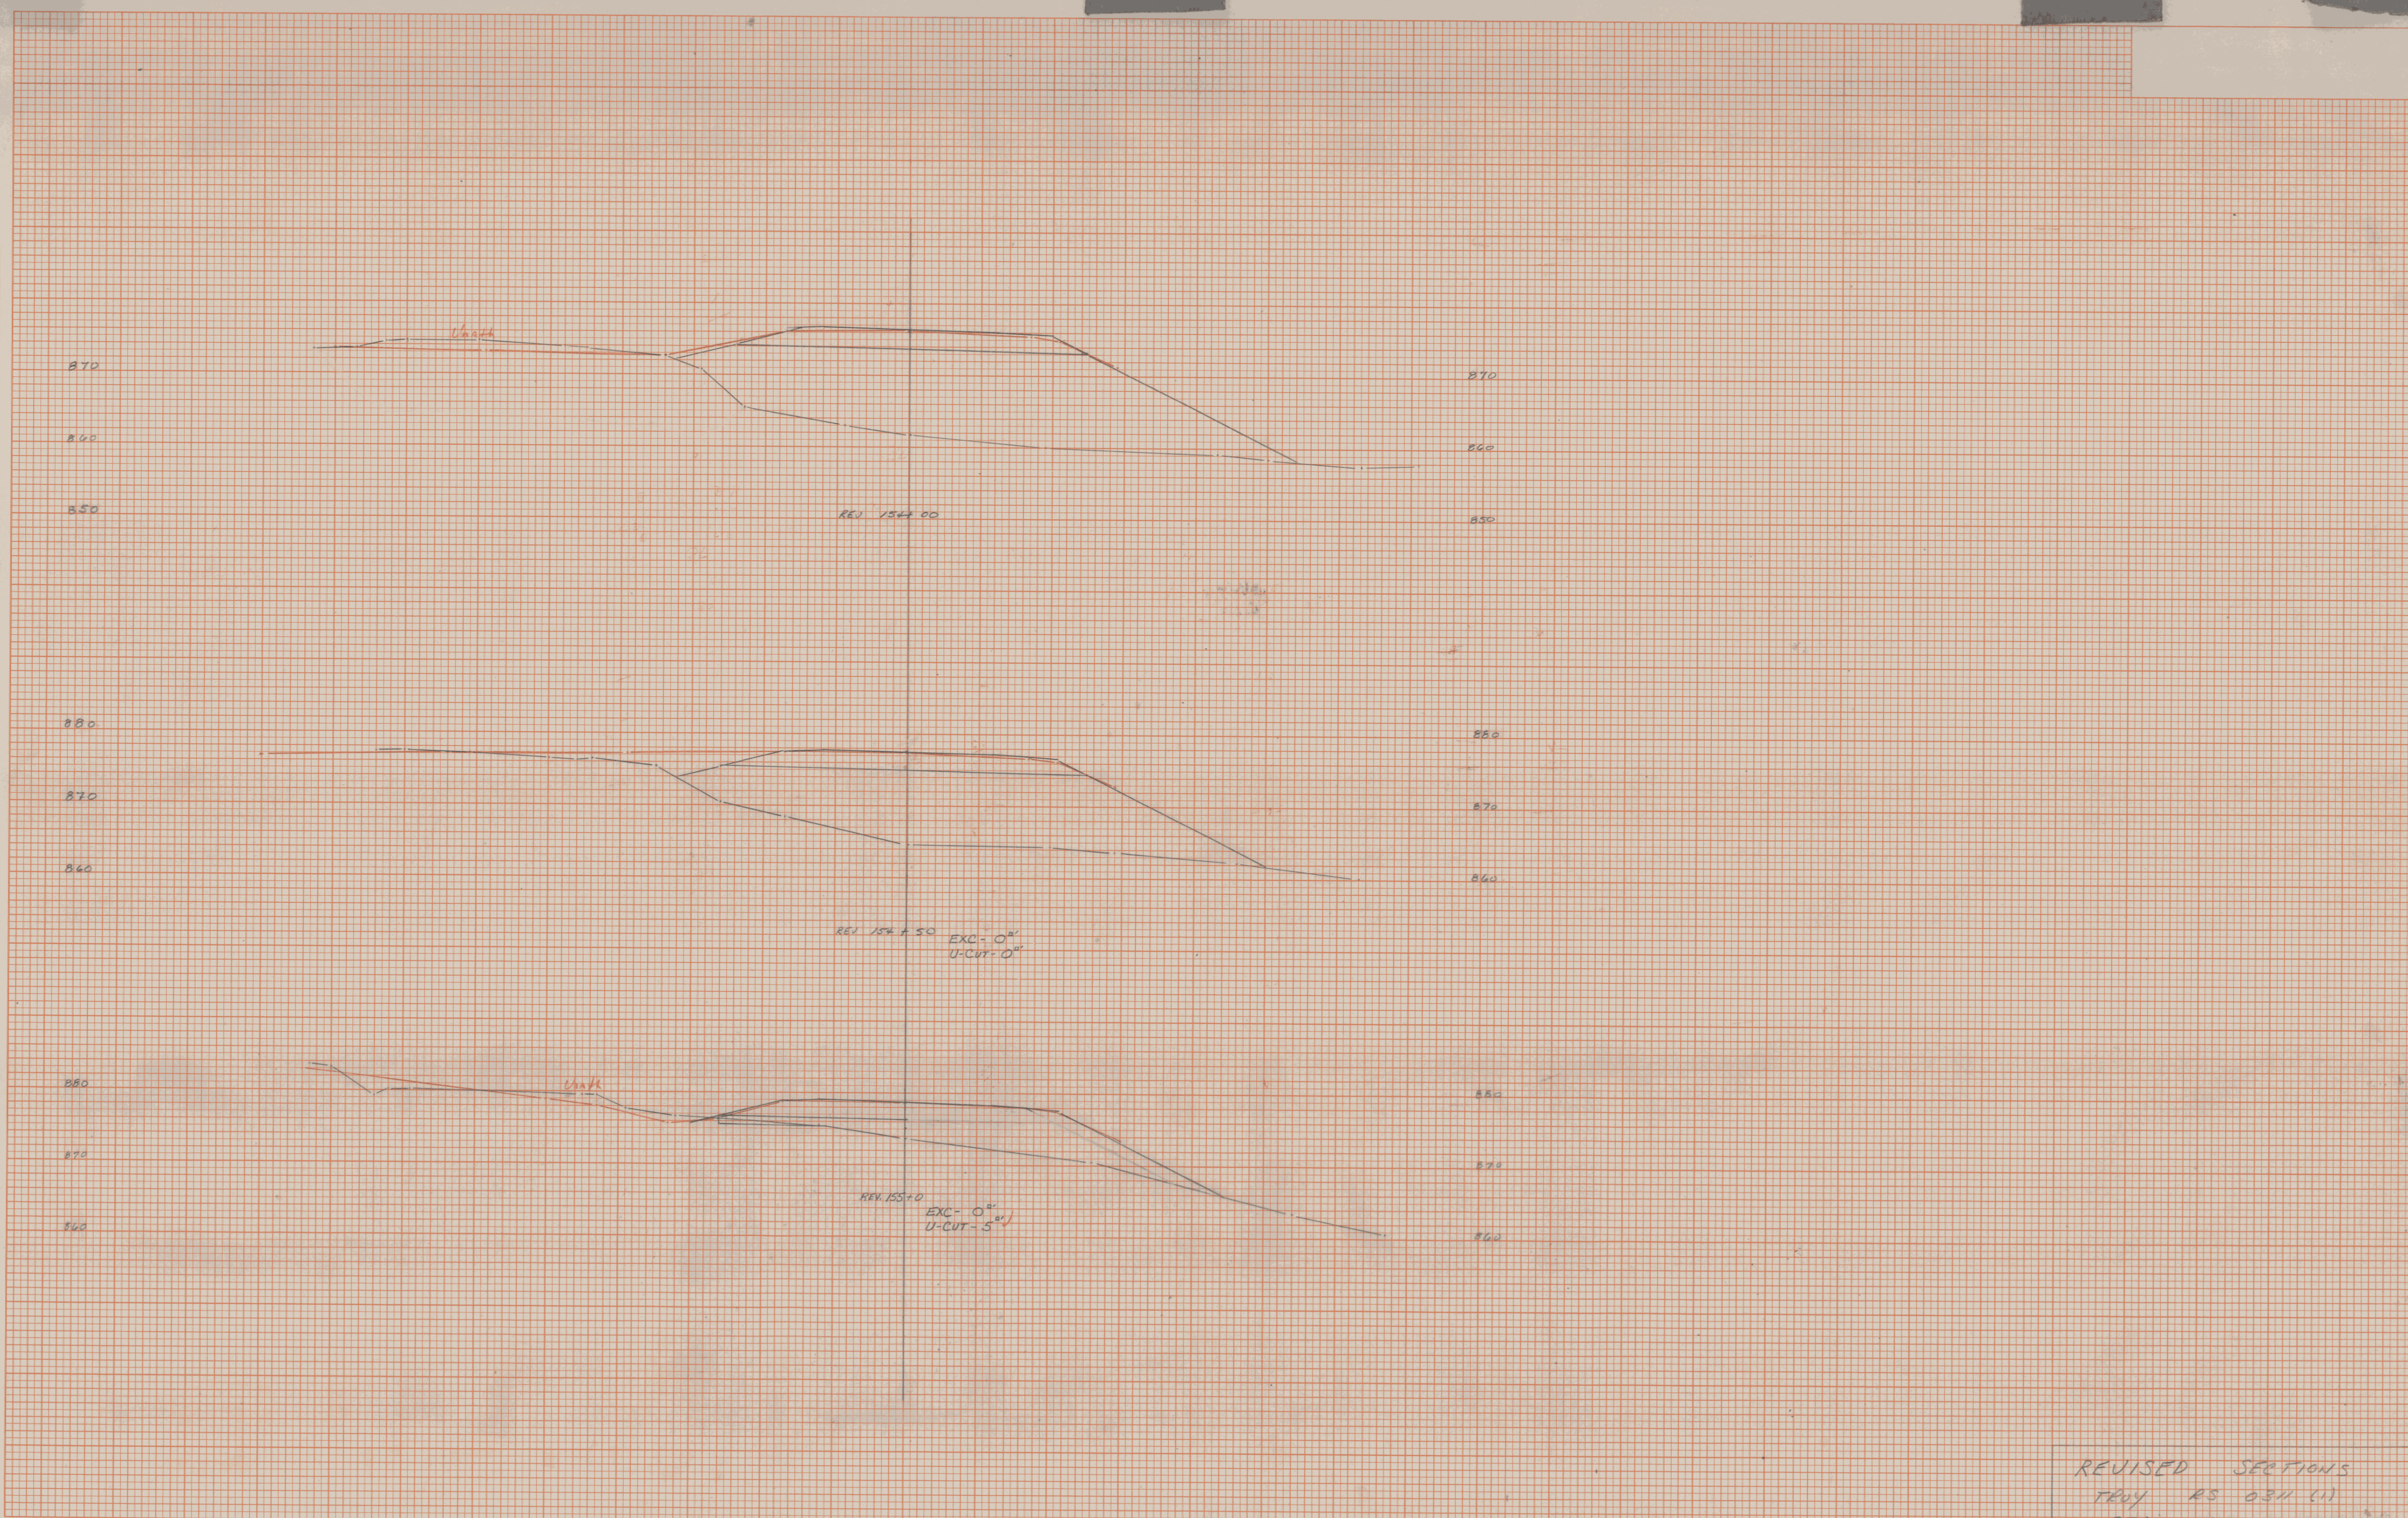

REVISED SECTIONS  
 TRAY RS 0311 (1)  
 STA 154+0 ~ 155+0  
 SHEET 30F18  
 ZTS/AVAS