

DATE
BY
SUPERVISOR
FINAL SURVEY NOTE BOOK No. []
SURVEYED
TEMPLATE
AREAS
AREAS CHECKED

DATE
BY
SUPERVISOR
ORIGINAL SURVEY NOTE BOOK No. []
SURVEYED
TEMPLATE
AREAS
AREAS CHECKED

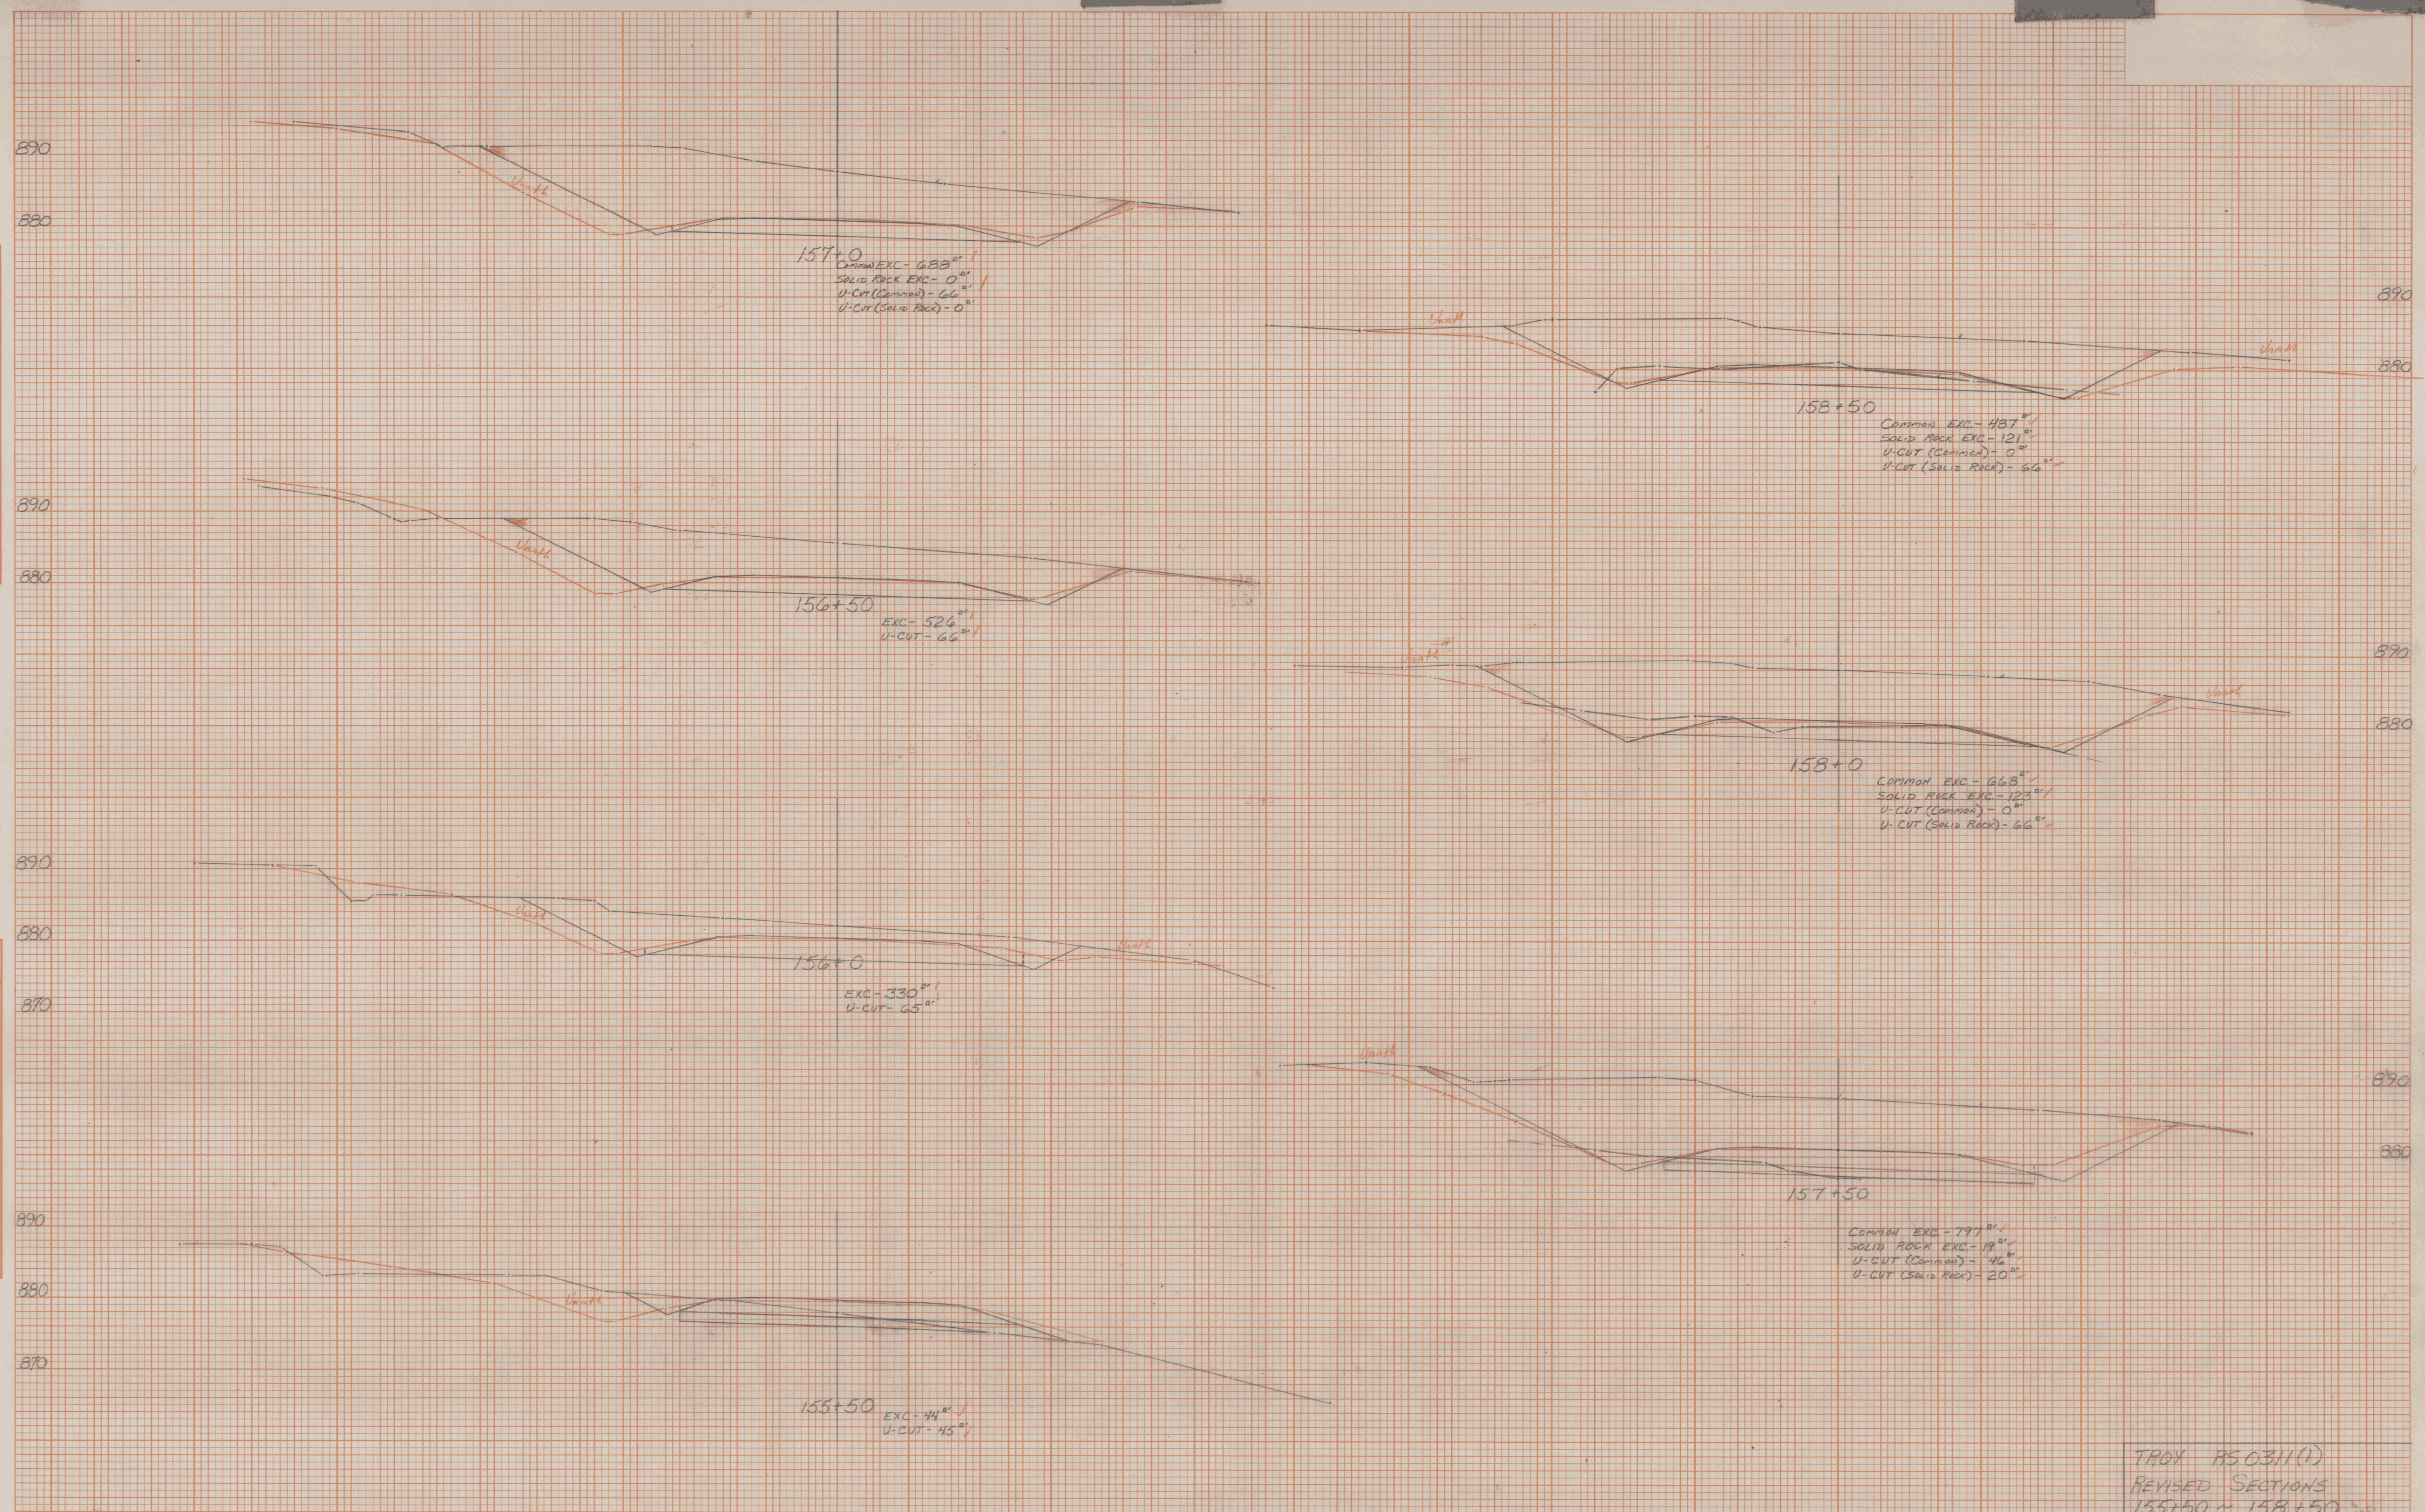


PLATE 3 CROSS SECTION O.P.R. & R.E. STANDARD
 DIETZGEN CORPORATION

TR-4 12-2-91 405
 PLOTTED 12-16-91 JSM
 REVISIONS 1-13-92 JSM

TROY RS0311(1)
 REVISED SECTIONS
 155+50 ~ 158+50
 SHEET 4 OF 18
 TEMPLATED 12-16-91 JSM
 PLOTTED 12-16-91 JSM
 2746VX5