


DATE
BY
SURVEYED
PLOTTED
TRIALS
AREAS CHECKED
FINAL SURVEY NOTE BOOK No.

DATE
BY
SURVEYED
PLOTTED
TRIALS
AREAS CHECKED
ORIGINAL SURVEY NOTE BOOK No.

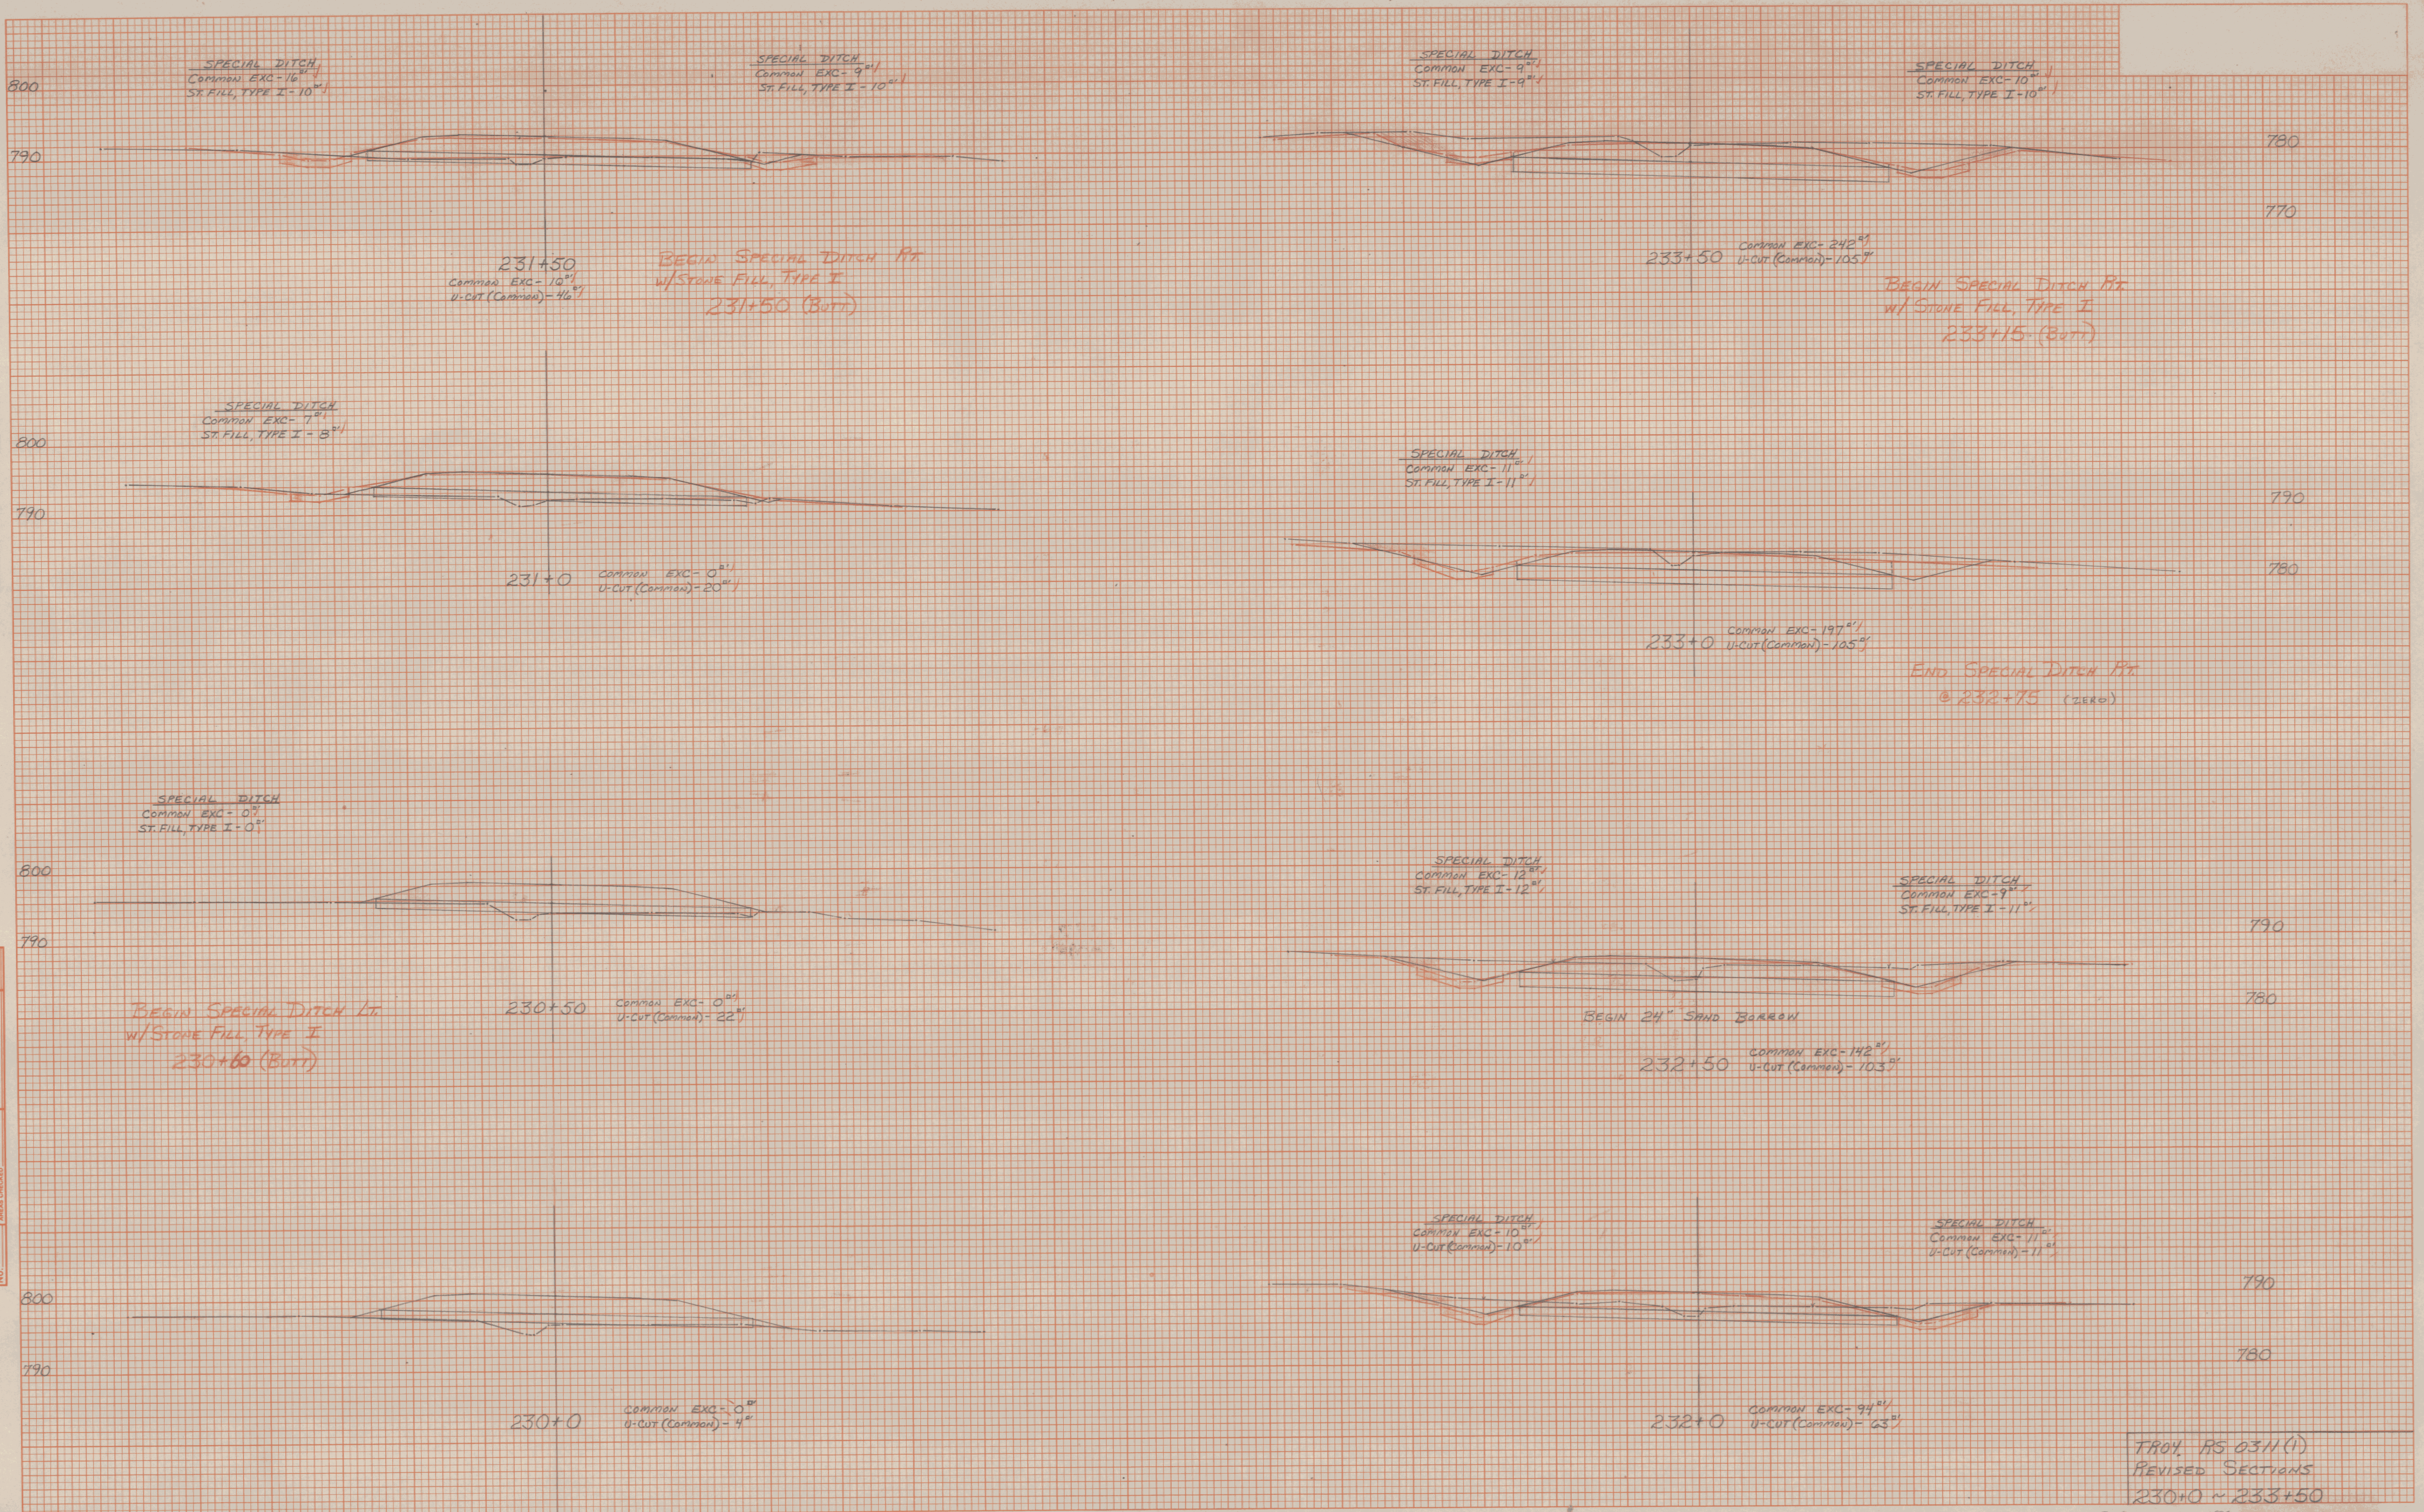

TROY, RS 0311(1)
REVISED SECTIONS
230+0 TO 233+50

TEMPERED 12-16-91 XEM
PLOTTER 12-17-91 XEM
PARAMETERED 1-22-92
SHEET 7 OF 18
CITREX

PLATE & CROSS SECTION P. R. & E. STANDARD