


DATE	
BY	
REVIEWED	
PLOTTED	
TEMPLATE	
AREAS CHECKED	
FINAL SURVEY NOTE BOOK No.	

DATE	
BY	
REVIEWED	
PLOTTED	
TEMPLATE	
AREAS CHECKED	
ORIGINAL SURVEY NOTE BOOK No.	

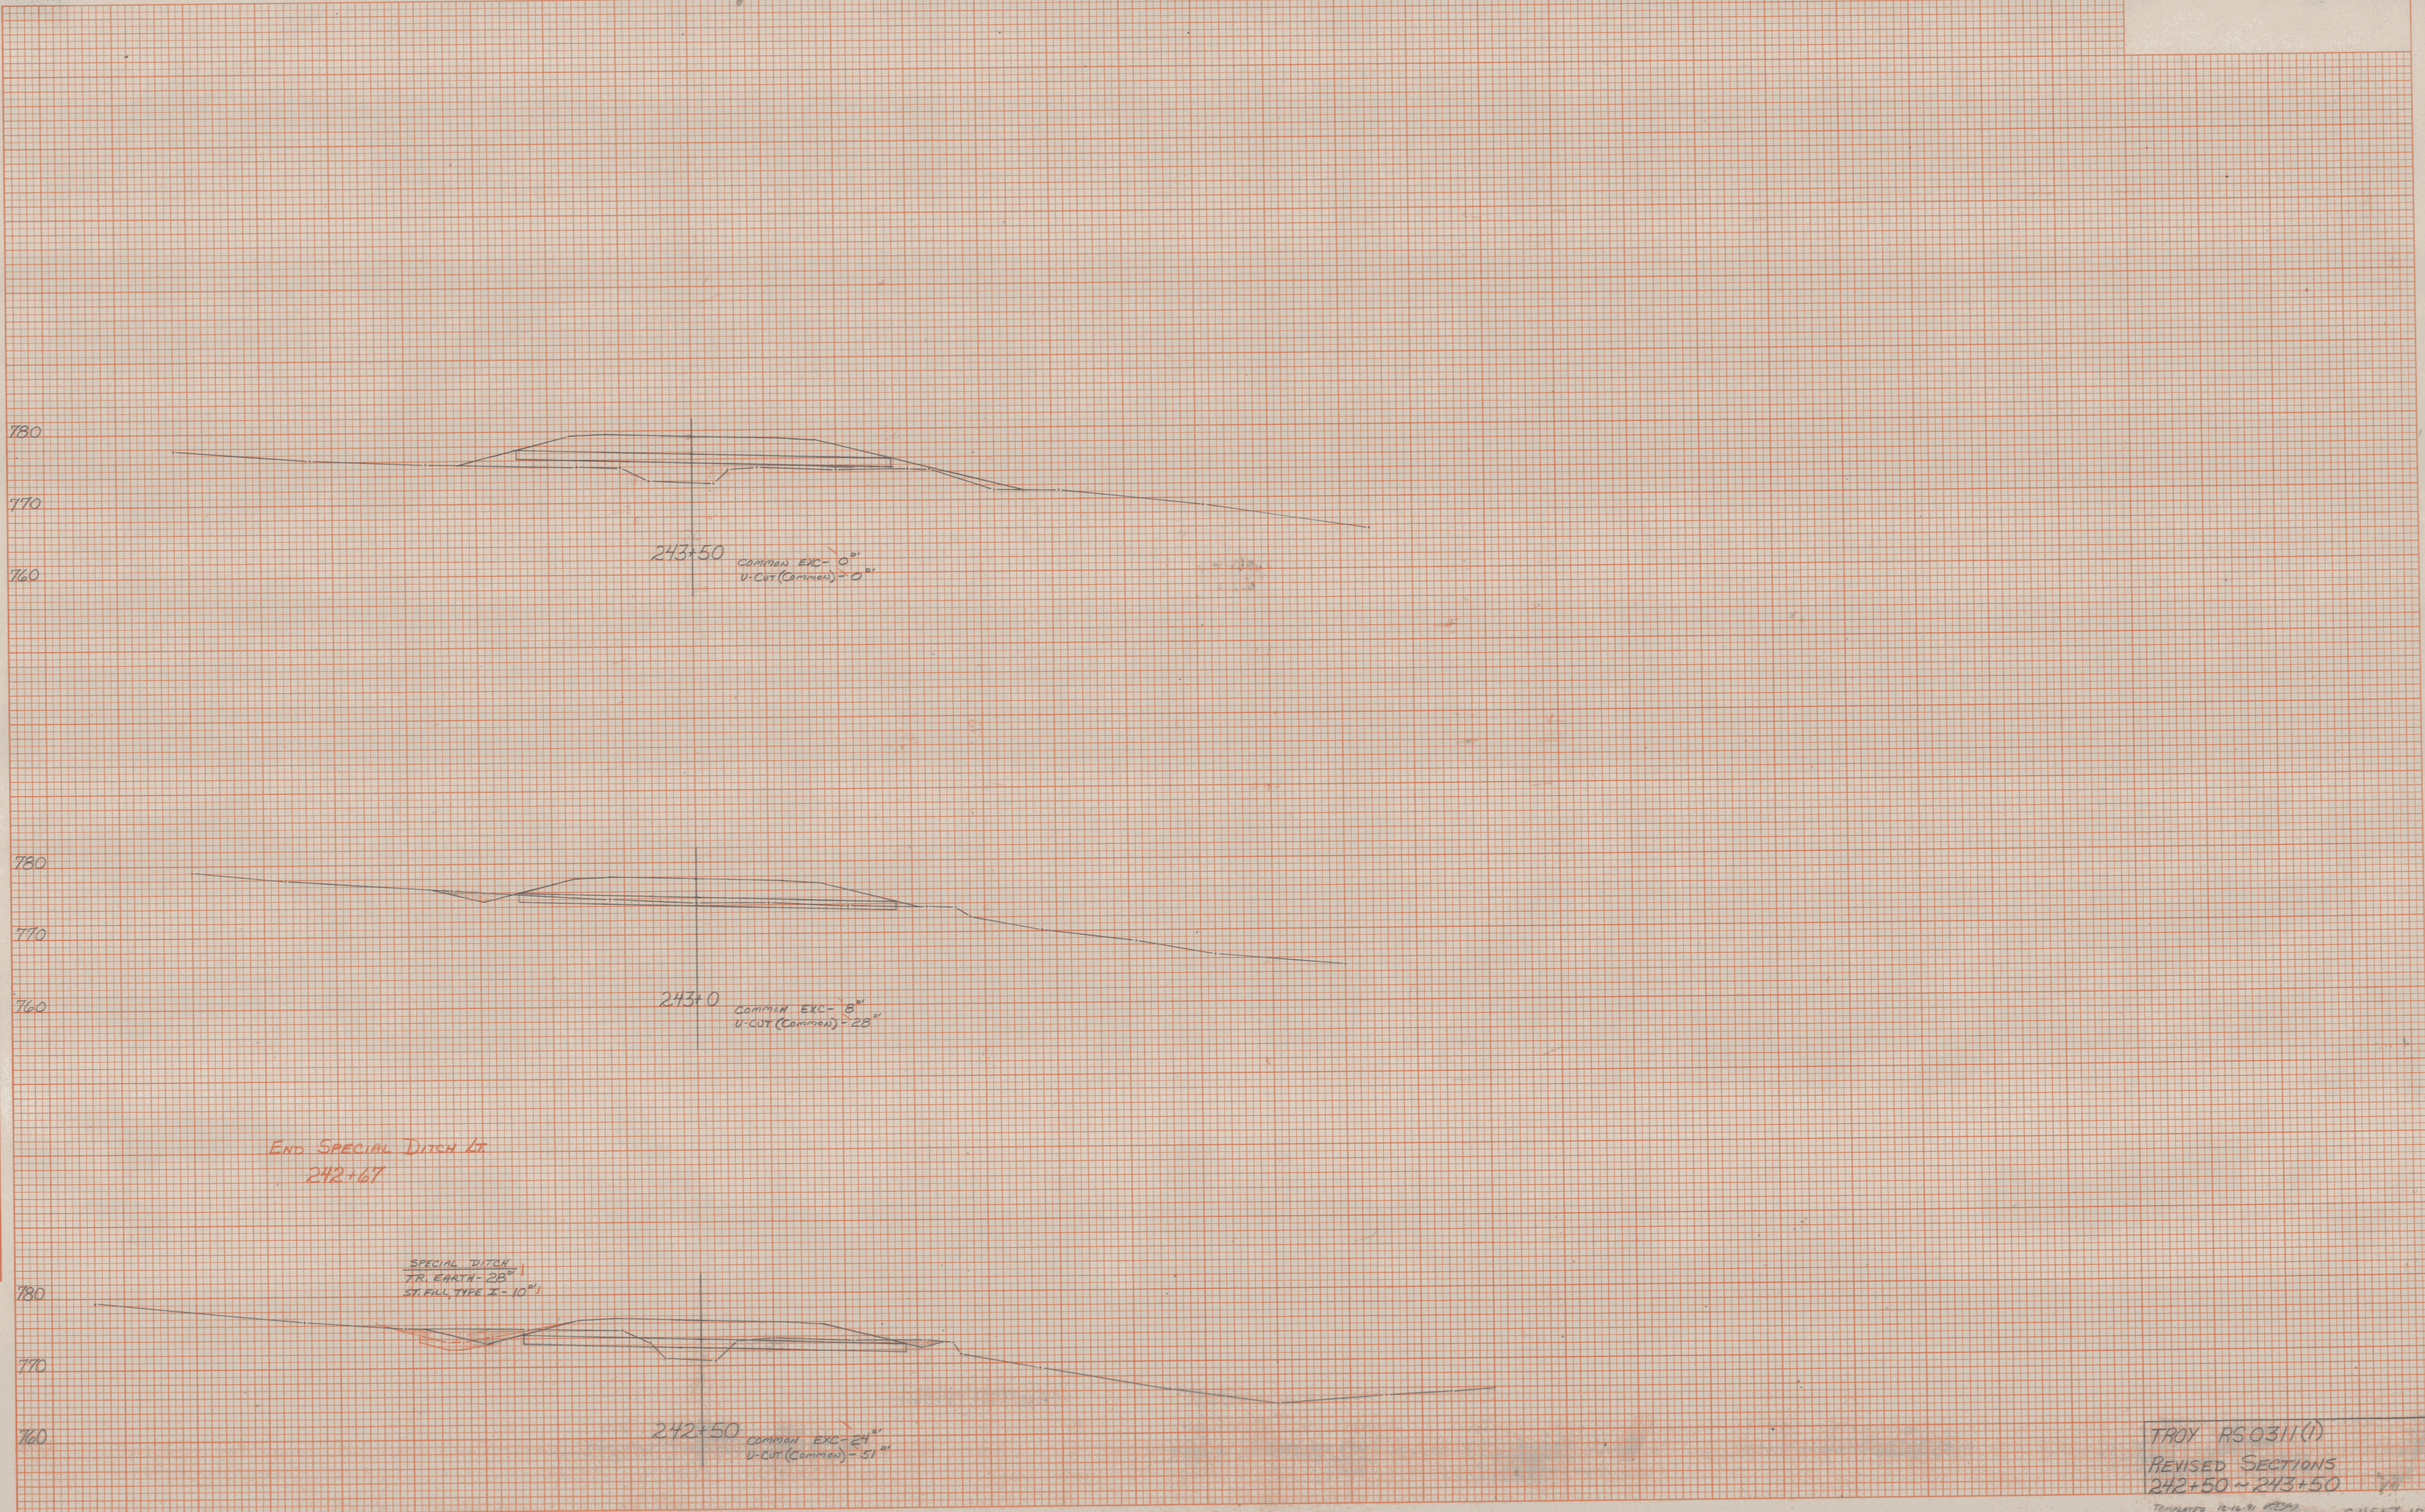

END SPECIAL DITCH LT  
242+67

SPECIAL DITCH  
TR. EARTH - 28"  
ST. FILL TYPE X - 10"

TROY R50311(1)  
REVISED SECTIONS  
242+50 ~ 243+50  
TEMPLATED 12-16-91 RSM  
REVISIONS 1-23-93  
PLAN 3-31-92 RJA  
SHEET 100 OF 187  
280 PAVTS