


DATE
BY
SURVEYED
PLOTTED
CHECKED
DATE
NO.

DATE
BY
SURVEYED
PLOTTED
CHECKED
DATE
NO.

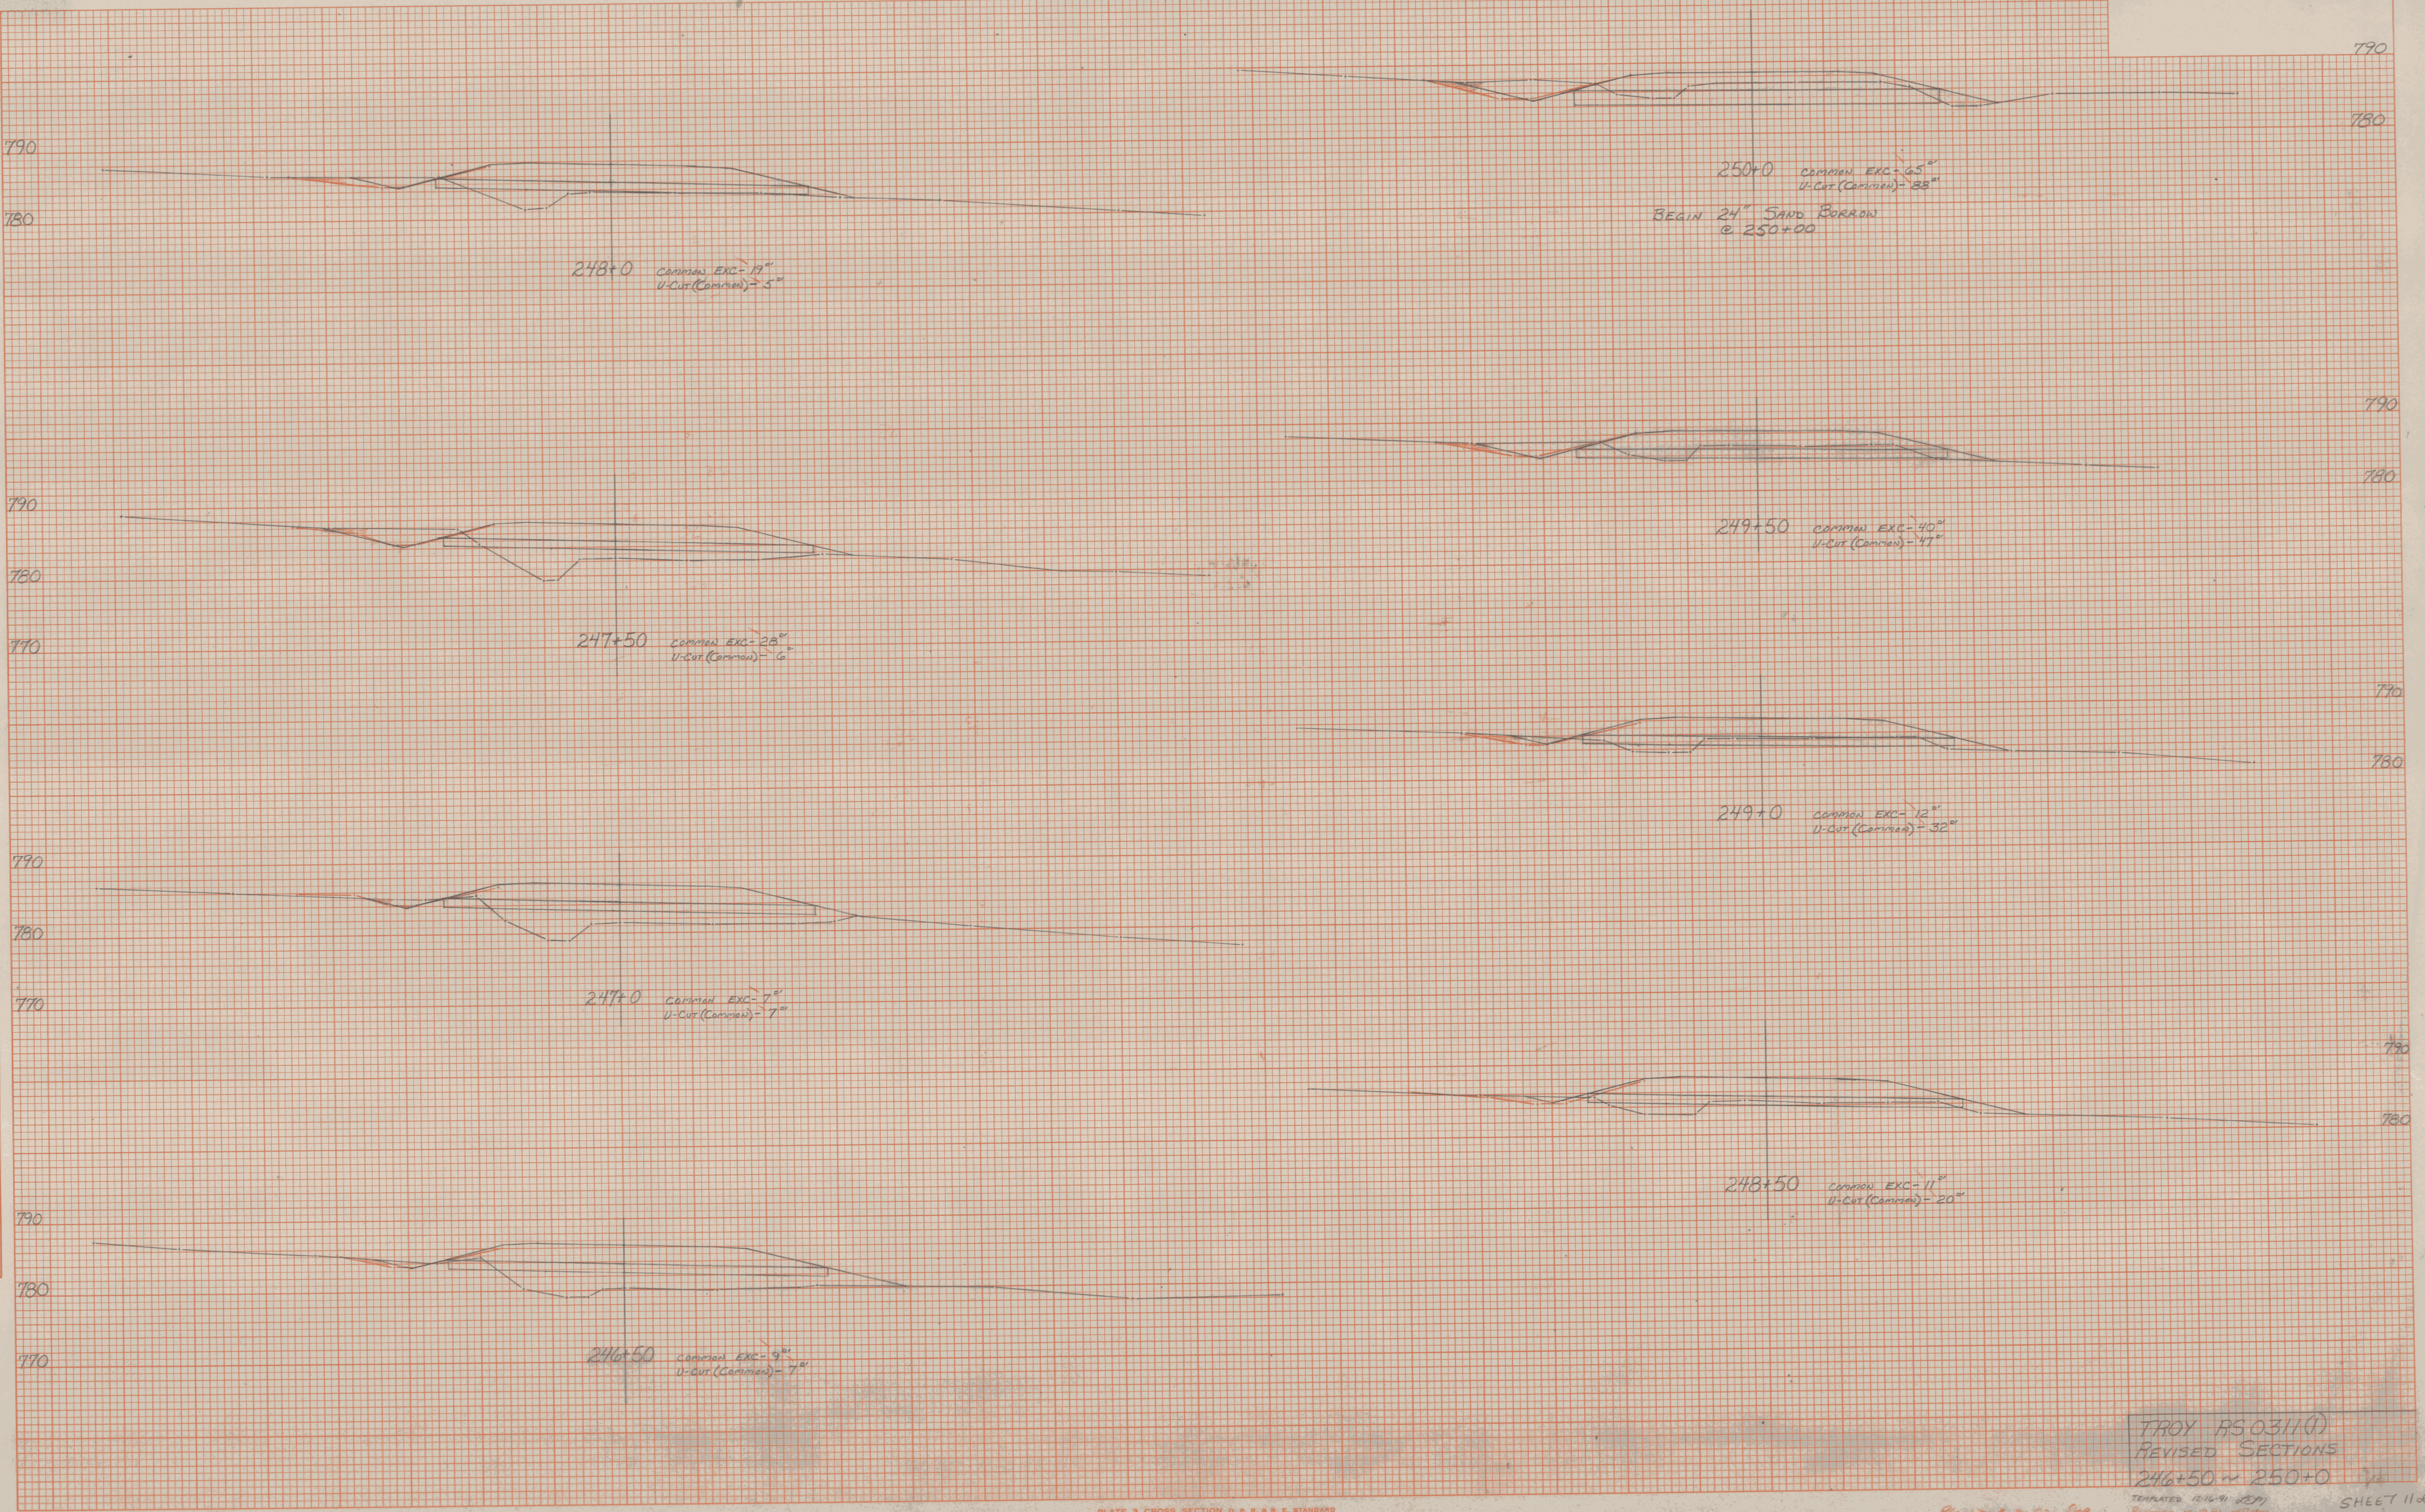

TROY RS 0311(1)
REVISED SECTIONS
246+50 ~ 250+0
TEMPLATED 12/16/91 (257)
PLOTTED 12/17/91 (257)
PLANNETREED 1-23-92 (257)
SHEET 11 of 18
251 REV'S