


DATE _____
 BY _____
 ORIGINAL SURVEY NOTE BOOK NO. _____
 REVISIONS
 PLOTTED _____
 REVISIONS _____
 AREA CHECKED _____

DATE _____
 BY _____
 ORIGINAL SURVEY NOTE BOOK NO. _____
 REVISIONS
 PLOTTED _____
 REVISIONS _____
 AREA CHECKED _____

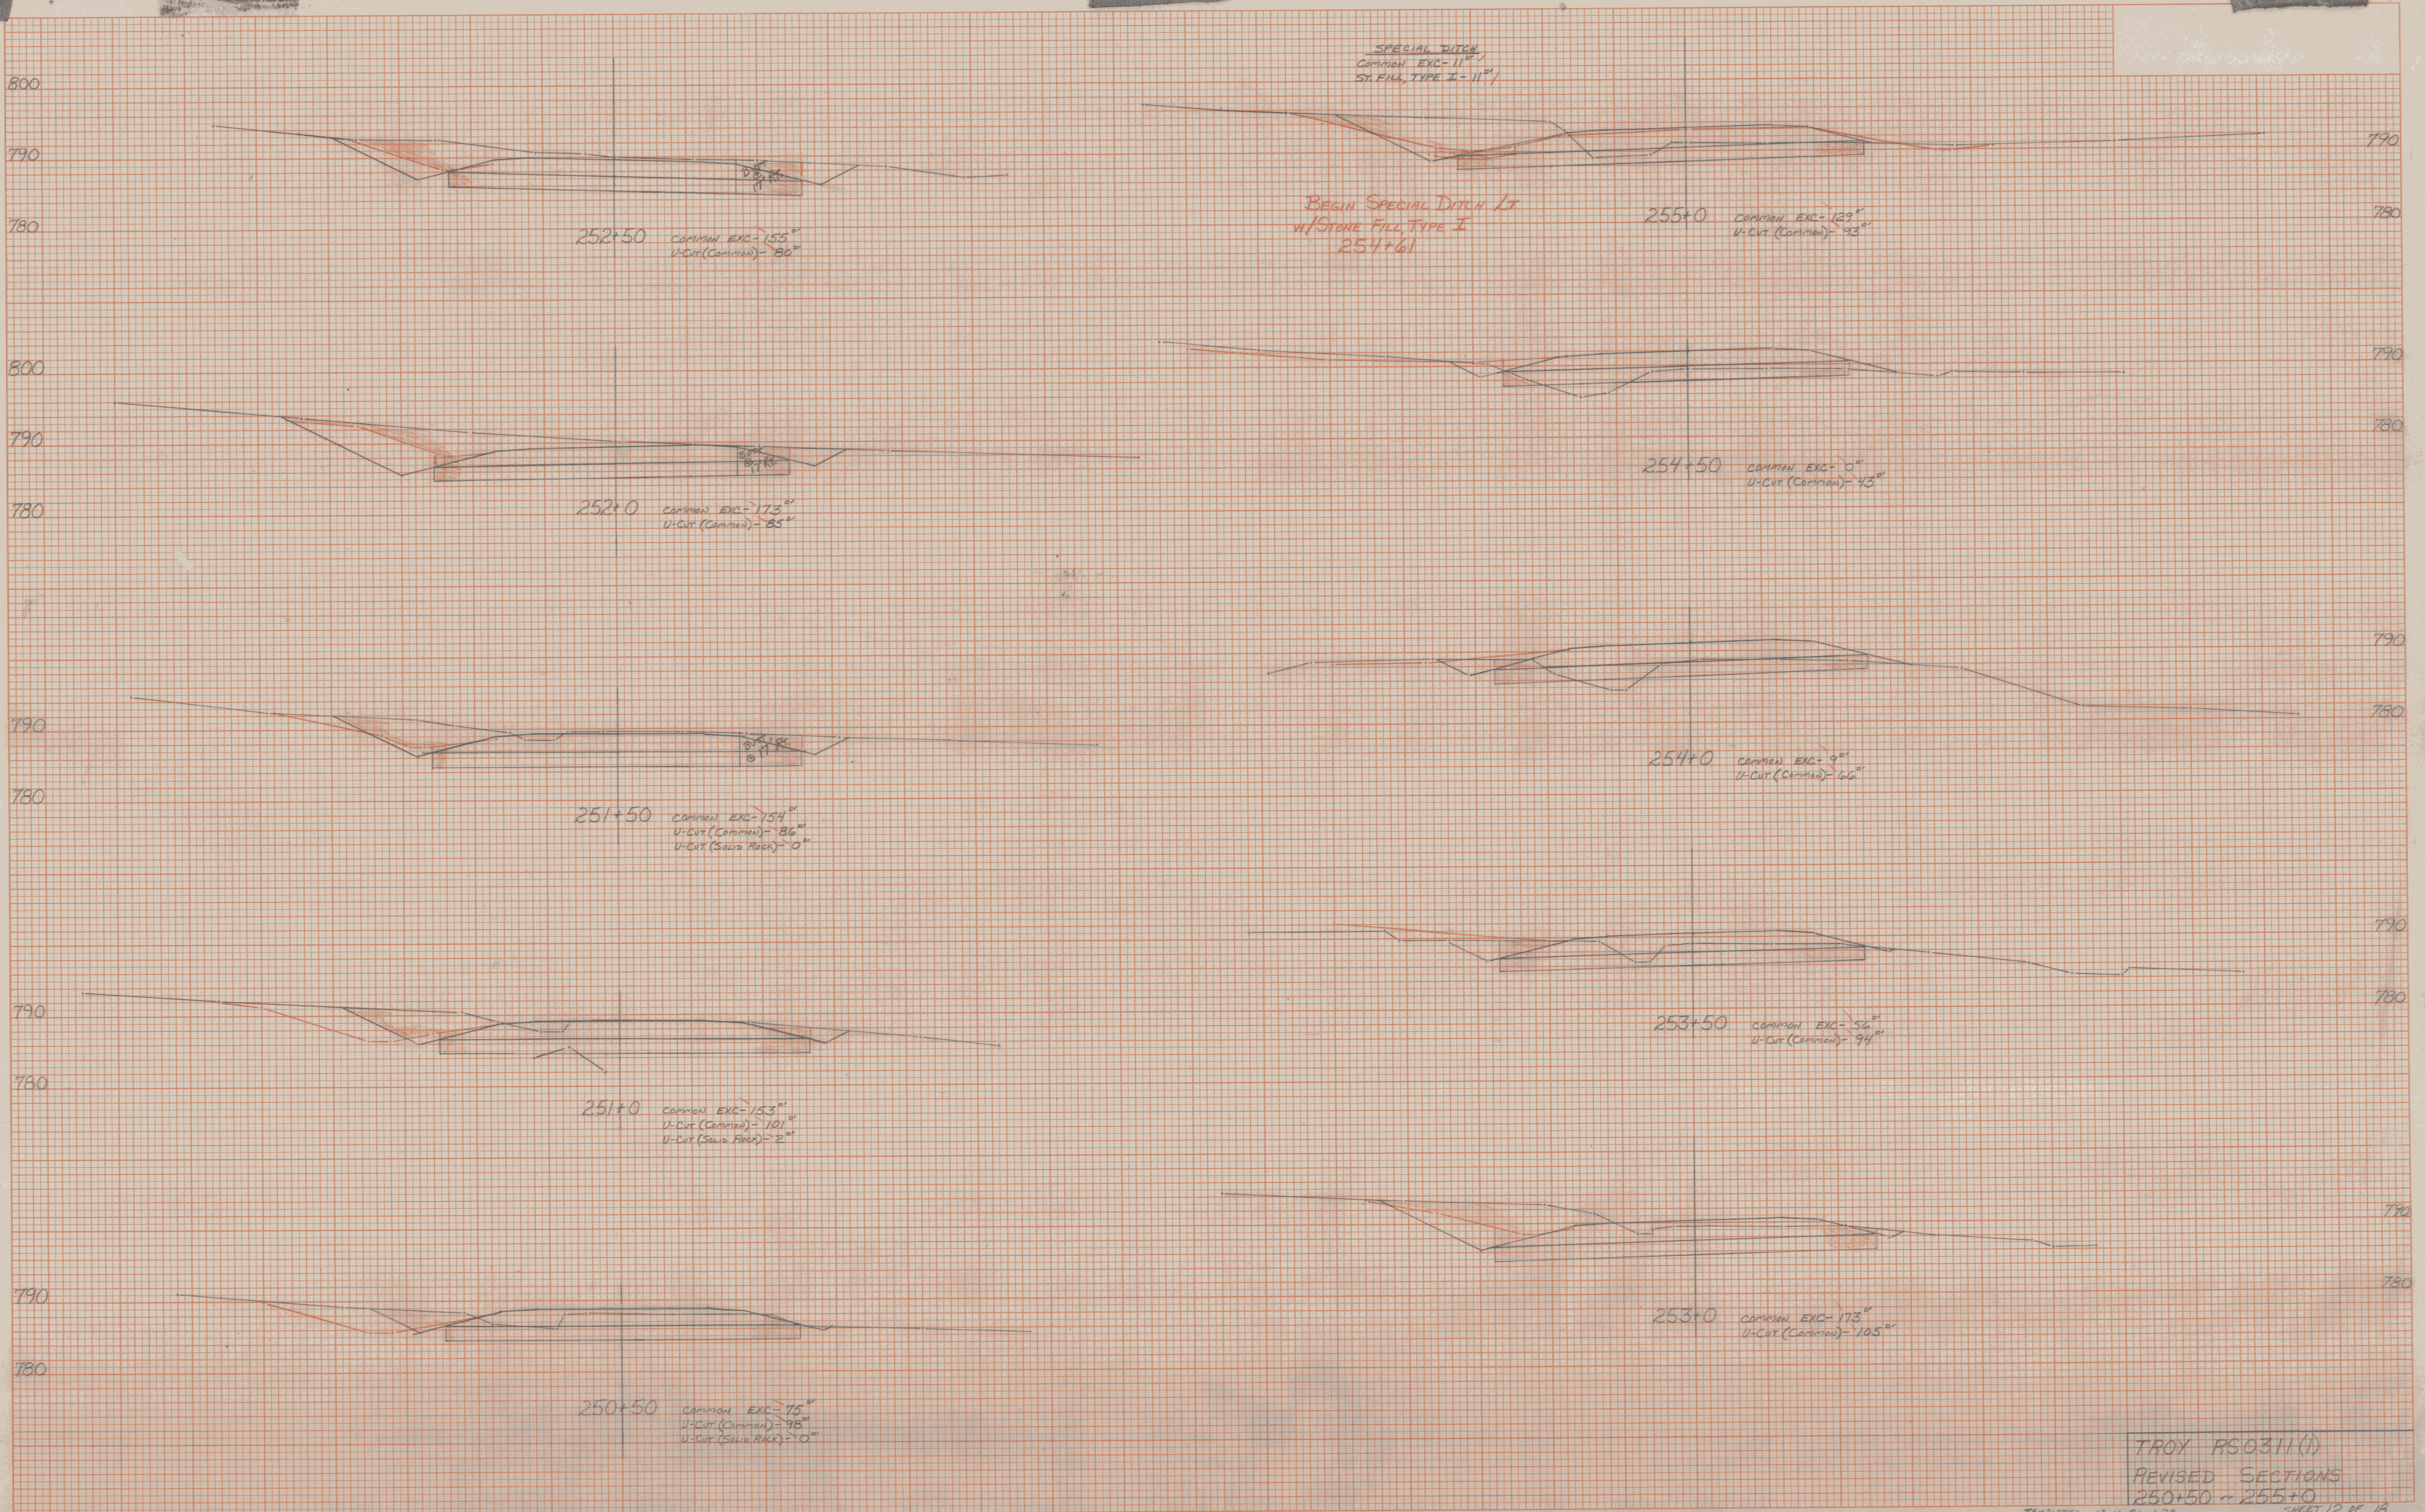

REV-3-31-92 1003