


DATE  
BY  
SURVEYED  
PLOTTED  
AREA  
NO. CHECKED

DATE  
BY  
SURVEYED  
PLOTTED  
AREA  
NO. CHECKED

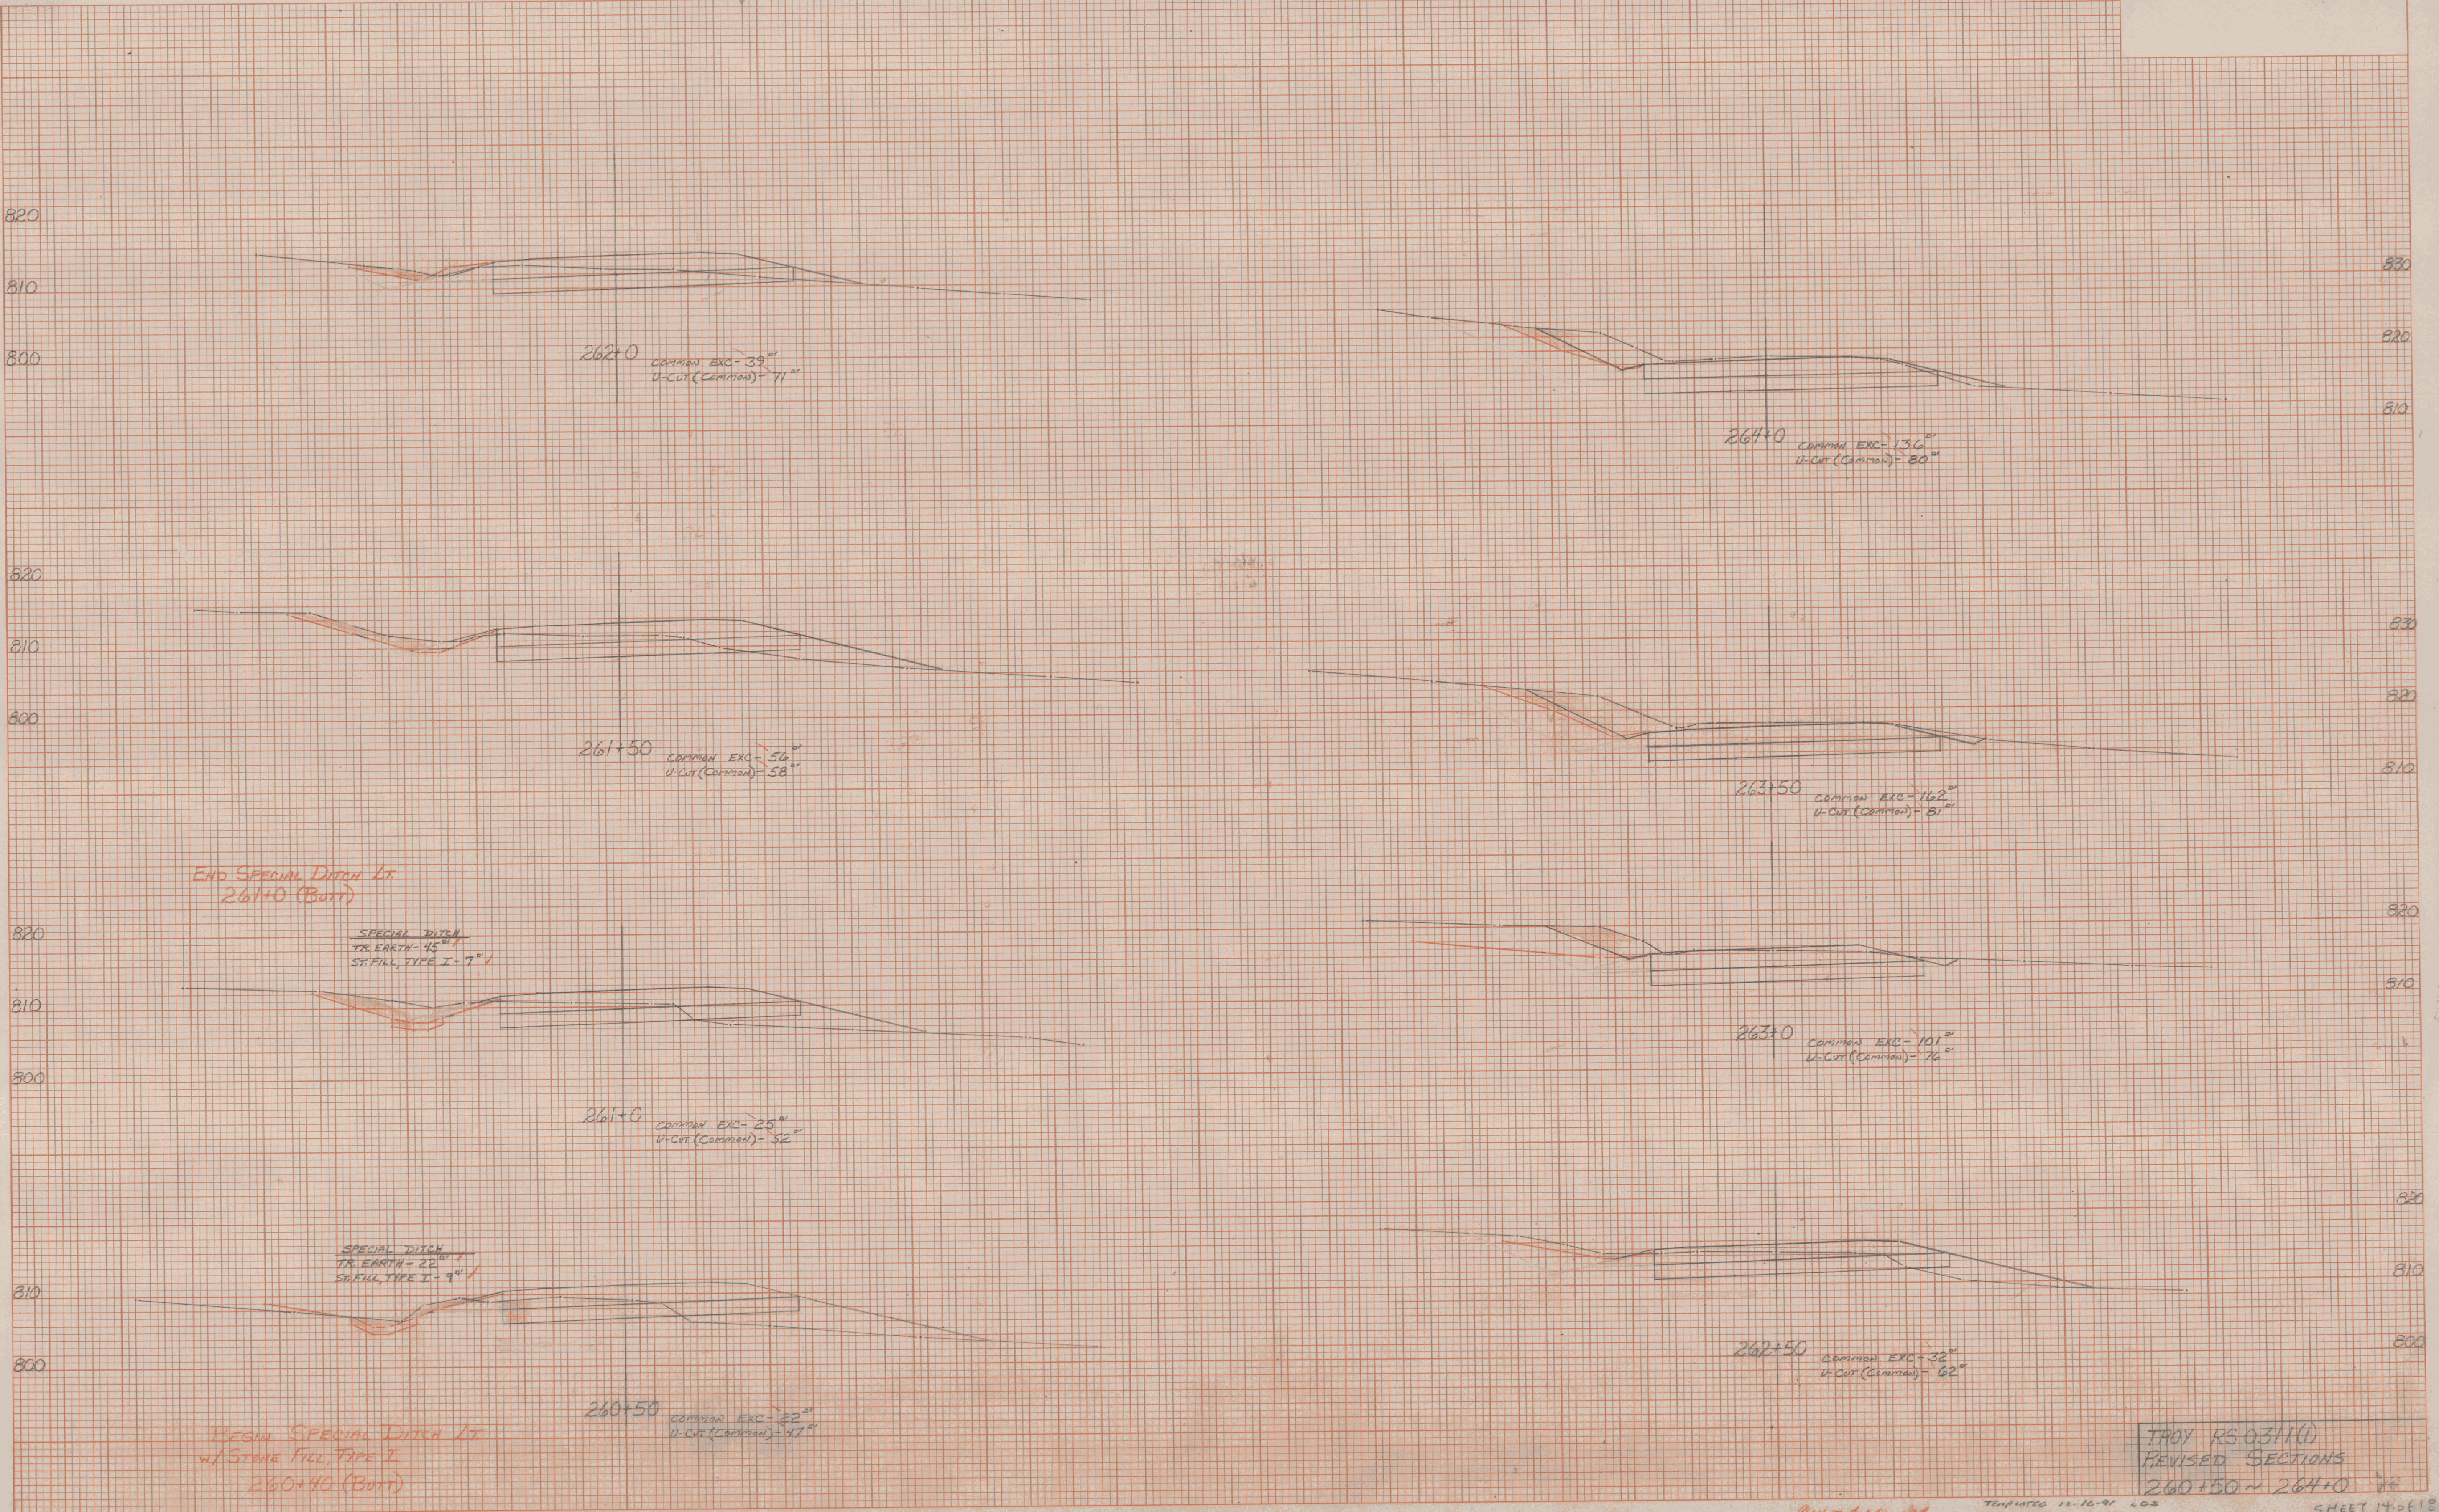

TROY RS 0311(1)  
REVISED SECTIONS  
260+50 ~ 264+0