



DATE
BY
SURVEYED
NOTES
NO. 1

DATE
BY
SURVEYED
NOTES
NO. 1

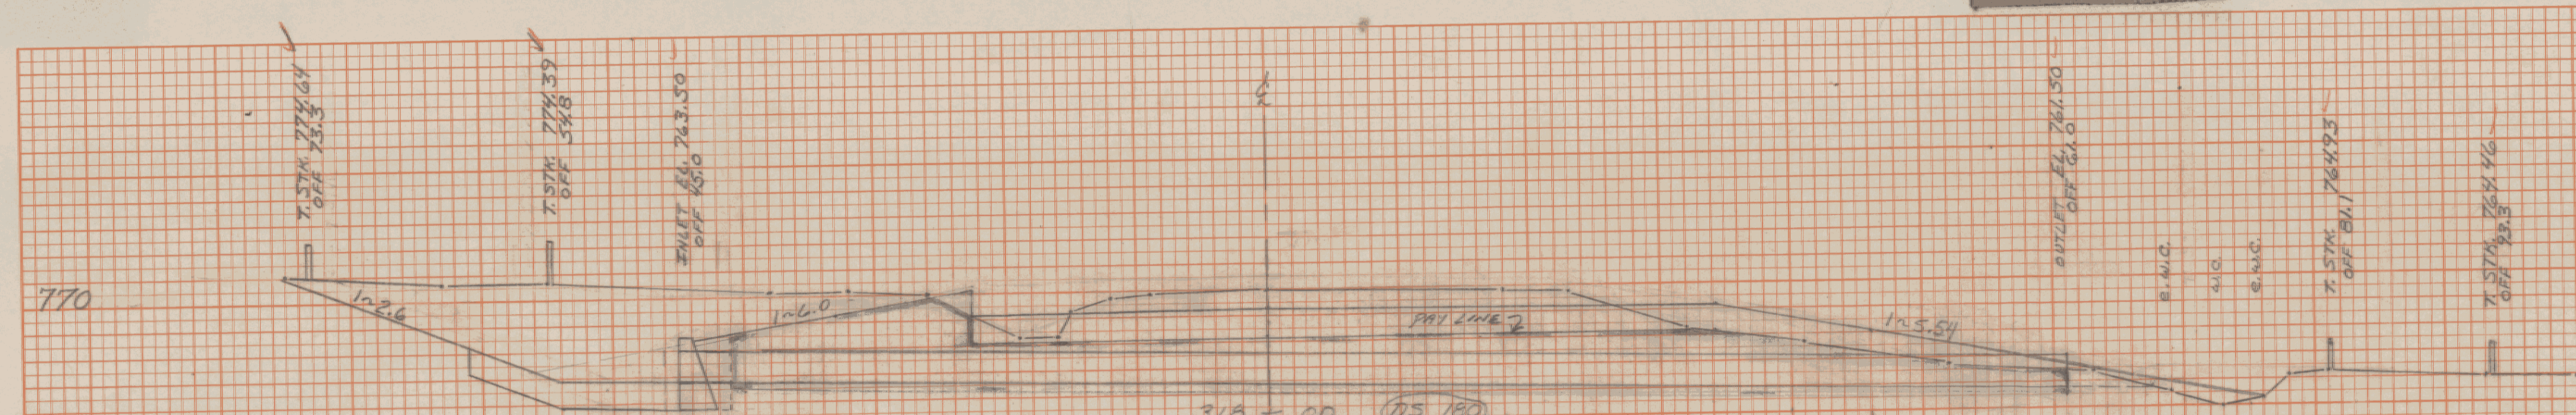


TRENCH EARTH
HD. WALL - 12' x 20' x 1/2' = 12.00 cy.
PIPE - 42" x 4.6 x 1/2' = 10.00 cy.
GRAN. B.F. FOR STRUCTURES 88.91 cy.
0.5 x 102' x 4.6 x 1/2' = 8.69 cy.
S.G.N. 11.7.91
5-12-91 D.W.H.
10-22-91 A.D.S.

TRENCH EARTH 10.3 cy.
129' x 4' x 1/2' = 12.90 cy.
S.G.N. 11.7.91

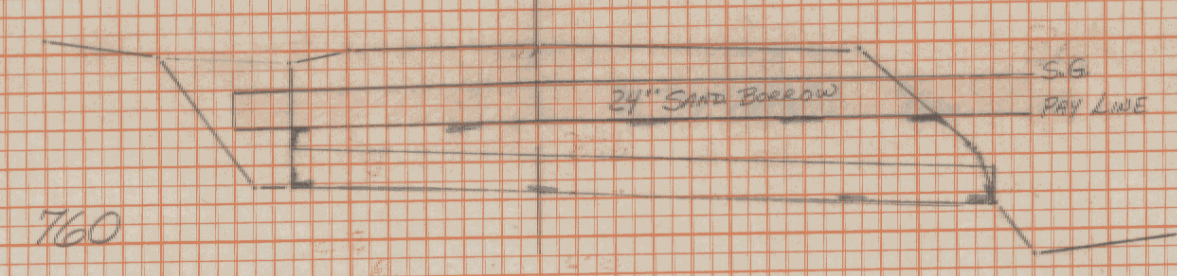

318 + 37 (S. 1.61)
(REMOVAL) Bx 2F P. 80
24" CBRT

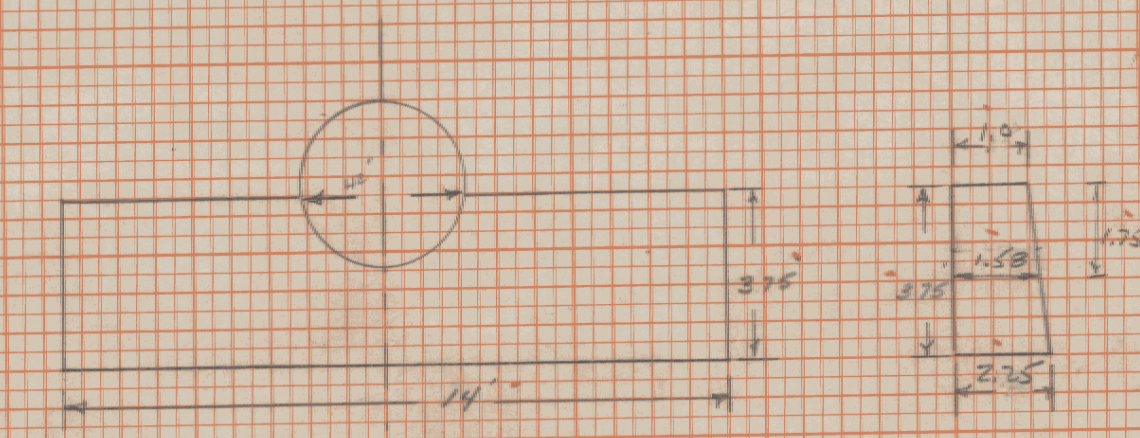


HEADWALL 321.77 RT (MOD.)

C.R.H. (MOD. OF HDW)
 $(10 \times 3.75) + (1.65 \times 3.75) = 6.09 \times 14 = 85.31 \text{ ft}^2$
 $\pi (1.75)^2 \times (1.0 + 1.58) = 6.21 \text{ ft}^3$
 $\frac{79.10}{2.7} = 29.3 \text{ cy}$
HDWLS HEREIN IN FIELD HEREIN
RT 3.75 x 14' 4' x 14' 14'

C.R.H. Inter HDW = 6.40 cy
From Bx D-2
Total CRH = 9.33 cy
- 11-12-91 J.S.D.

Trench Earth
Pipe - Area = 2.97 x 100 = 297 ft²
Volume = 297 x 5.6 = 1665 + 27 = 1692 C.Y.
H.D.N. Lt. - Area = 0.08 x 100 = 8 ft²
Volume = 8 x 16 = 128 + 27 = 155 C.Y.
H.D.N. Rt. - Area = 0.08 x 100 = 8 ft²
Volume = 8 x 16 = 128 + 27 = 155 C.Y.
Total Trench Earth = 1692 C.Y.
Pipe was back filled with Granular Borrow. Pay for out of pit.
S.G.N. 6.17.91

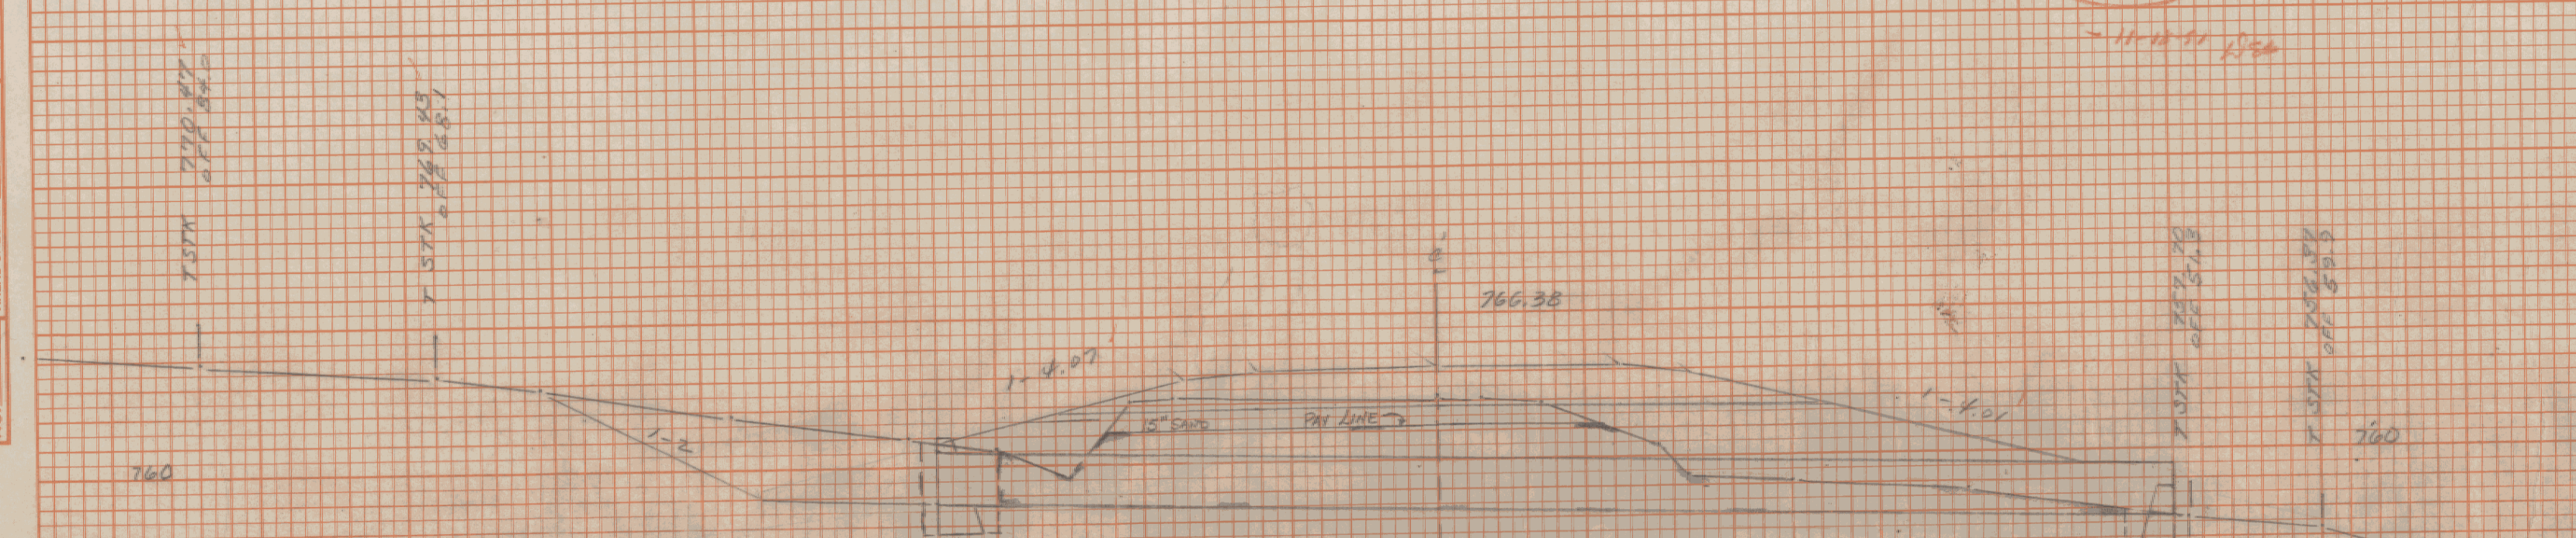

321 + 77 (S. 1.85)
42' x 84' PCCSP (0.109)
SHW P. INLET & CHW & OUTLET
Bx 2F P. 118