



DATE: _____
 BY: _____
 SURVEYED: _____
 PLOTTED: _____
 CHECKED: _____
 FINAL SURVEY NOTE BOOK No. _____


DATE: _____
 BY: _____
 SURVEYED: _____
 PLOTTED: _____
 CHECKED: _____
 ORIGINAL SURVEY NOTE BOOK No. _____

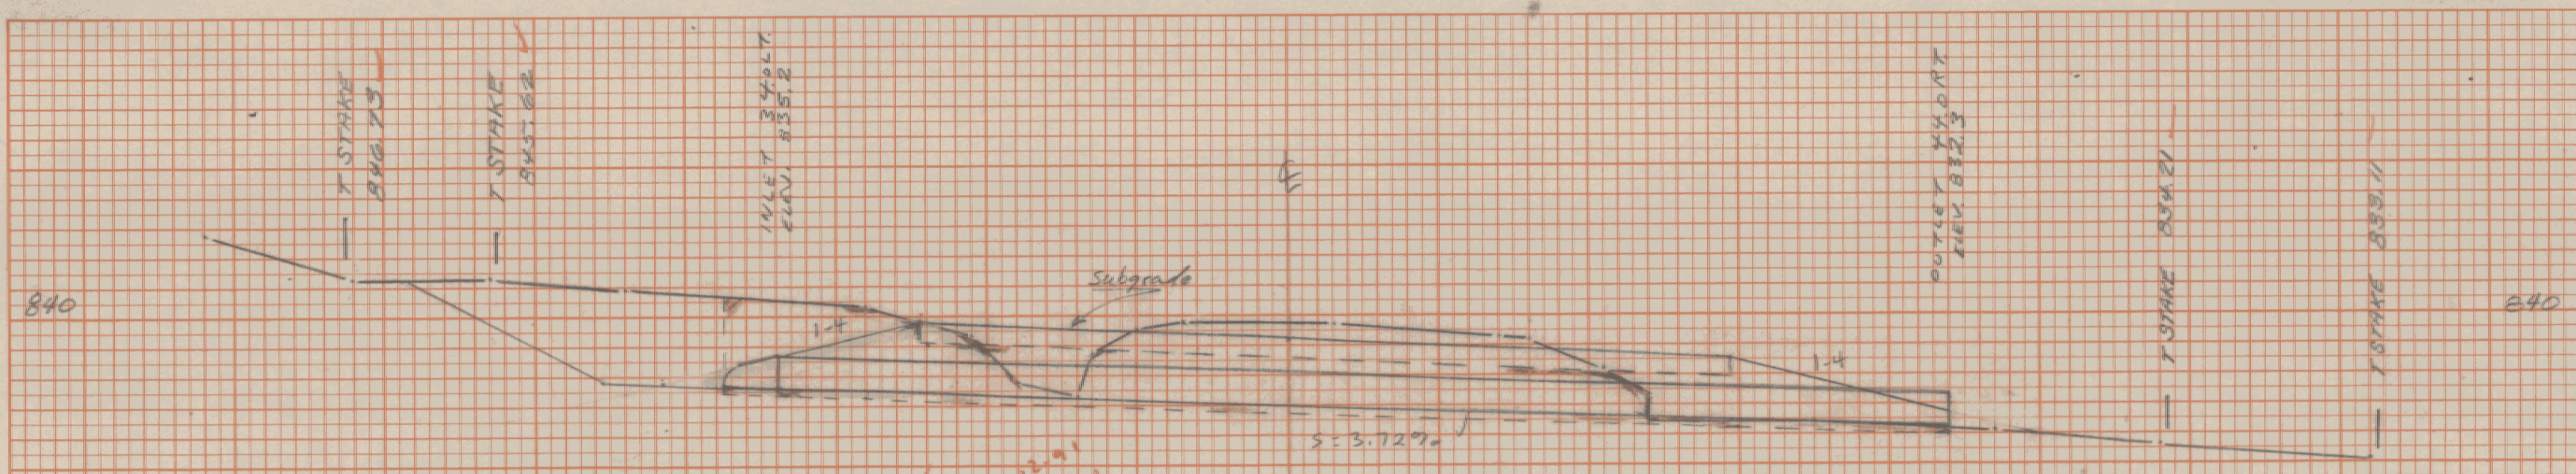


TRENCH EARTH 40.2 cy
 GRAN. BACKF. STRUCT.
 6" x 0.5' x 4.1' x 1/2" = 4.6 cy
 282+06.5 DS152
 ASKEW 27 51' RT
 24" x 24" PCCSP (CONC) W/ES. C. INLET
 BOOK 2E PG 64

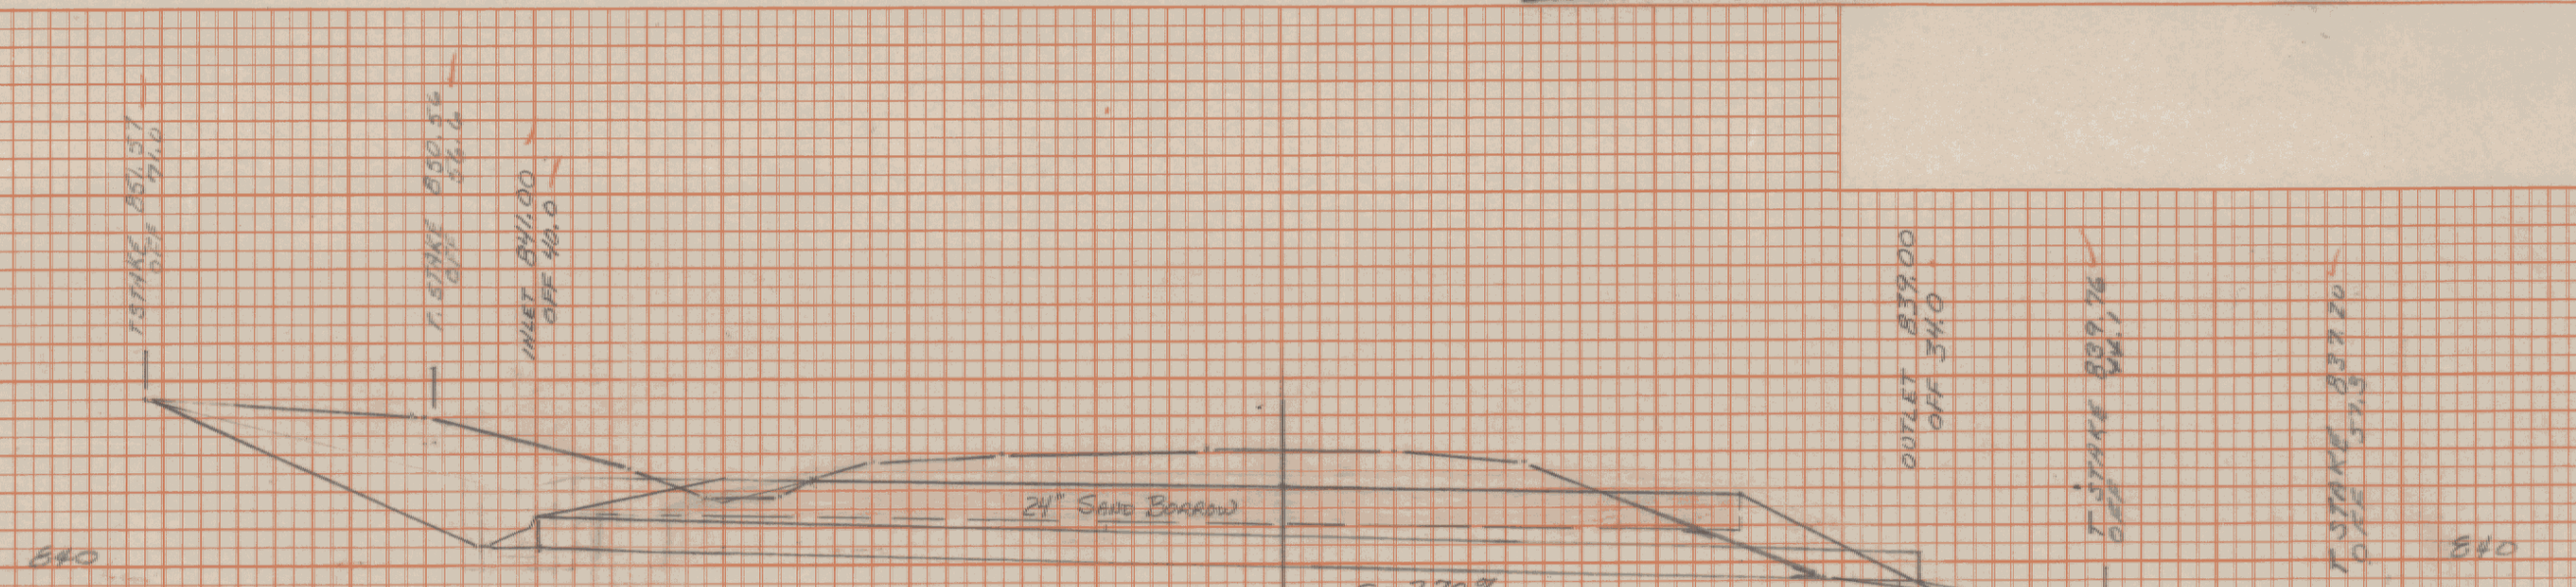


204.20 TRENCH EARTH
 0-5'
 PIPE - 12" x 3.6' = 493.2 F³
 D.I. - 27" x 6' = 162.0 F³
 TOTAL = 655.2 F³ = 27-24.3 CY
 275+95
 18" x 24" PCCSP (CONC)
 DS152
 REMOVED D.I. & INSTALLED END SECTION 1/11/44

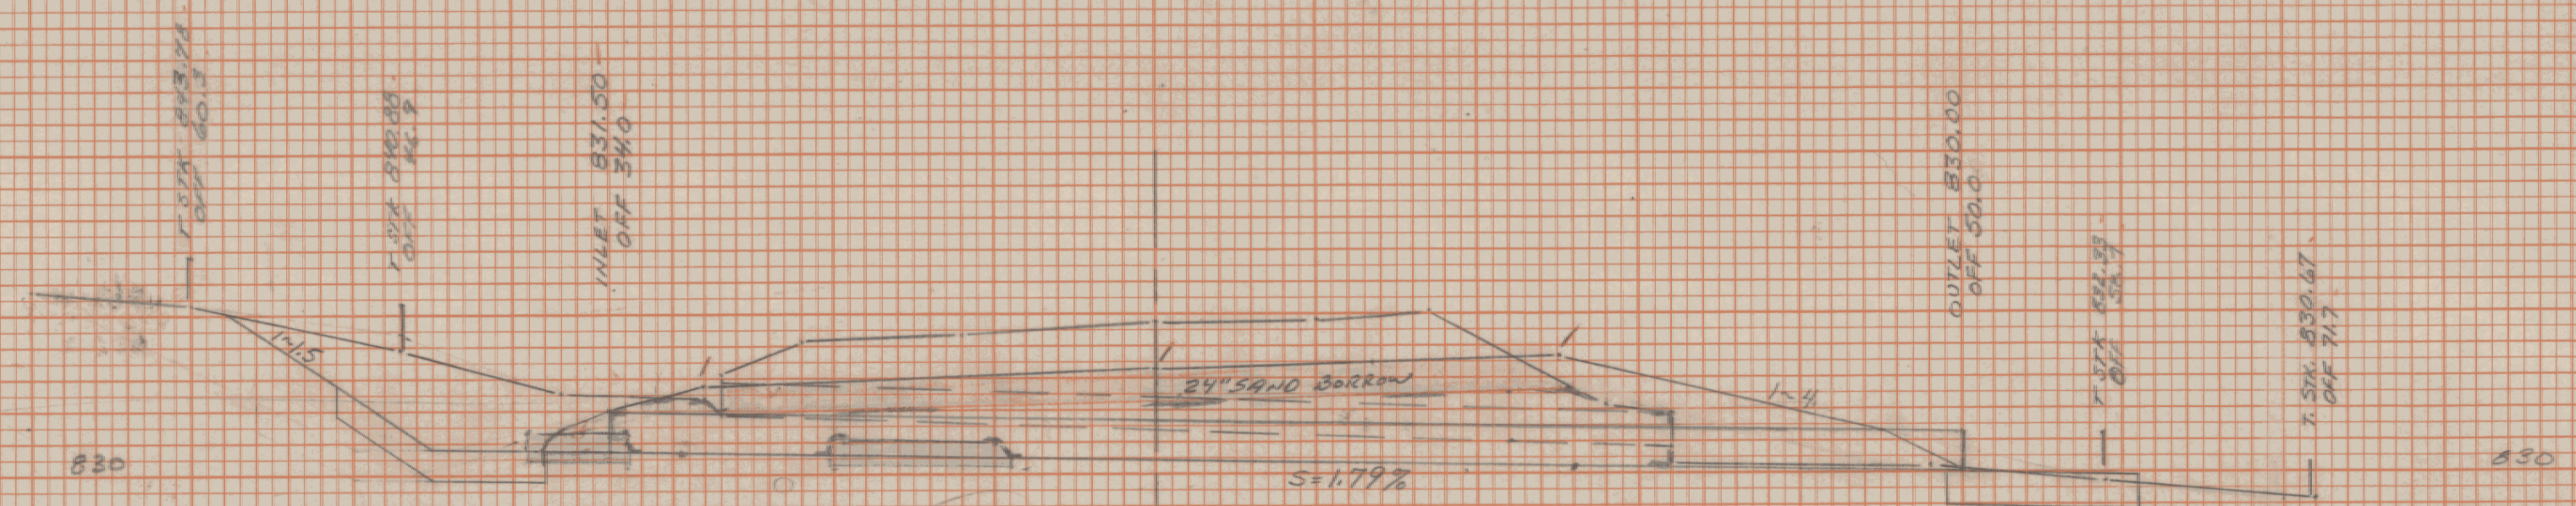

271+58 ASKEW 31' RT
 30" x 24" PCCSP (CONC) W/ES. C. INLET
 BOOK 2E PG 34

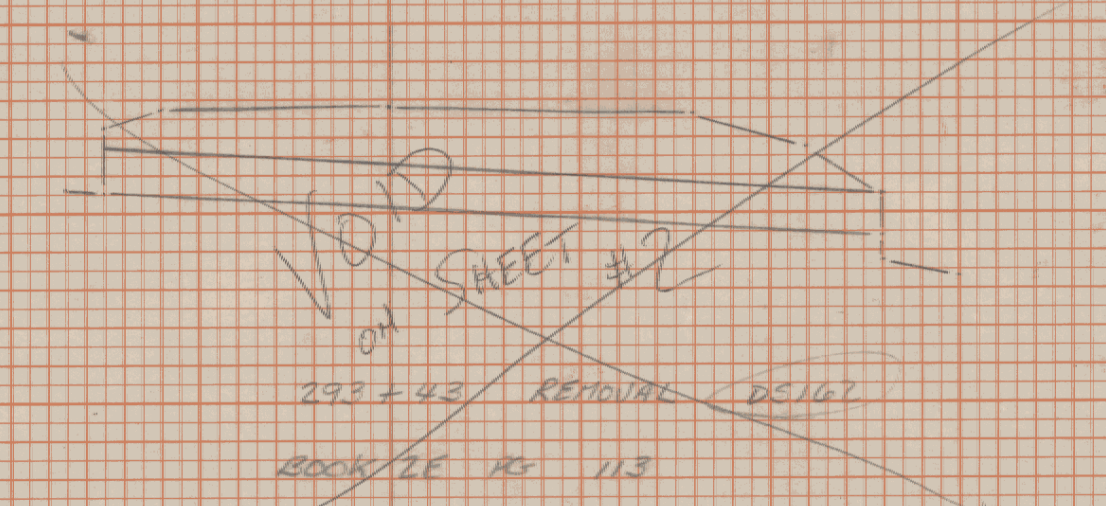


272+0 (838.02)
 (0-5') TRENCH EARTH
 MES & PIPE 22.5" x 4.6' x 1/2" = 35.33 cy T.E.
 (0-5') TRENCH ROCK
 MES & PIPE 16" x 4.6' x 2.0' x 1/2" = 5.45 cy T.R.
 GRAN. BACKFILL STRUCT.
 16" x 4.6' x 0.5' x 1/2" = 1.34 cy
 7-12-41 DMH

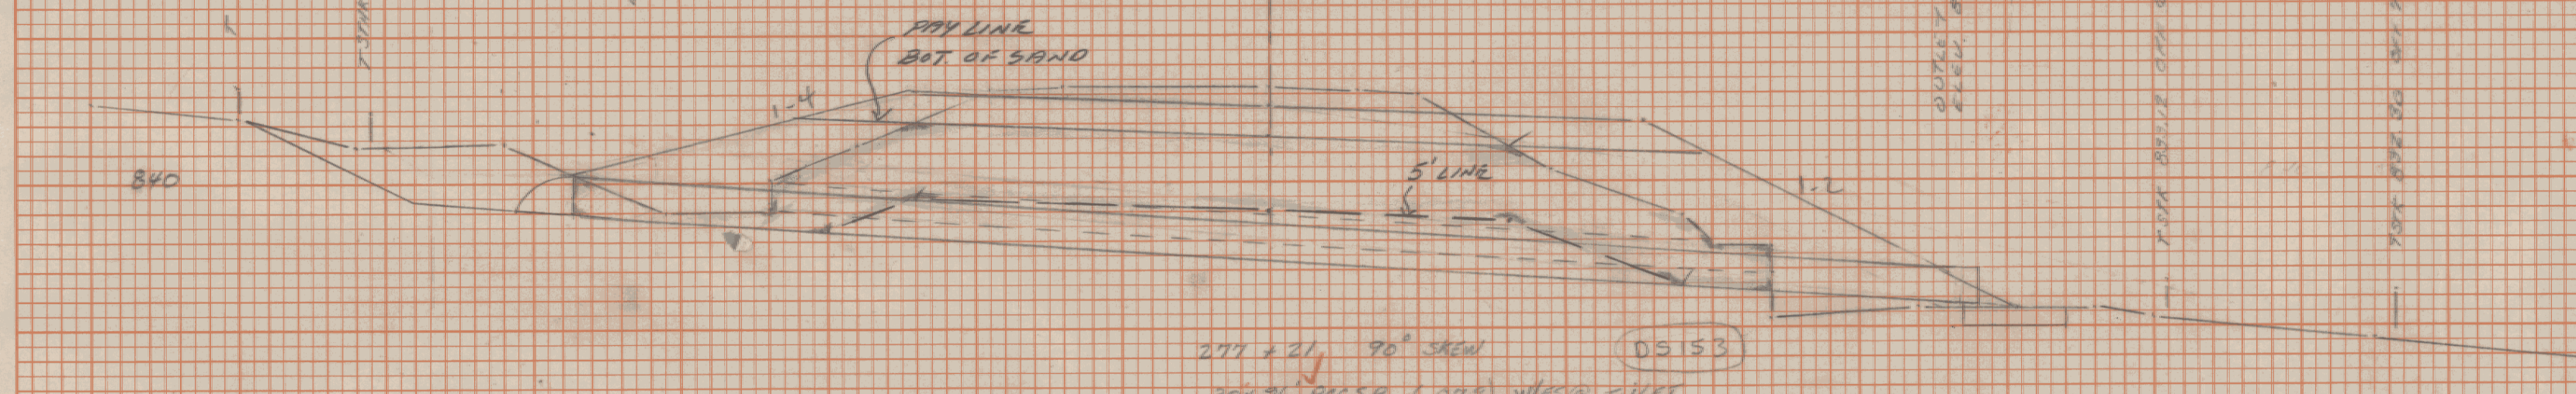

TRENCH EXCAVATION
 PIPE W/ METAL END SECTION 57.24
 (0-5') 33" x 5.7' x 1/2" = 62.77 cy
 (OVER 5') 16.5" x 5.7' x 150# x 1/2" = 46.75 cy
 112.52 cy T.E.
 110-22-61
 7-5-41 DMH

277+21 30" x 24" PCCSP (CONC) W/ES. C. INLET
 BOOK 2E PG 34
 DS153
 PLOT BY LOS
 DRAWN BY LSW 4-1-44

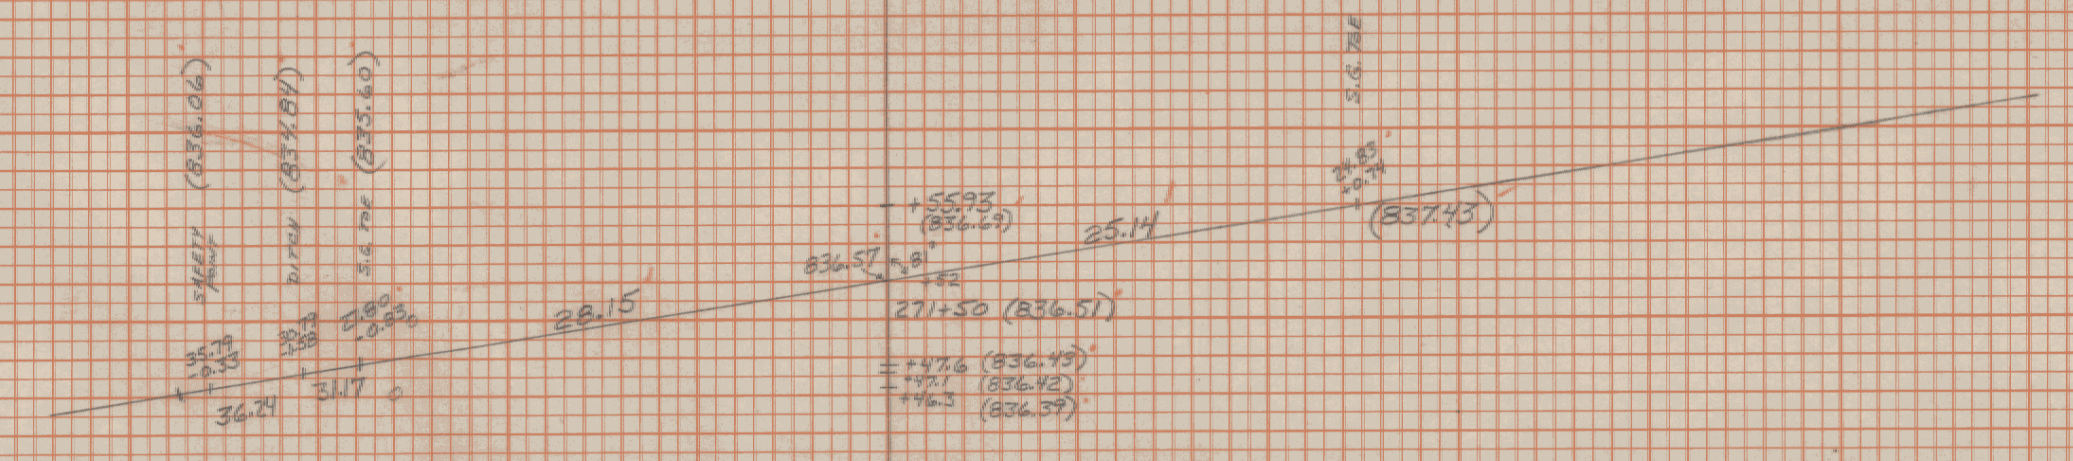

271+50 (836.51)
 27" x 24" PCCSP (CONC)
 DS152

TROY BS 0311 (1)
 DRAINAGE SHEET No. 3