
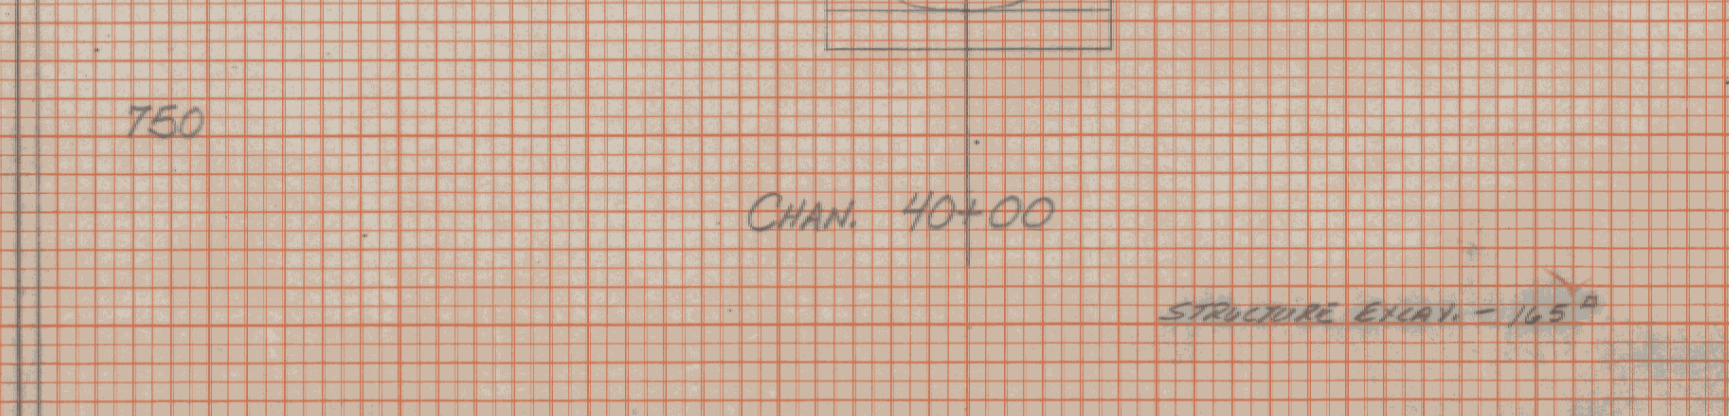
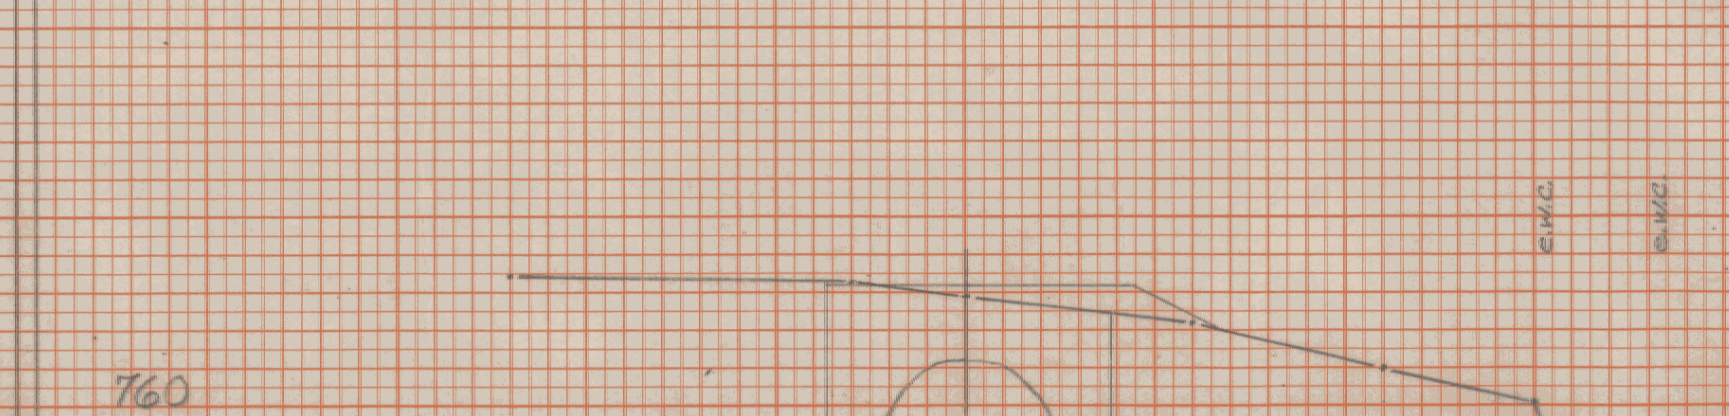
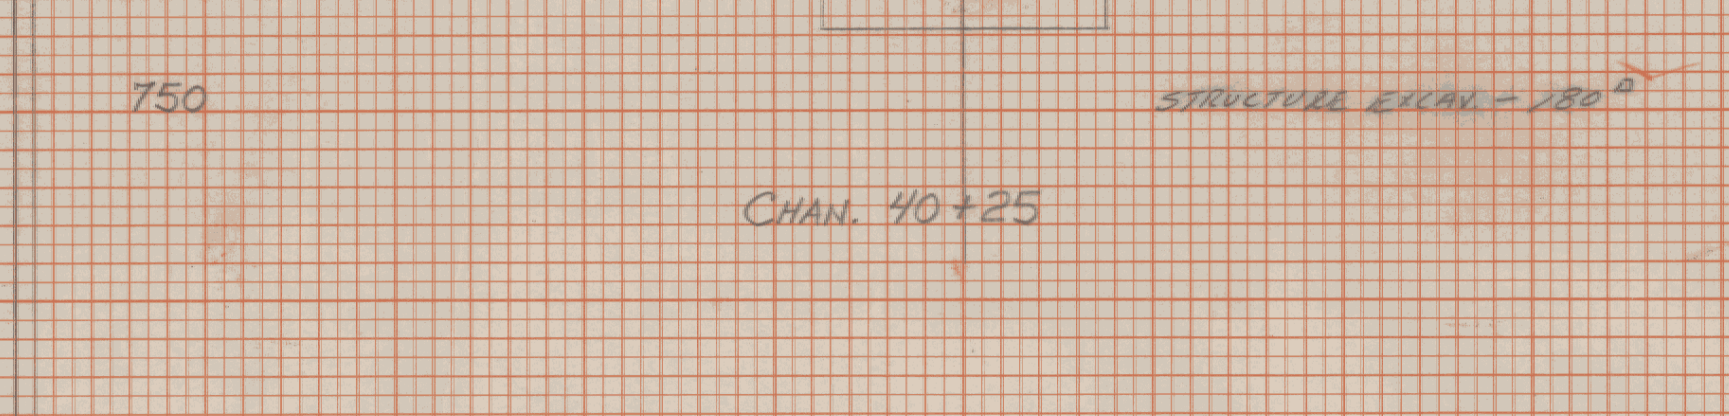
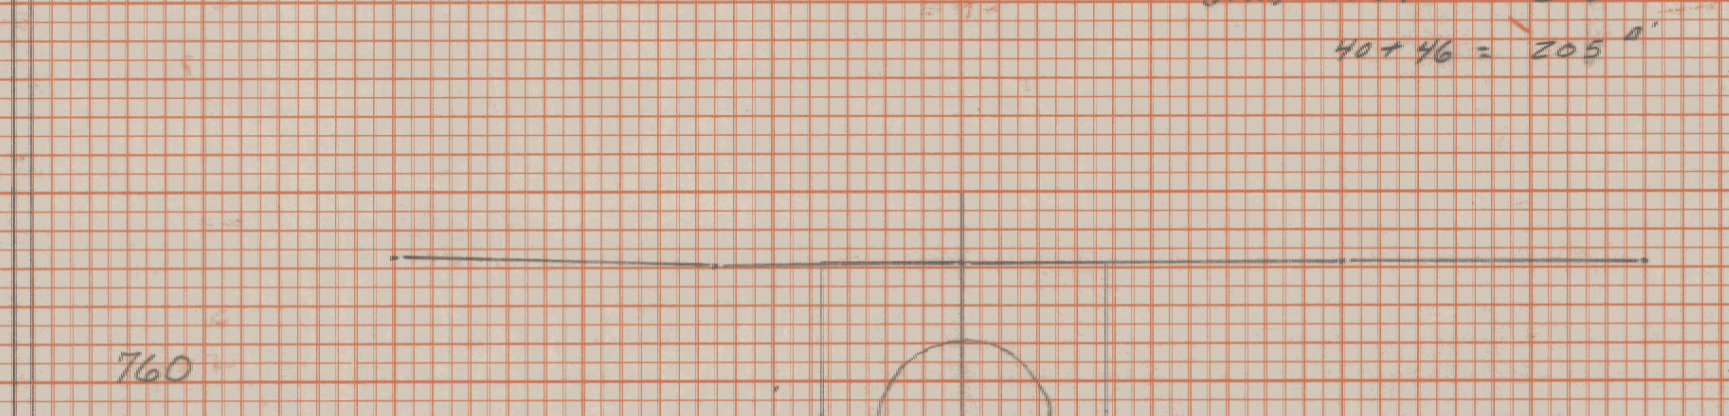
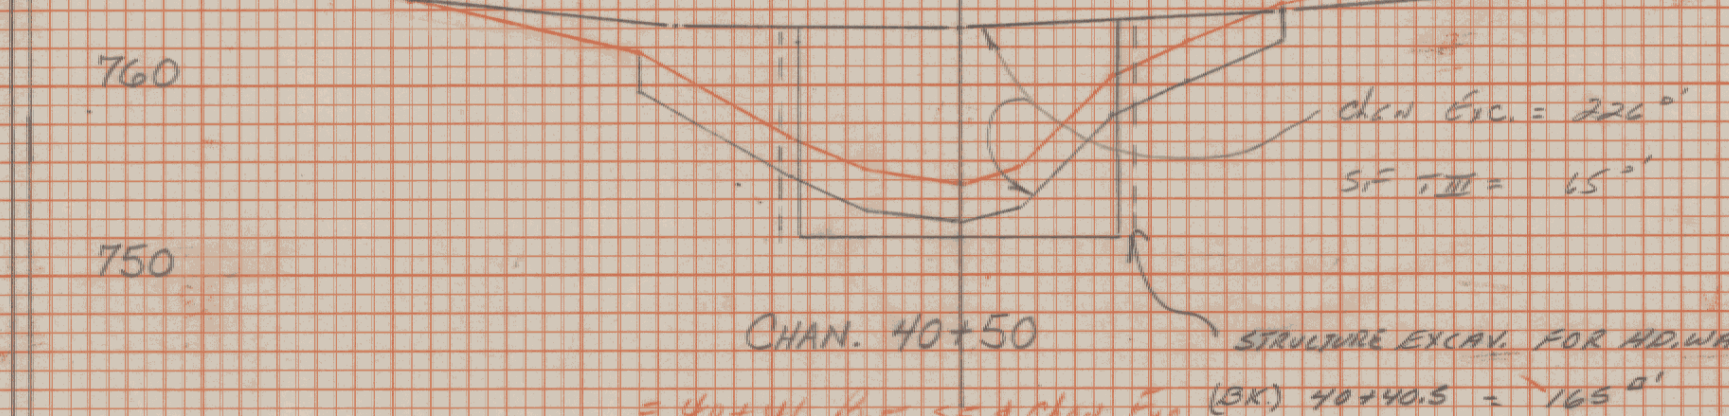
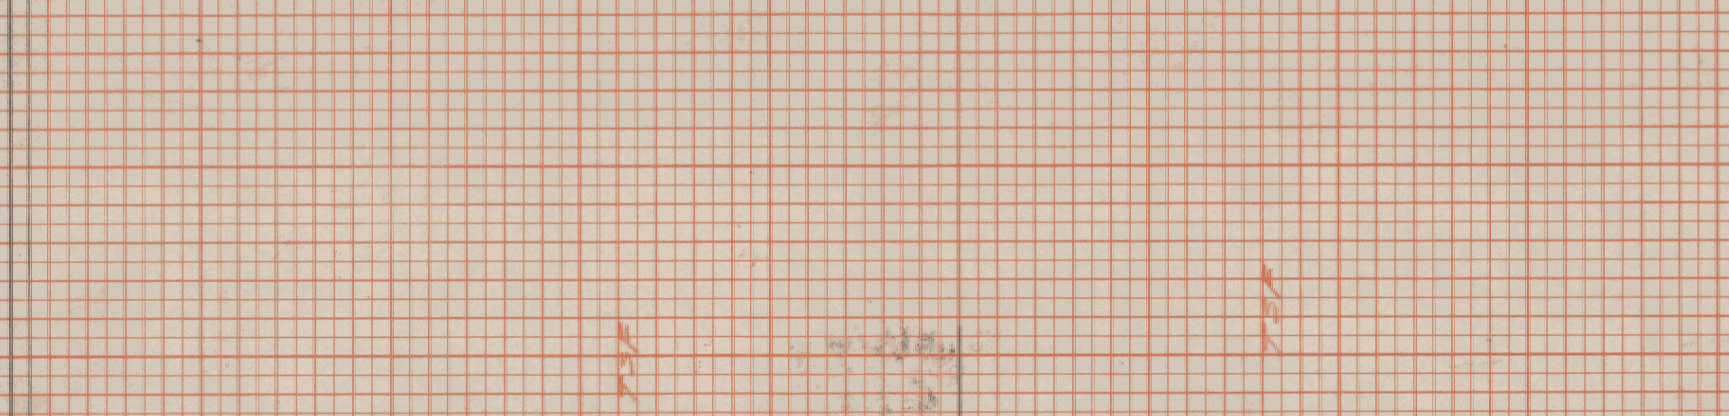
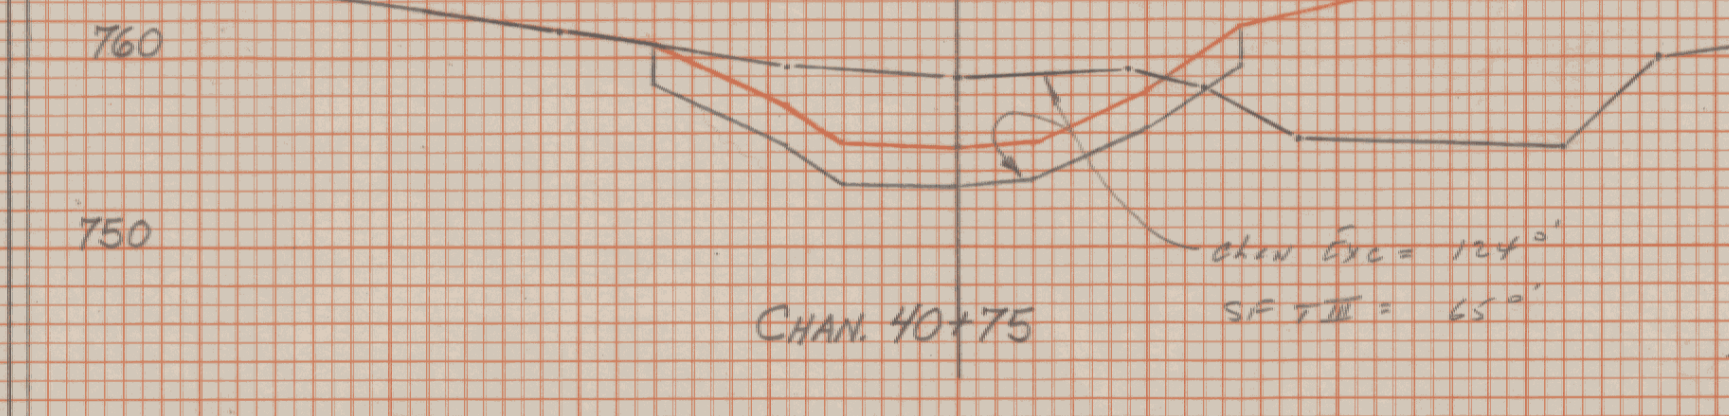
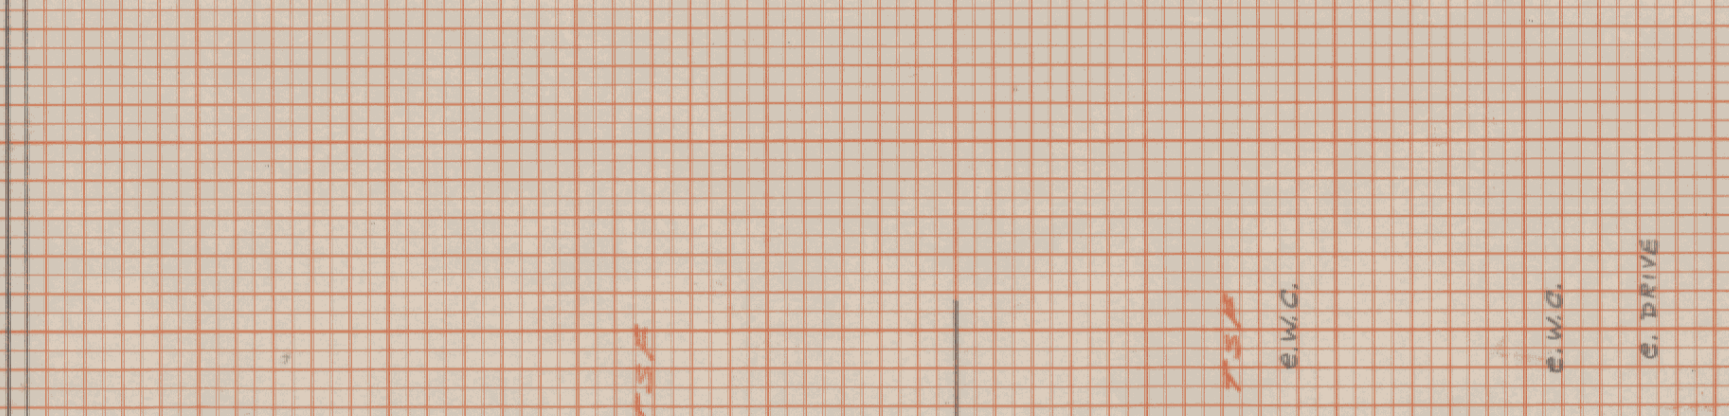
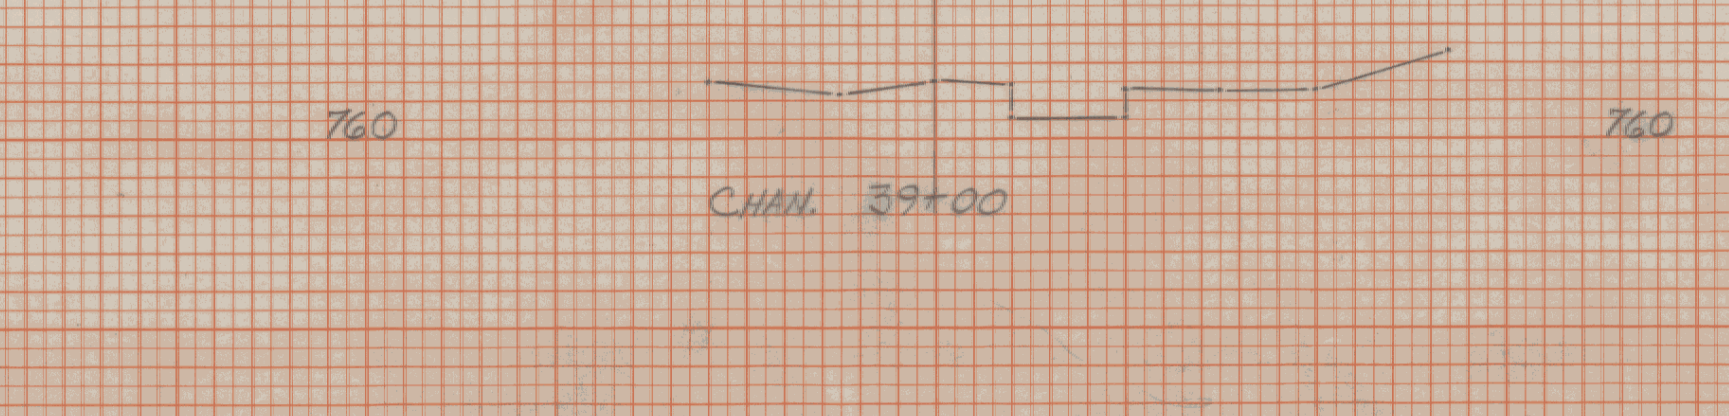
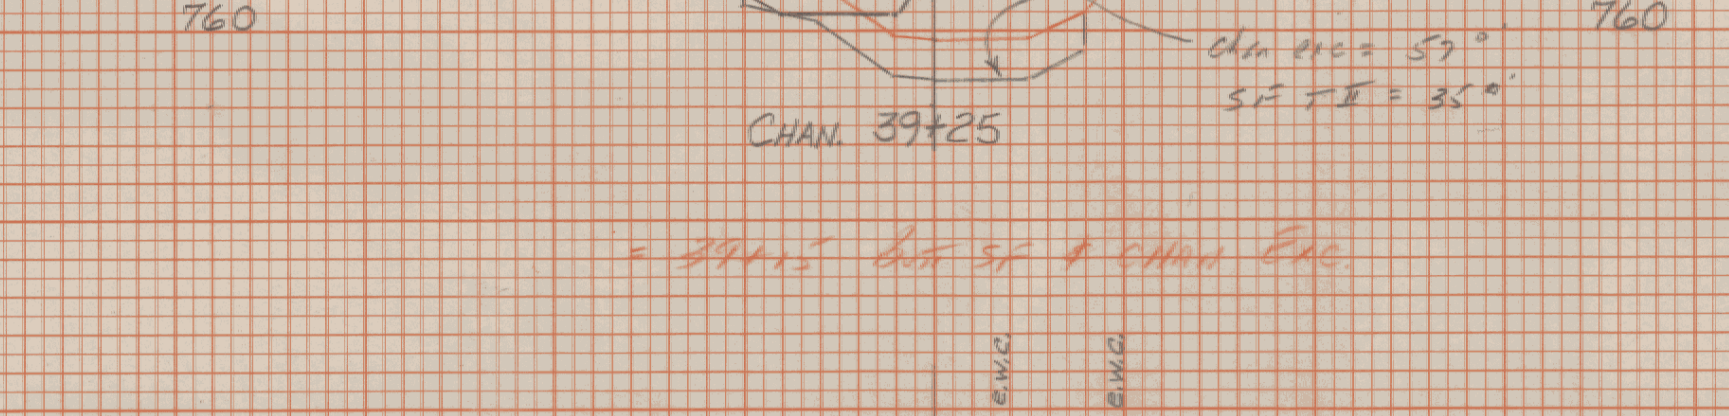
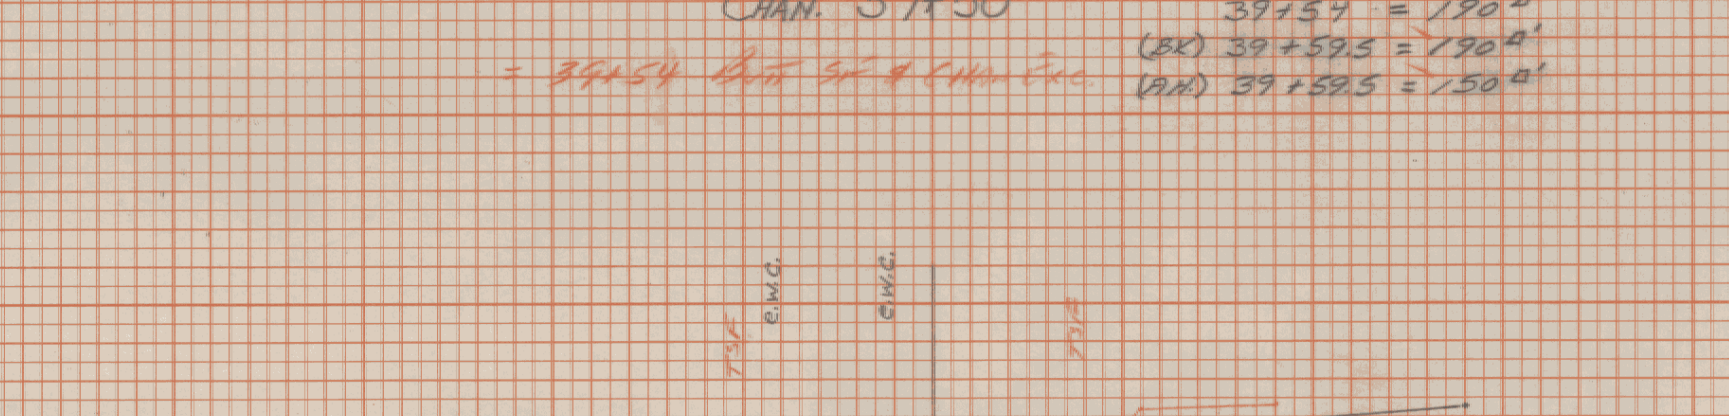
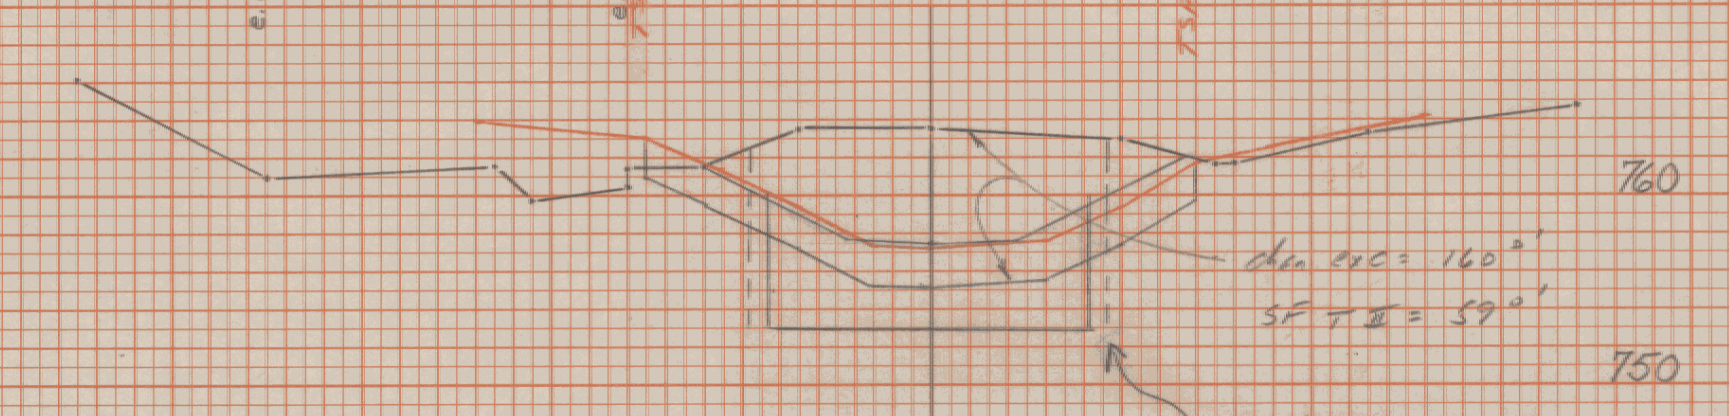
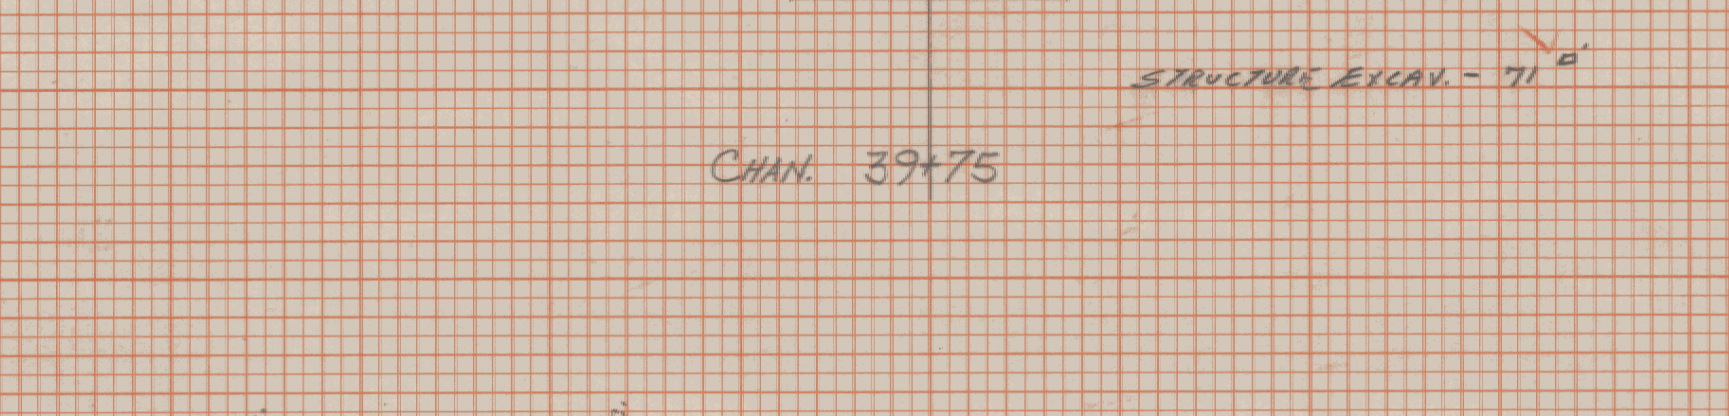
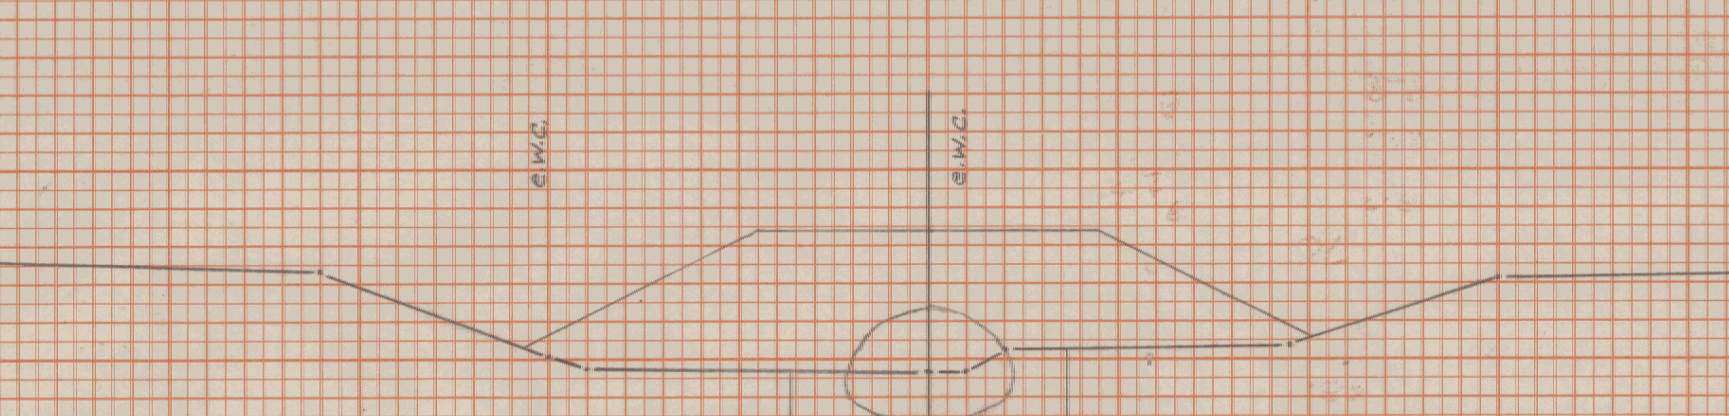
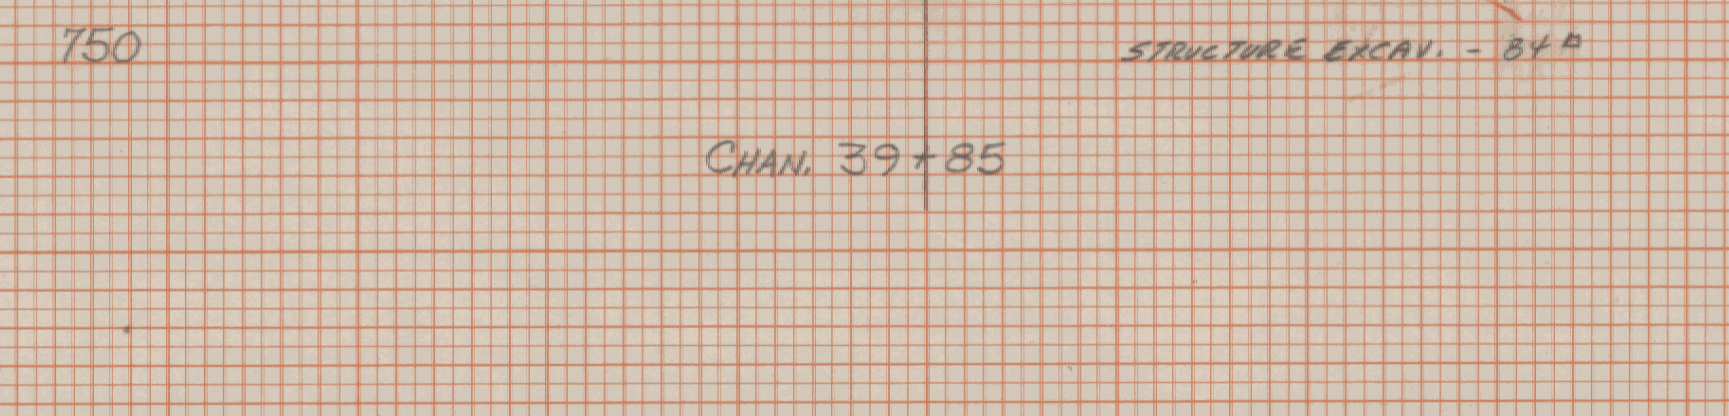


DATE
 BY
 SURVEY
 PLOTTED
 TEMPLATE
 AREA
 CHECKED
 NO.


DATE
 BY
 ORIGINAL
 SURVEY
 PLOTTED
 TEMPLATE
 AREA
 CHECKED
 NO.

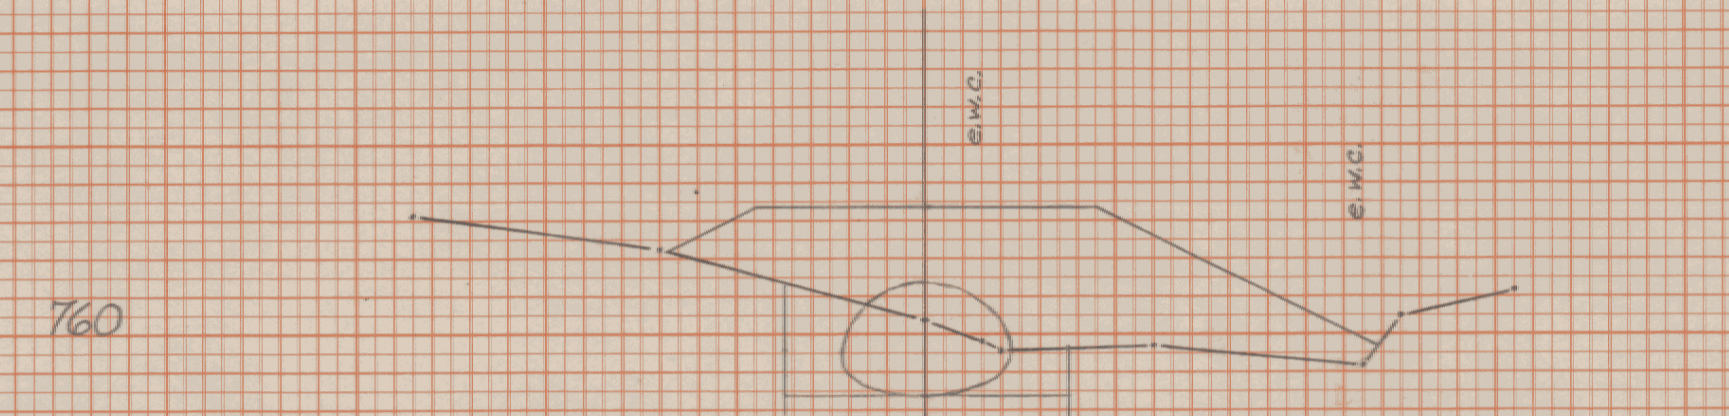

STRUCTURE EXCAVATION				Unit. Ho. Exc.			
STA.	DIST.	AREA	VOL.	STA.	DIST.	AREA	VOL.
39+54	5.5	190	38.70	39+15	10	57 (60)	21.1
39+59.5 (BK)		190		39+25	29	57	116.5
39+59.5 (PK)		150		39+54	29	150 (60)	
39+75	15.5	71	63.94	40+46	29	226	
39+85	10	84	88.70	40+75	25	128	188.0
40+00	15	165	69.17	41+00	25	54	82.4
40+25	25	180	158.72	41+25	25	0	35.0
40+25 (BK)		155	99.03				
40+25 (PK)		165					
40+46 (BK)	55	205	41.76				433.4
40+46							116.5
							21.1
							116.5
							21.1

GRANULAR BACKFILL FOR STRUCTURES
 (STATION 39+54 TO 40+46)
 CHAN. STA. 39+59.5 TO 40+40.5
 8" L x 15" x 2" 121' 70 CY
 11-6-51
 150
 Quoted to 21-23, P. 14

Stone Fill (Type II)			
STA.	DIST.	AREA	VOL.
39+15	10	85	13.0
39+15	29	35	34.4
39+54			
			47.4
			116.5
			116.5

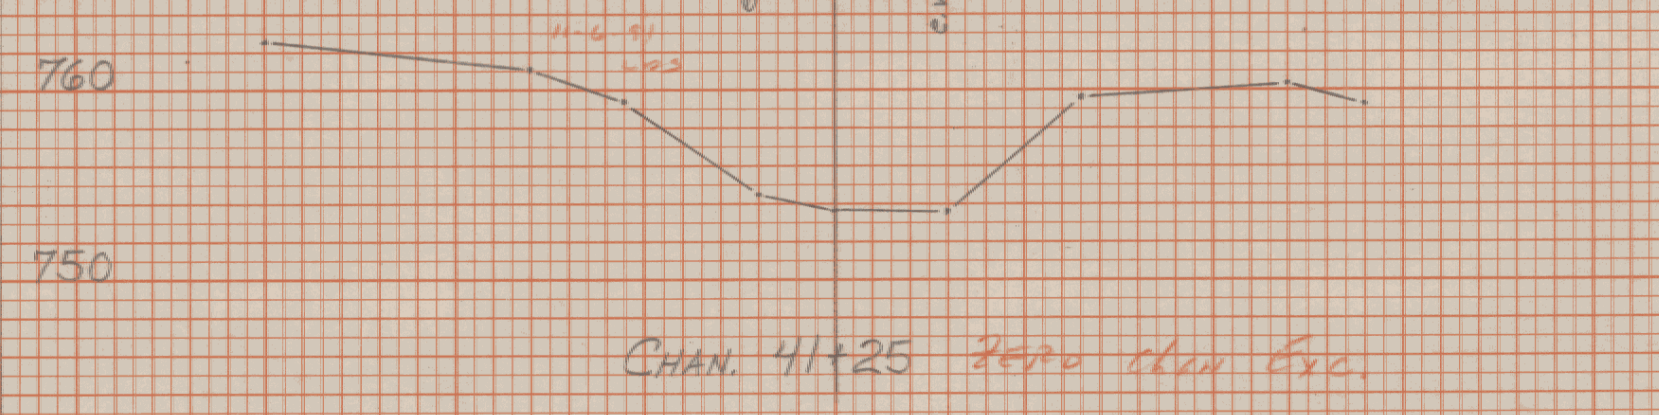

Stone Fill (Type III)			
STA.	DIST.	AREA	VOL.
40+46	29	65	69.8
40+75	25	65	54.2
41+00	25	54	24.1
41+25	25	0	0
			148.1
			116.5
			116.5

