

DATE: \_\_\_\_\_  
BY: \_\_\_\_\_  
NO. \_\_\_\_\_


FINAL SURVEY NOTE BOOK

NO. \_\_\_\_\_

DATE: \_\_\_\_\_  
BY: \_\_\_\_\_  
NO. \_\_\_\_\_

ORIGINAL SURVEY NOTE BOOK


NO. \_\_\_\_\_

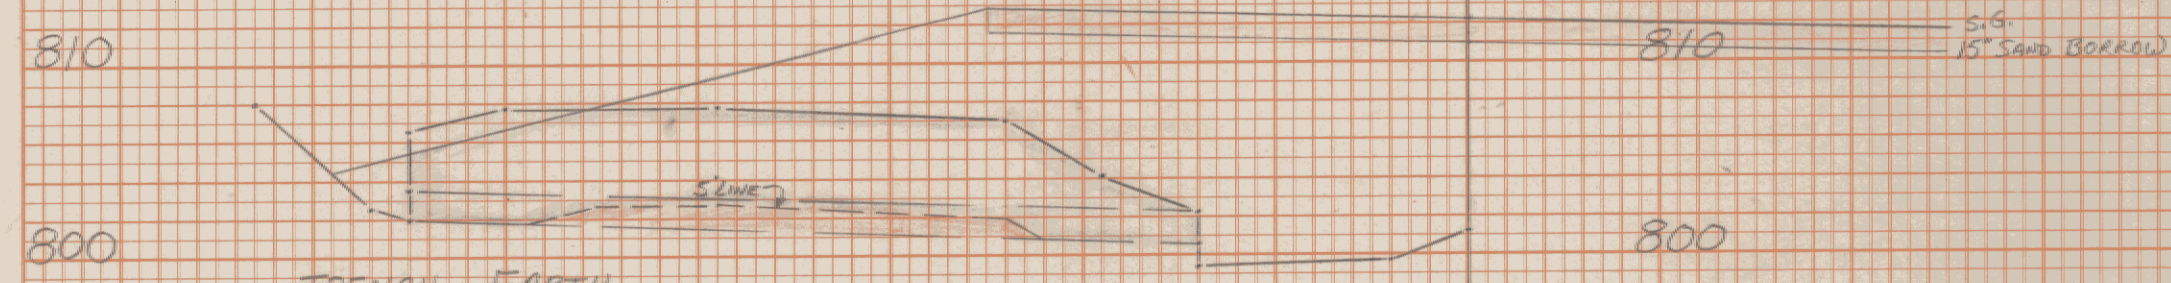

TRENCH EARTH  
O-S  
PIPE - 187' x 3.6' = 673.2 F<sup>3</sup>  
OVER S  
PIPE - 26' x 3.6' x 1.5' = 140.4 F<sup>3</sup>  
813.6 F<sup>3</sup> x 2.27 = 30.1 CY

224+13 @ 77'-37" LT.  
REMOVE 18" ACCGMP  
Book 2C Page 108 (DS 110)  
11-8-97 103


X

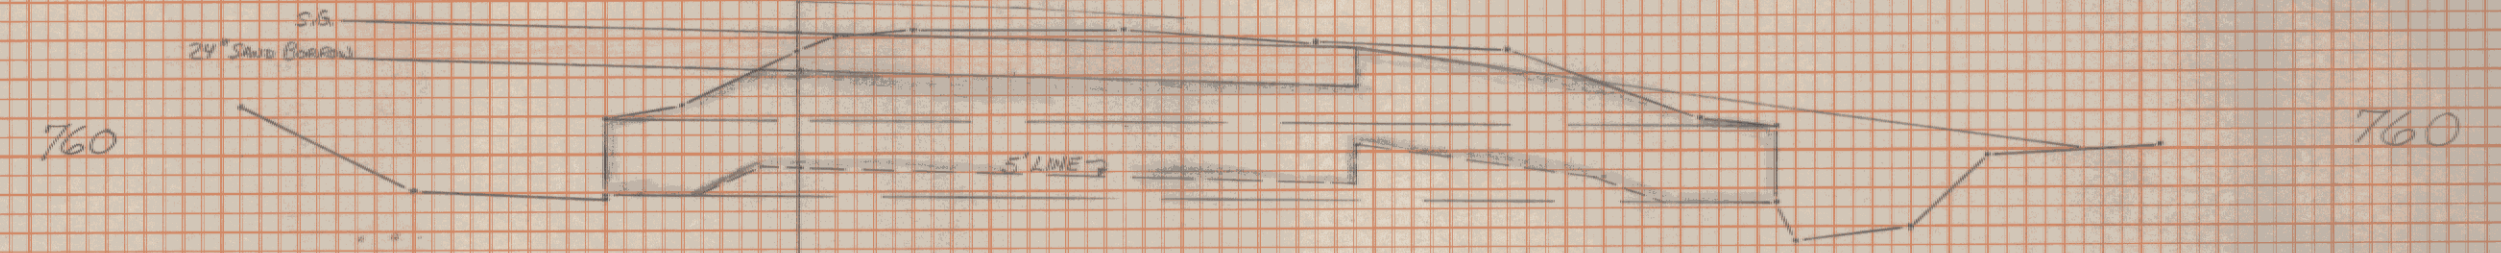

237+03 @ 61'-02" LT.  
REMOVE EXISTING 48" ACCGMP  
Book 2C Page 152

TRENCH EARTH  
O-S  
PIPE - 304' x 6.1' = 1854.4 F<sup>3</sup>  
OVER S  
PIPE - 74' x 6.1' x 1.5' = 677.1 F<sup>3</sup>  
2531.5 F<sup>3</sup> x 2.7 = 93.8 CY  
16-4-97 103


X

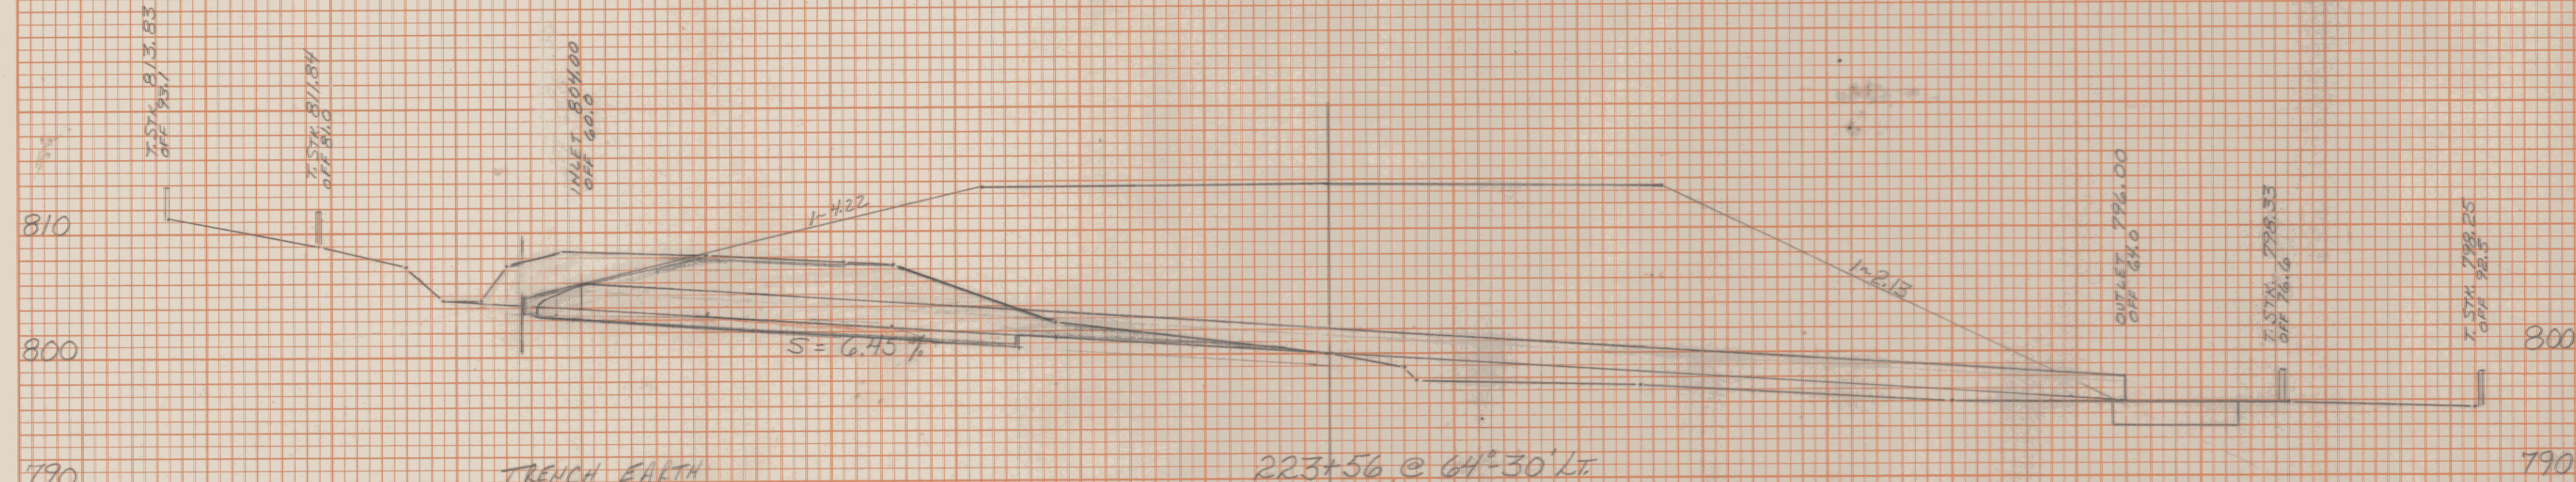

TRENCH EARTH  
10-S Pipe - 297' x 4.1 x 1/2 = 35.5 CY  
12-S Pipe - 38' x 4.1 x 1/2 x 2 = 11.5 CY  
10-S 10' x 8' x 12' x 1/2 = 5.9 CY  
Backfill for manholes  
38' x 4.1 = 5.4 CY  
STONE FILL  
11-8-97 103

223+56 @ 64'-30" LT.  
24" x 124" PCCSP (0.64) w/ES @ INLET  
Book 2C Page 96 (DS 108)

X

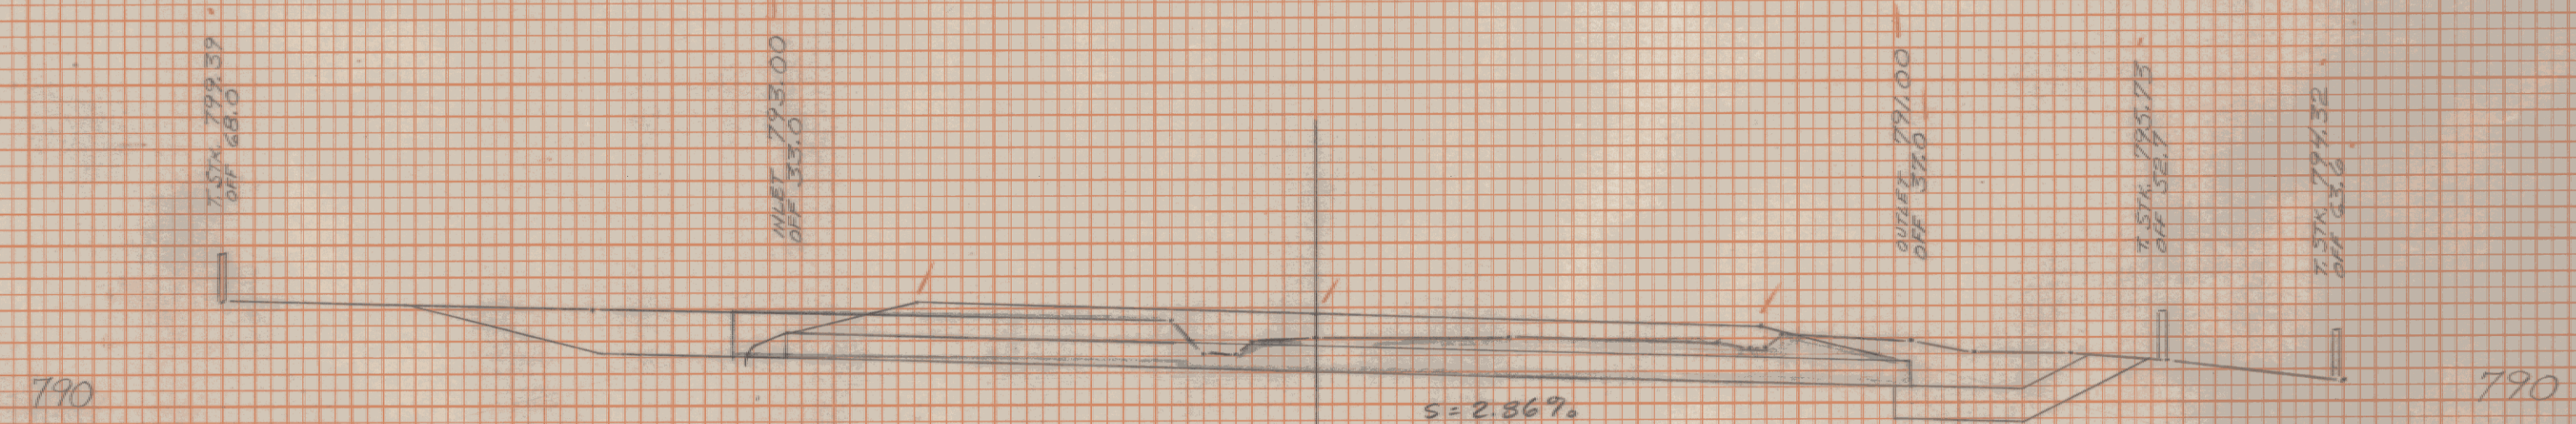

230+50 @ 90'  
18" x 70" PCCSP (0.64) w/ES @ INLET  
Book 2C Page 112 (DS 111)

PIPE DELETED PER R.E. DS

TRENCH EARTH  
O-S  
PIPE 172' x 3.6' x 1/2 = 22.9 CY

X

