


DATE _____ BY _____
 SURVEYED _____
 PLOTTED _____
 TEMPLATE _____
 NOTE BOOK _____
 NO. _____
 AREAS CHECKED _____

DATE _____ BY _____
 SURVEYED _____
 PLOTTED _____
 TEMPLATE _____
 NOTE BOOK _____
 NO. _____
 AREAS CHECKED _____

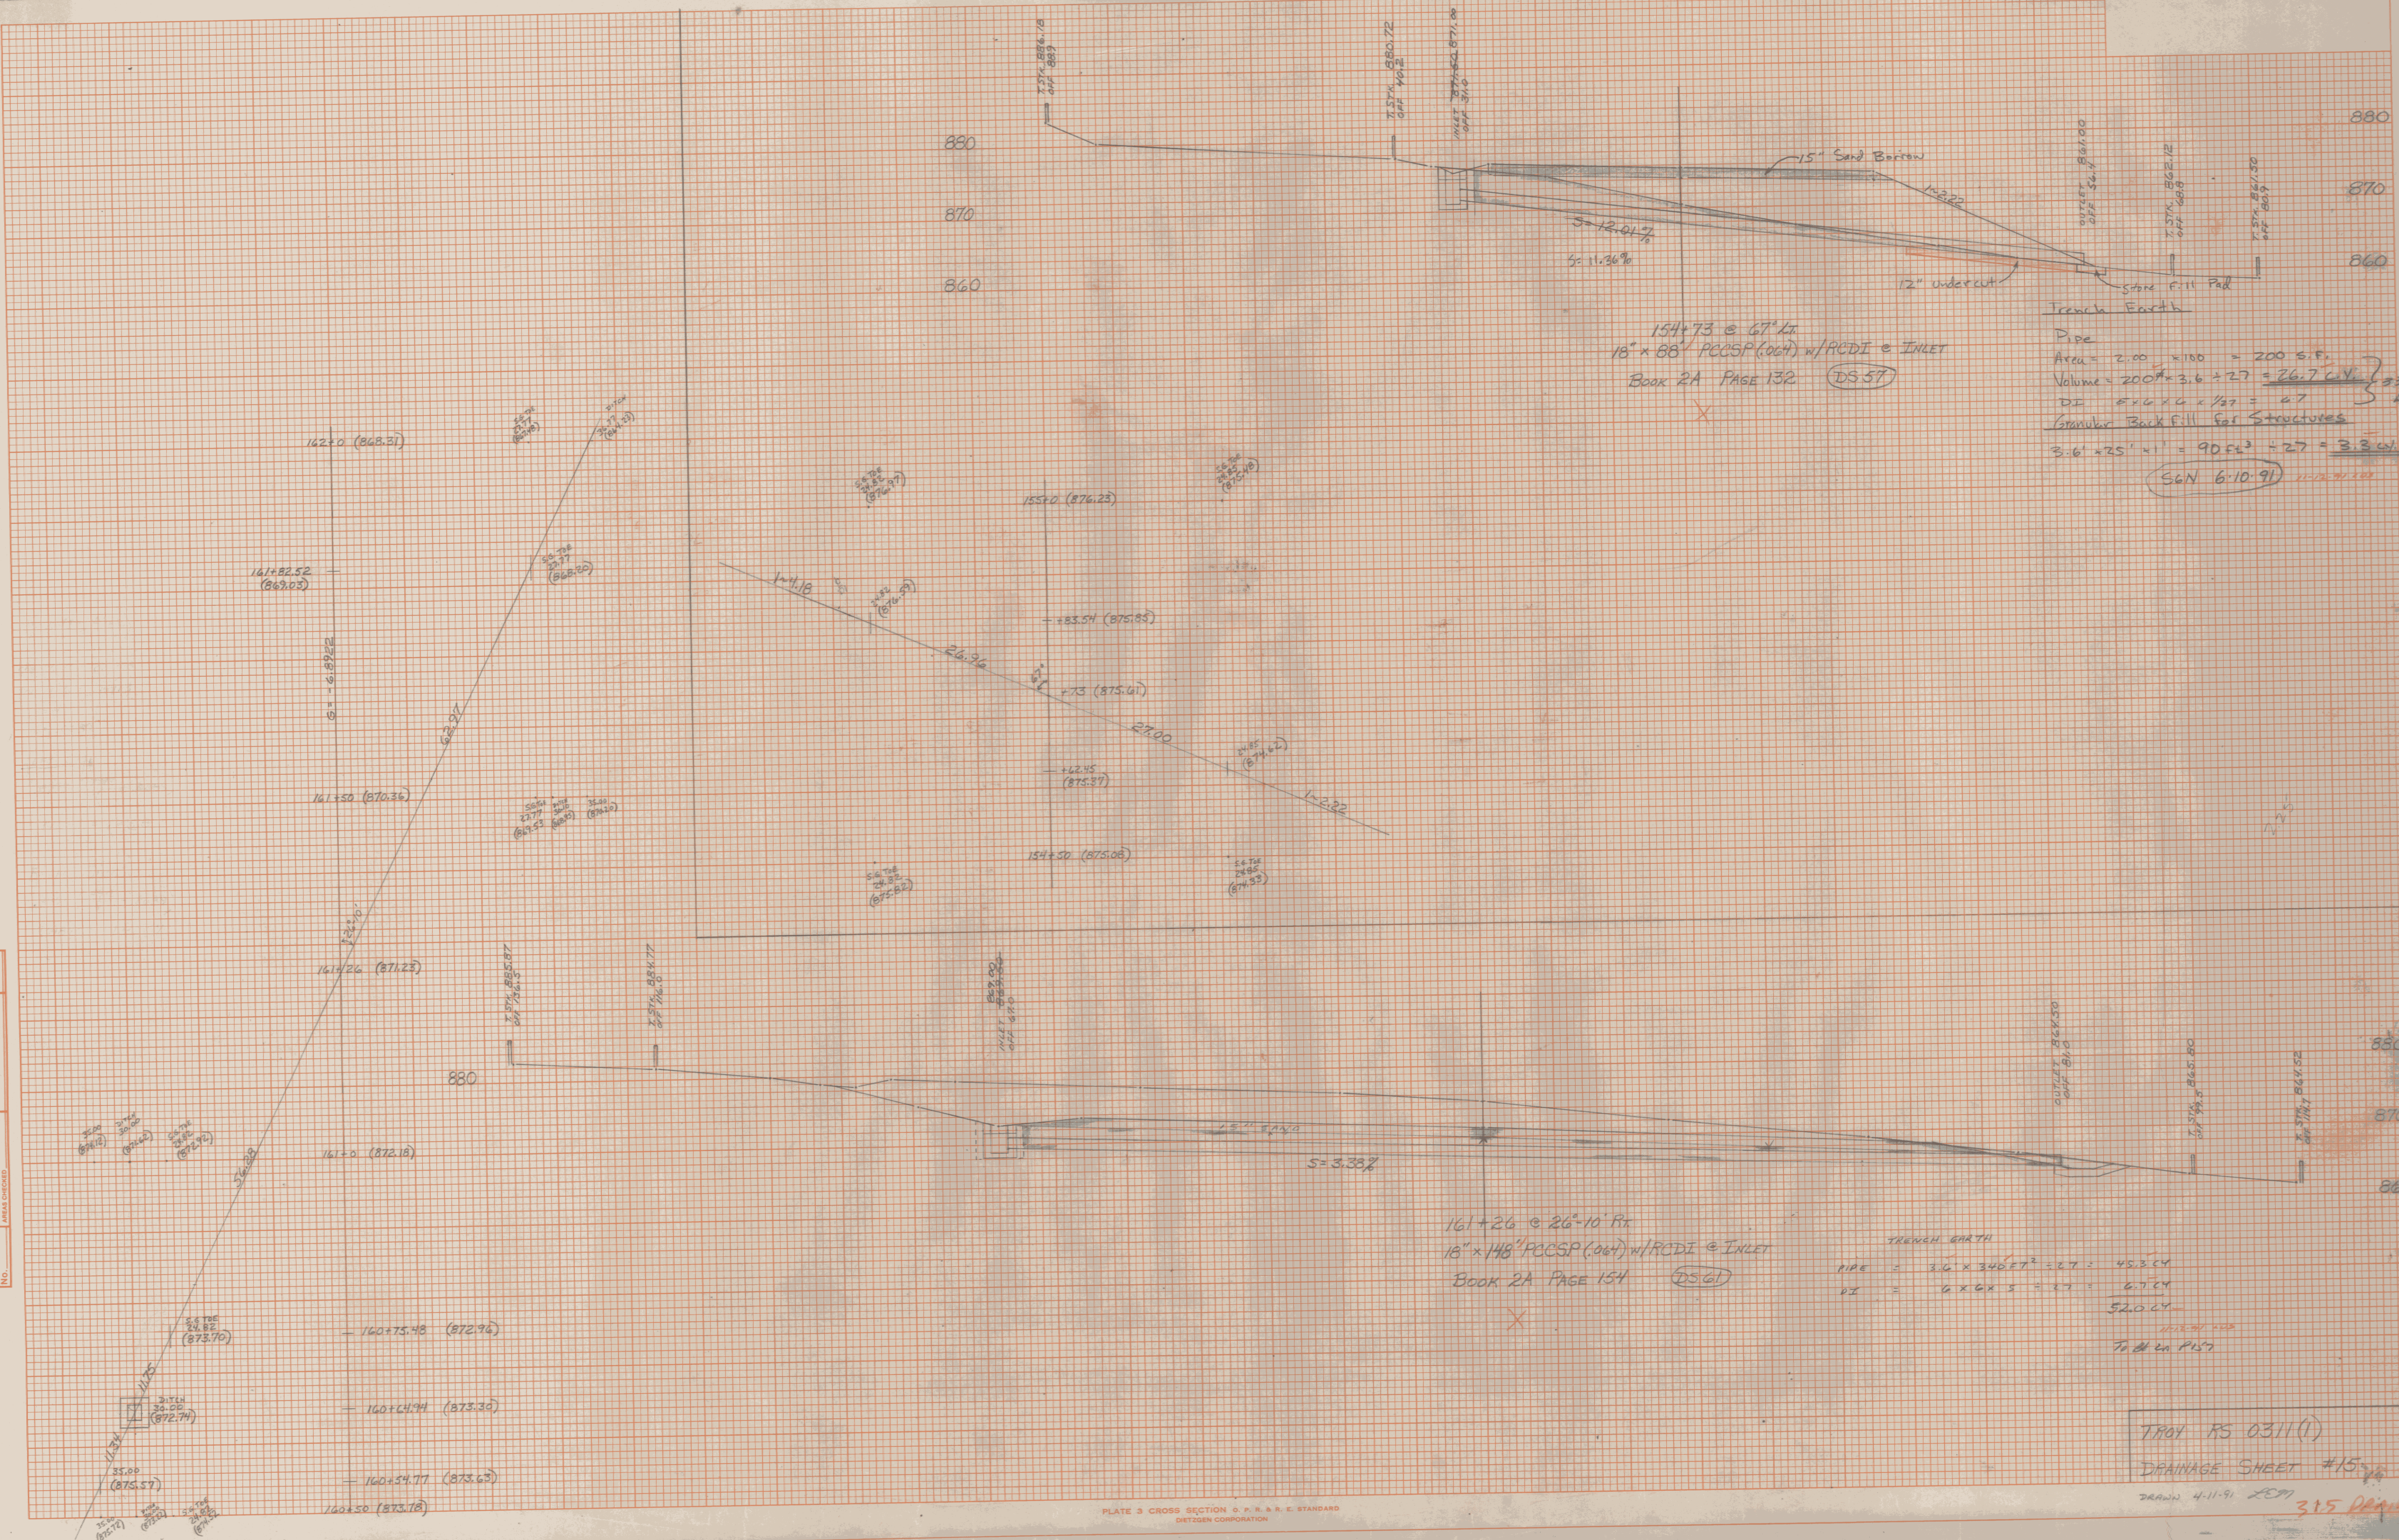

154+73 @ 67' Lx
 18" x 88" PCCSP (.064) w/ RCDI @ INLET
 BOOK 2A PAGE 132 (DS 57)

Trench Earth
 Pipe
 Area = 2.00 x 150 = 200 s.f.
 Volume = 200 x 3.6 ÷ 27 = 26.7 cu yd
 DT = 5' x 6' x 6' ÷ 27 = 6.7
 Granular Back Fill for Structures
 3.6' x 25' x 1' = 90 cu' ÷ 27 = 3.3 cu'
 (SGN 6.10.91)

161+26 @ 26'-10" Rr
 18" x 148" PCCSP (.064) w/ RCDI @ INLET
 BOOK 2A PAGE 154 (DS 61)

TRENCH EARTH
 PIPE = 3.6 x 346 FT² = 27 = 45.2 CY
 DT = 6 x 6 x 5 = 27 = 6.7 CY
 52.0 CY
 11/18/91
 To be in P157

T101 RS 0311(1)
 DRAINAGE SHEET #15
 DRAWN 4-11-91 LEM
 3.15