



DATE
BY
FINAL SURVEY
NO. DATE
BY
FINAL SURVEY
NO. DATE
BY
FINAL SURVEY
NO. DATE


DATE
BY
FINAL SURVEY
NO. DATE
BY
FINAL SURVEY
NO. DATE
BY
FINAL SURVEY
NO. DATE

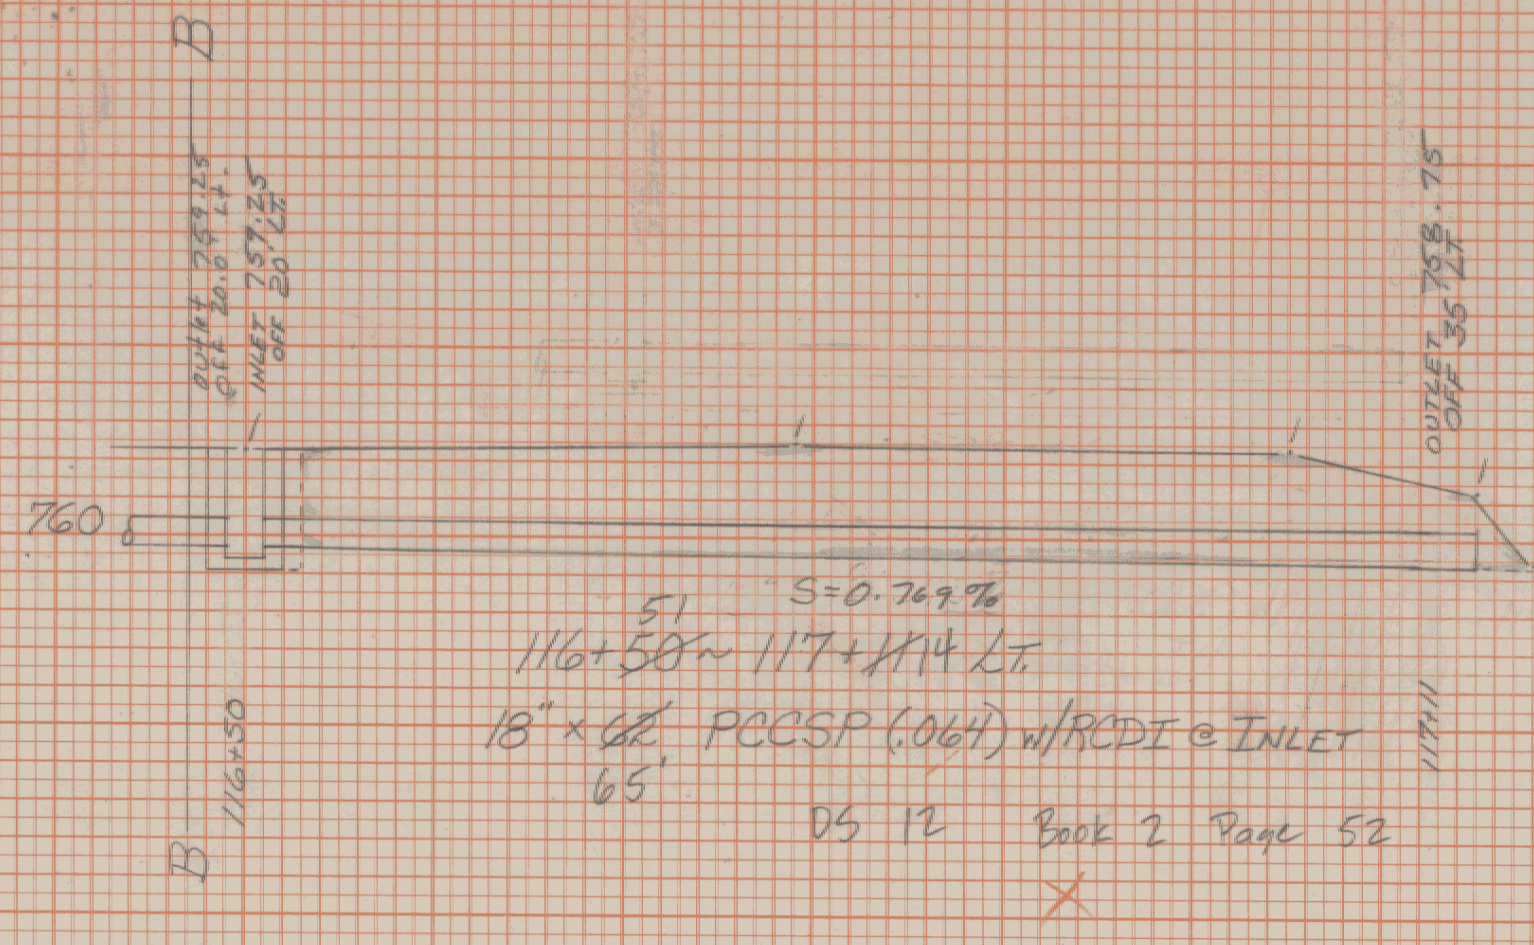

TRENCH EARTH
 PIPE 25.5 FT x 3.6 = 27 = 47.3 c.y.
 D.I. 6' x 6' x 5' = 27 = 37 c.y.
 D.I. 6' x 6' x 1.5' x 1.5' x 1.5' = 3.0 c.y.
 TOTAL TRENCH EARTH = 87.3 c.y.
 S.G.N. 7-22-91

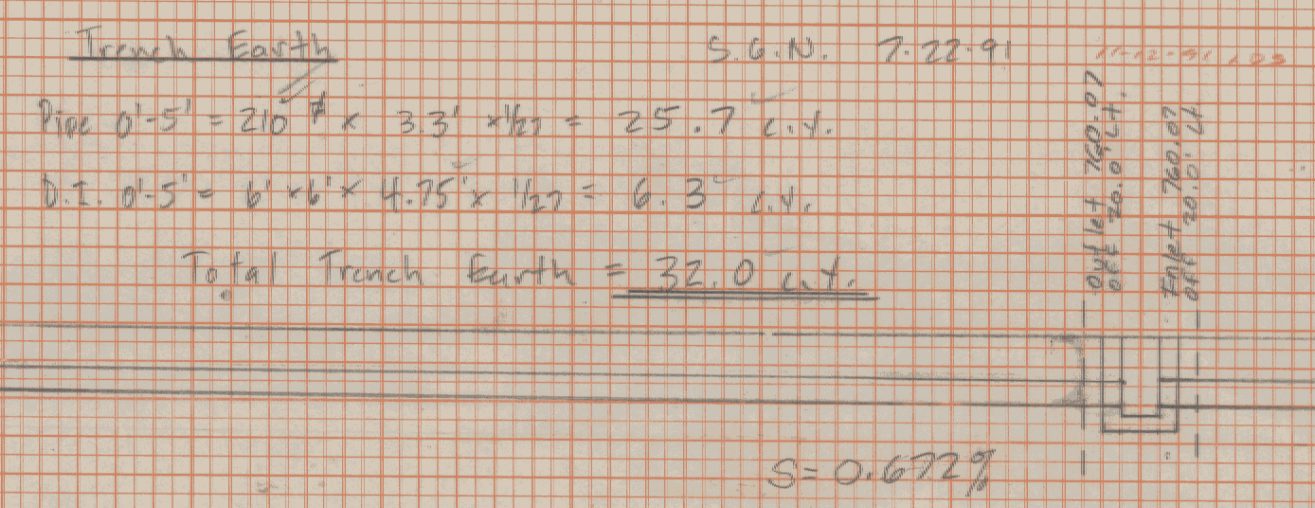

Trench Earth
 Pipe 0'-5' = 527 ft x 3.3' x 1/2 = 76.7 c.y.
 D.I. 0'-5' = 6' x 6' x 5' x 1/2 = 6.7 c.y.
 Total Trench Earth = 83.4 c.y.
 S.G.N. 7-22-91

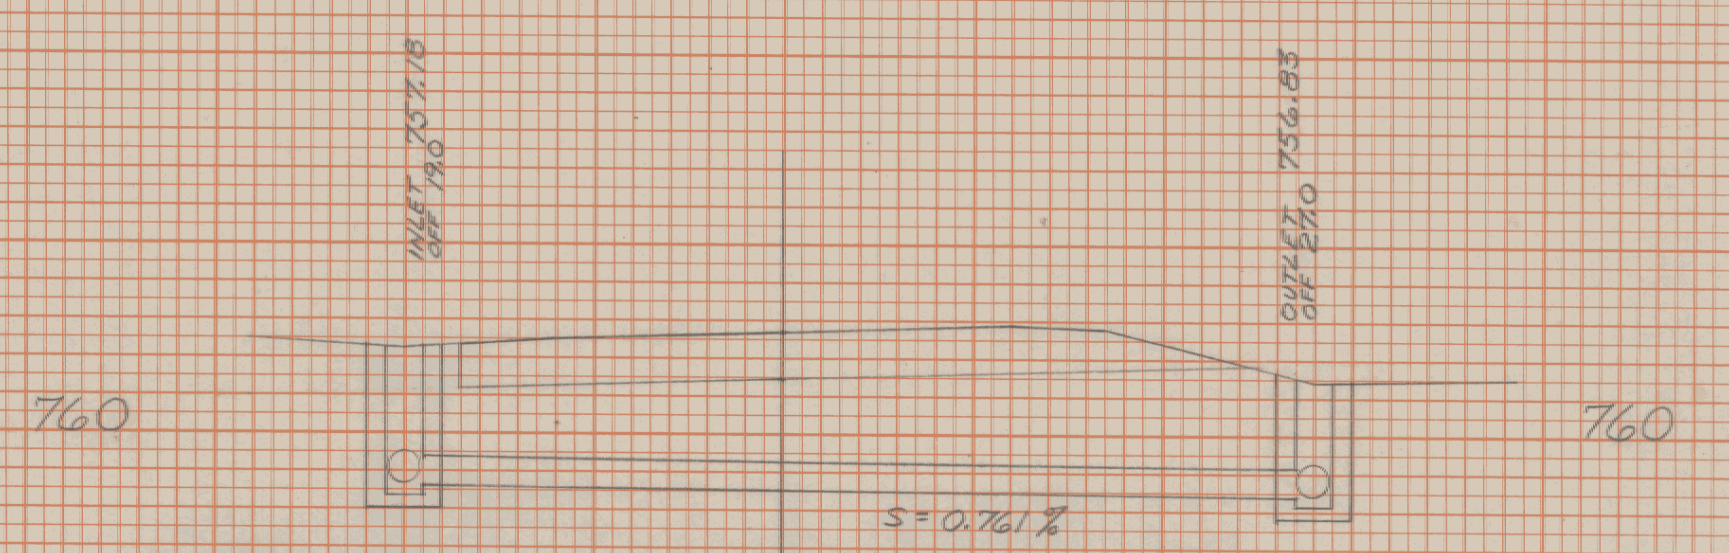

116+50 Lt-Rt
 18" x 16" RCP Cl. III w/RCDI @ INLET
 Book 2, Page 50 (DS 12)
 VOID 5/15/91
 Pipe Eliminated

114+50 ~ 115+14 Lt.
 18" x 16" RCP Cl. III w/RCDI @ INLET
 CONNECT CELLAR DRAIN TO D.I.
 Book 2, Page 30 (DS 07)

115+14 ~ 116+50 Lt.
 18" x 16" RCP Cl. III w/RCDI @ INLET
 Book 2, Page 43 (DS 10)

Trench Earth
 Pipe 0'-5' = 292 ft x 3.3' x 1/2 = 35.7 c.y.
 D.I. 0'-5' = 6' x 6' x 4.5' x 1/2 = 6.0 c.y.
 Total Trench Earth = 41.7 c.y.

Pipe Eliminated
 111+91 ~ 112+50 Lt.
 18" x 58" RCP Cl. III w/RCDI @ INLET
 Book 2F, Page 134 (DS 301)
 ASSISTED
 REDESIGNED
 VOID 5/15/91

Pipe Eliminated
 112+50 ~ 113+58 Lt.
 18" x 106" RCP Cl. III w/RCDI @ INLET
 Book 2, Page 6 (DS 01)
 VOID 5/15/91

113+58 ~ 114+53 Lt.
 18" x 94" RCP Cl. III w/RCDI @ INLET
 Book 2, Page 18 (DS 01)
 Connect Cellar Drain to D.I.

TROY HS 0311(1)
 DRAINAGE SHEET # 18

3/8 PRAIN