


FINAL SURVEY NOTE BOOK No. _____
 SURVEYED BY _____
 PLOTTED BY _____
 DATE _____

ORIGINAL SURVEY NOTE BOOK No. _____
 SURVEYED BY _____
 PLOTTED BY _____
 DATE _____

800
790
780

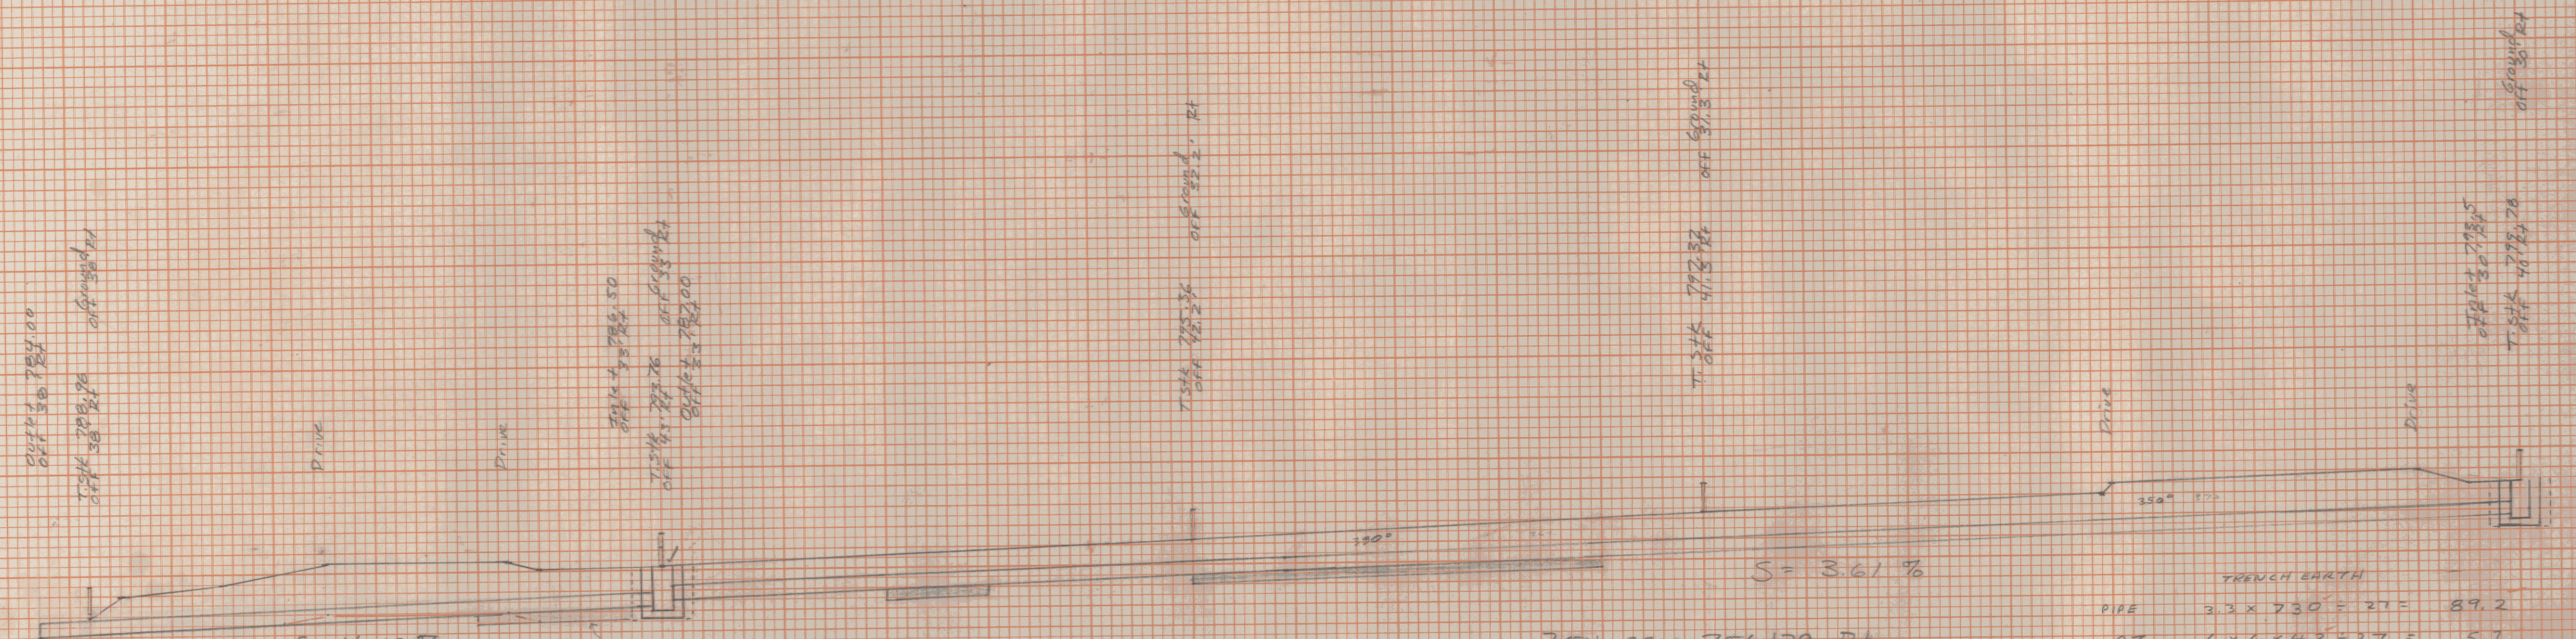

S = 4.17%
 254+37 ~ 254+97 Rt.
 New 15" x 180" CSP (.064)
 W/RCDI @ Inlet + Stone Fill
 Type I @ Outlet
 Book 2D Page 9B
 DS 135

254+99 ~ 256+79 Rt.
 New 15" x 180" CSP (.064)
 W/RCDI @ Inlet
 Book 2D Page 11D
 DS 137

TRENCH EARTH

D.F. PIPE	2.3' x 270' = 27'	30.3 CY
OVER-S	3.3' x 12' x 1.5' = 27'	2.2 CY
DI. S	6' x 6' x 5' = 27'	6.7
Tot. = 39.2 CY		

GRANULAR BACKFILL FOR STRUCT.

UNDERCUT	10' x 3.3' x 1.0' = 27'	1.2 CY
----------	-------------------------	--------

TRENCH EARTH

PIPE	3.3' x 730' = 27'	89.2
DI.	6' x 6' x 4.3' = 27'	5.7
Tot. = 94.9 CY		9-18-91

GRANULAR BACKFILL FOR STRUCTURES

PIPE UNDERCUT	50' x 1.0' x 3.3' = 27'	6.1 CY
---------------	-------------------------	--------

TROY RS 0311(C)
 DRAINAGE SHEET #
 251A

325A DRAIN