


FINAL SURVEY NOTE BOOK No. _____
 SURVEYED BY _____
 DATE _____

ORIGINAL SURVEY NOTE BOOK No. _____
 SURVEYED BY _____
 DATE _____

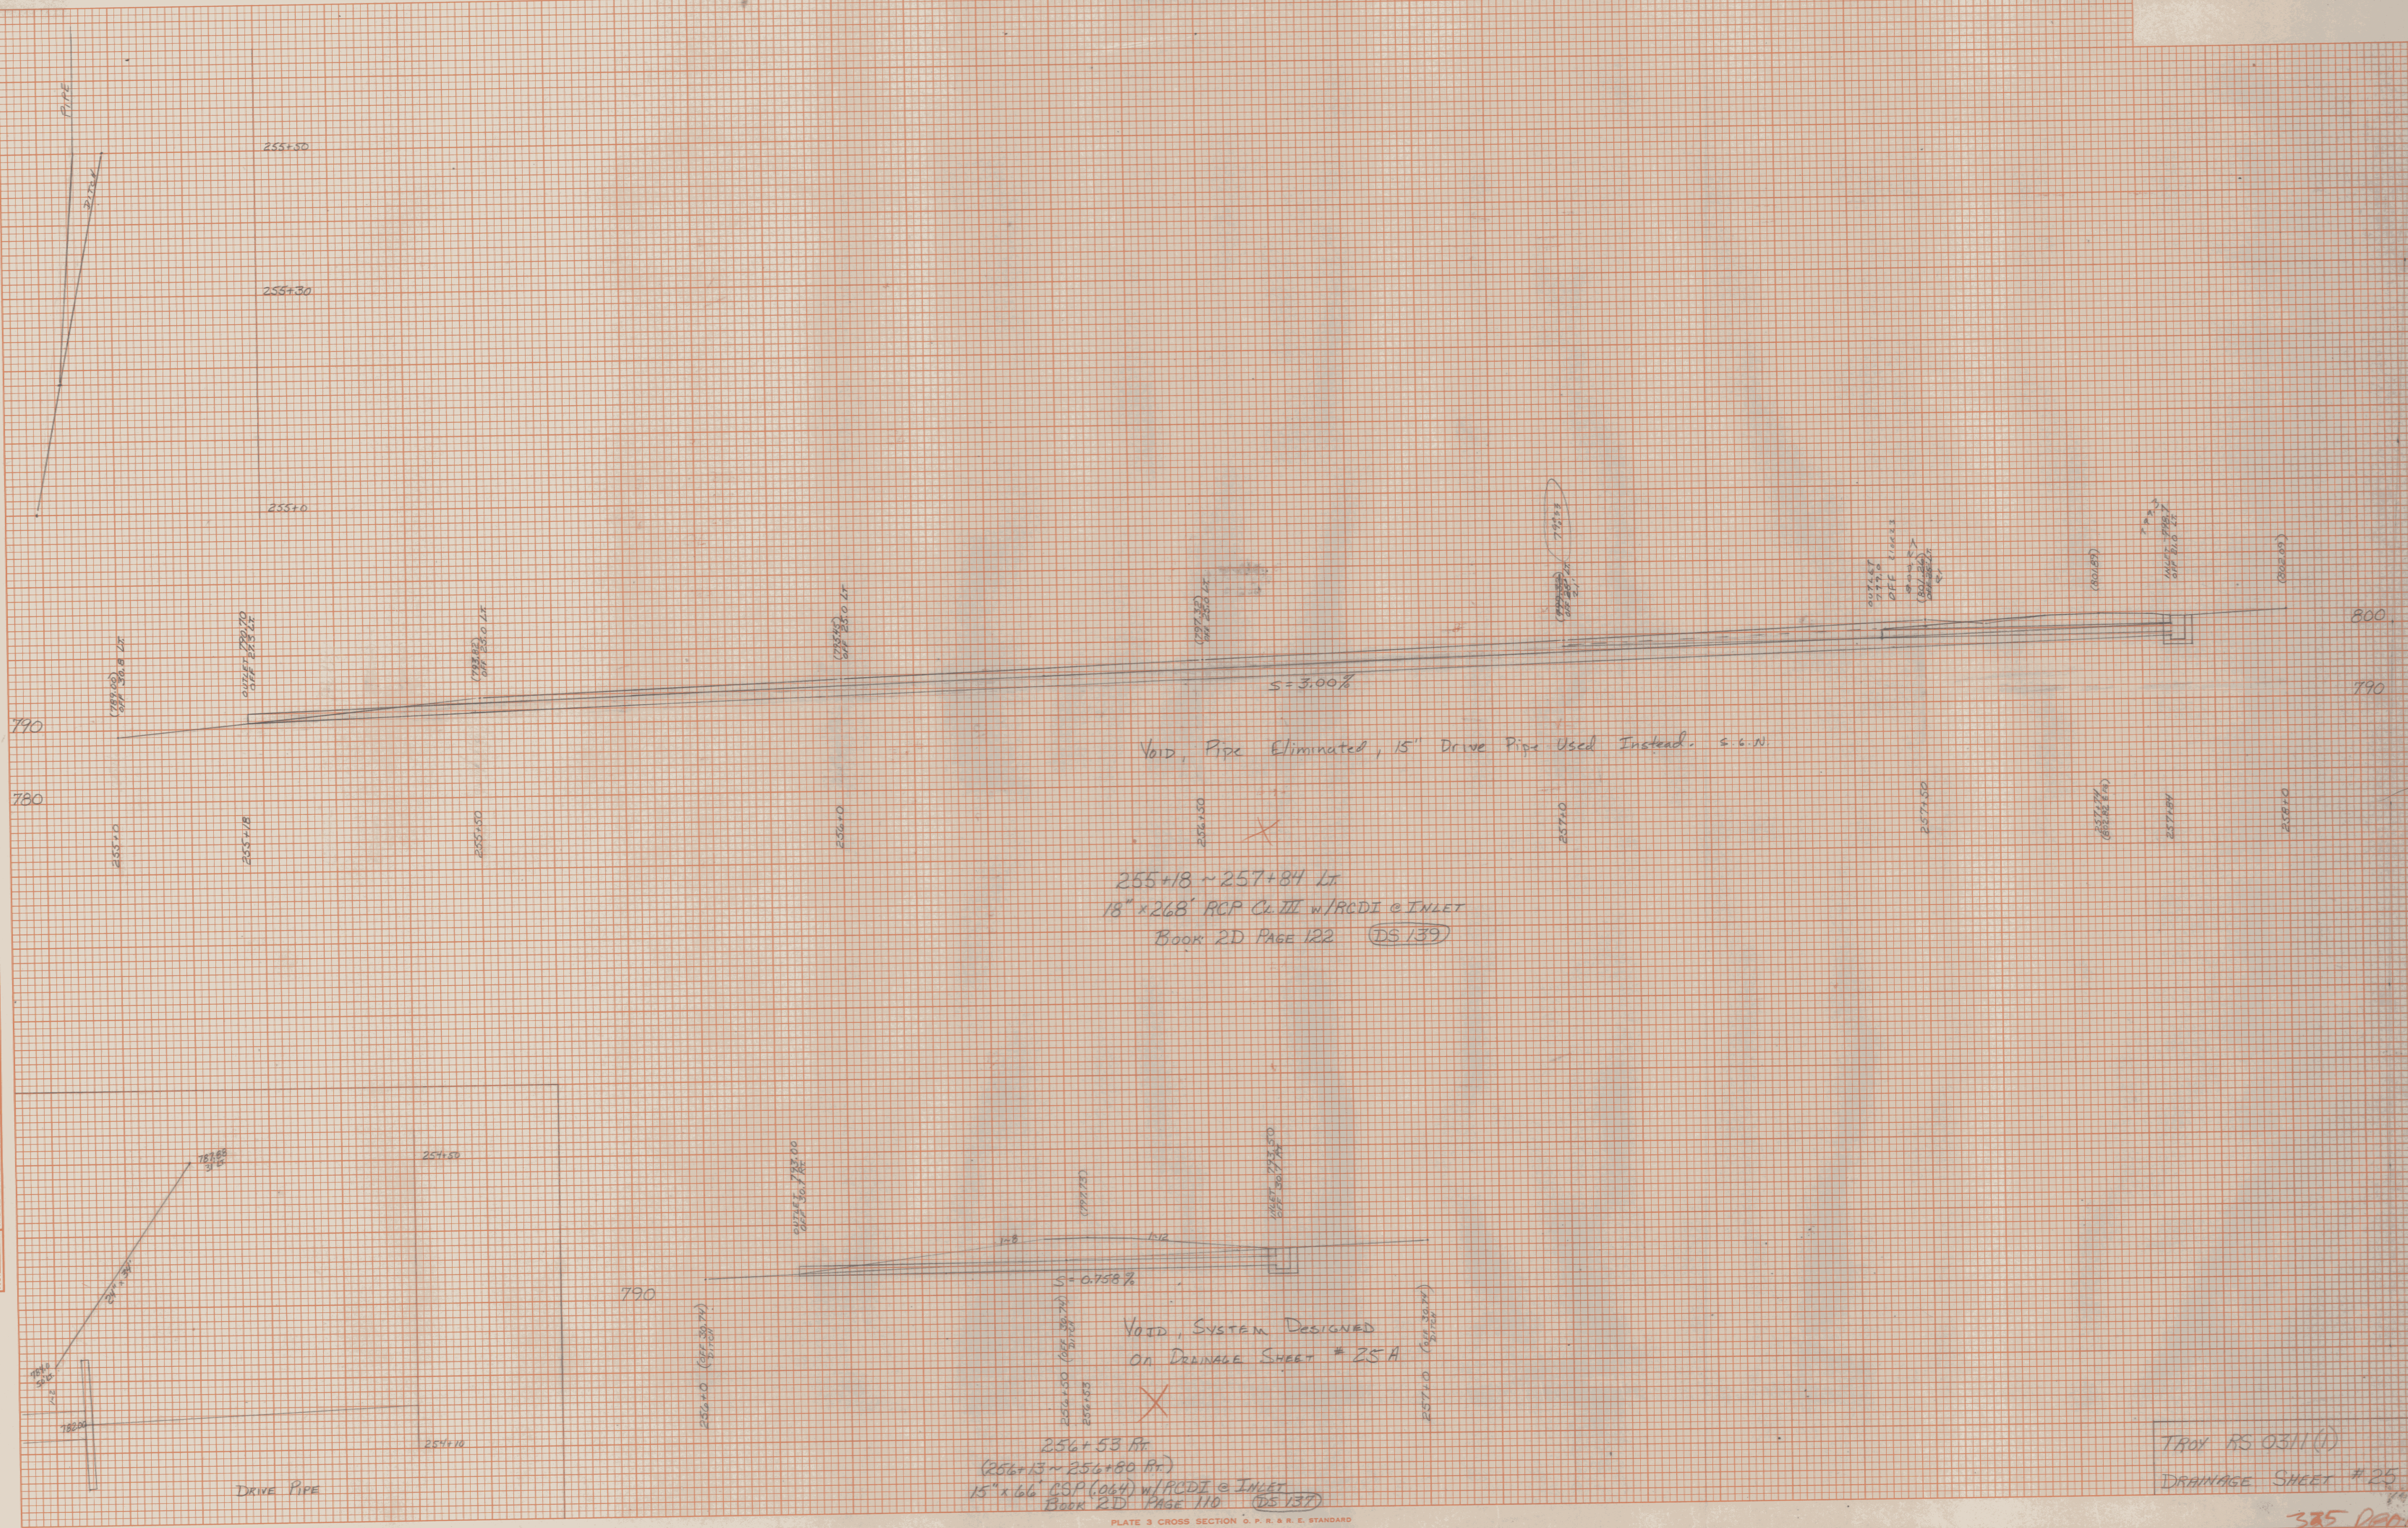

VOID, PIPE ELIMINATED, 15" DRIVE PIPE USED INSTEAD. S=6.0%

255+18 ~ 257+84 LT
 18" x 268' RCP CL. III w/PCDI @ INLET
 BOOK 2D PAGE 122 (DS 139)

VOID, SYSTEM DESIGNED ON DRAINAGE SHEET # 25A

256+53 FT
 (256+13 ~ 256+80 FT)
 15" x 66' CSP (064) w/PCDI @ INLET
 BOOK 2D PAGE 110 (DS 137)

TRAY RS 0311(1)
 DRAINAGE SHEET # 25

385 P.D.M.