


DATE _____ BY _____
 REVISIONS
 NO. _____
 ORIGINAL SURVEY
 PLOTTED _____
 NOTE BOOK _____
 NO. _____

DATE _____ BY _____
 REVISIONS
 NO. _____
 ORIGINAL SURVEY
 PLOTTED _____
 NOTE BOOK _____
 NO. _____

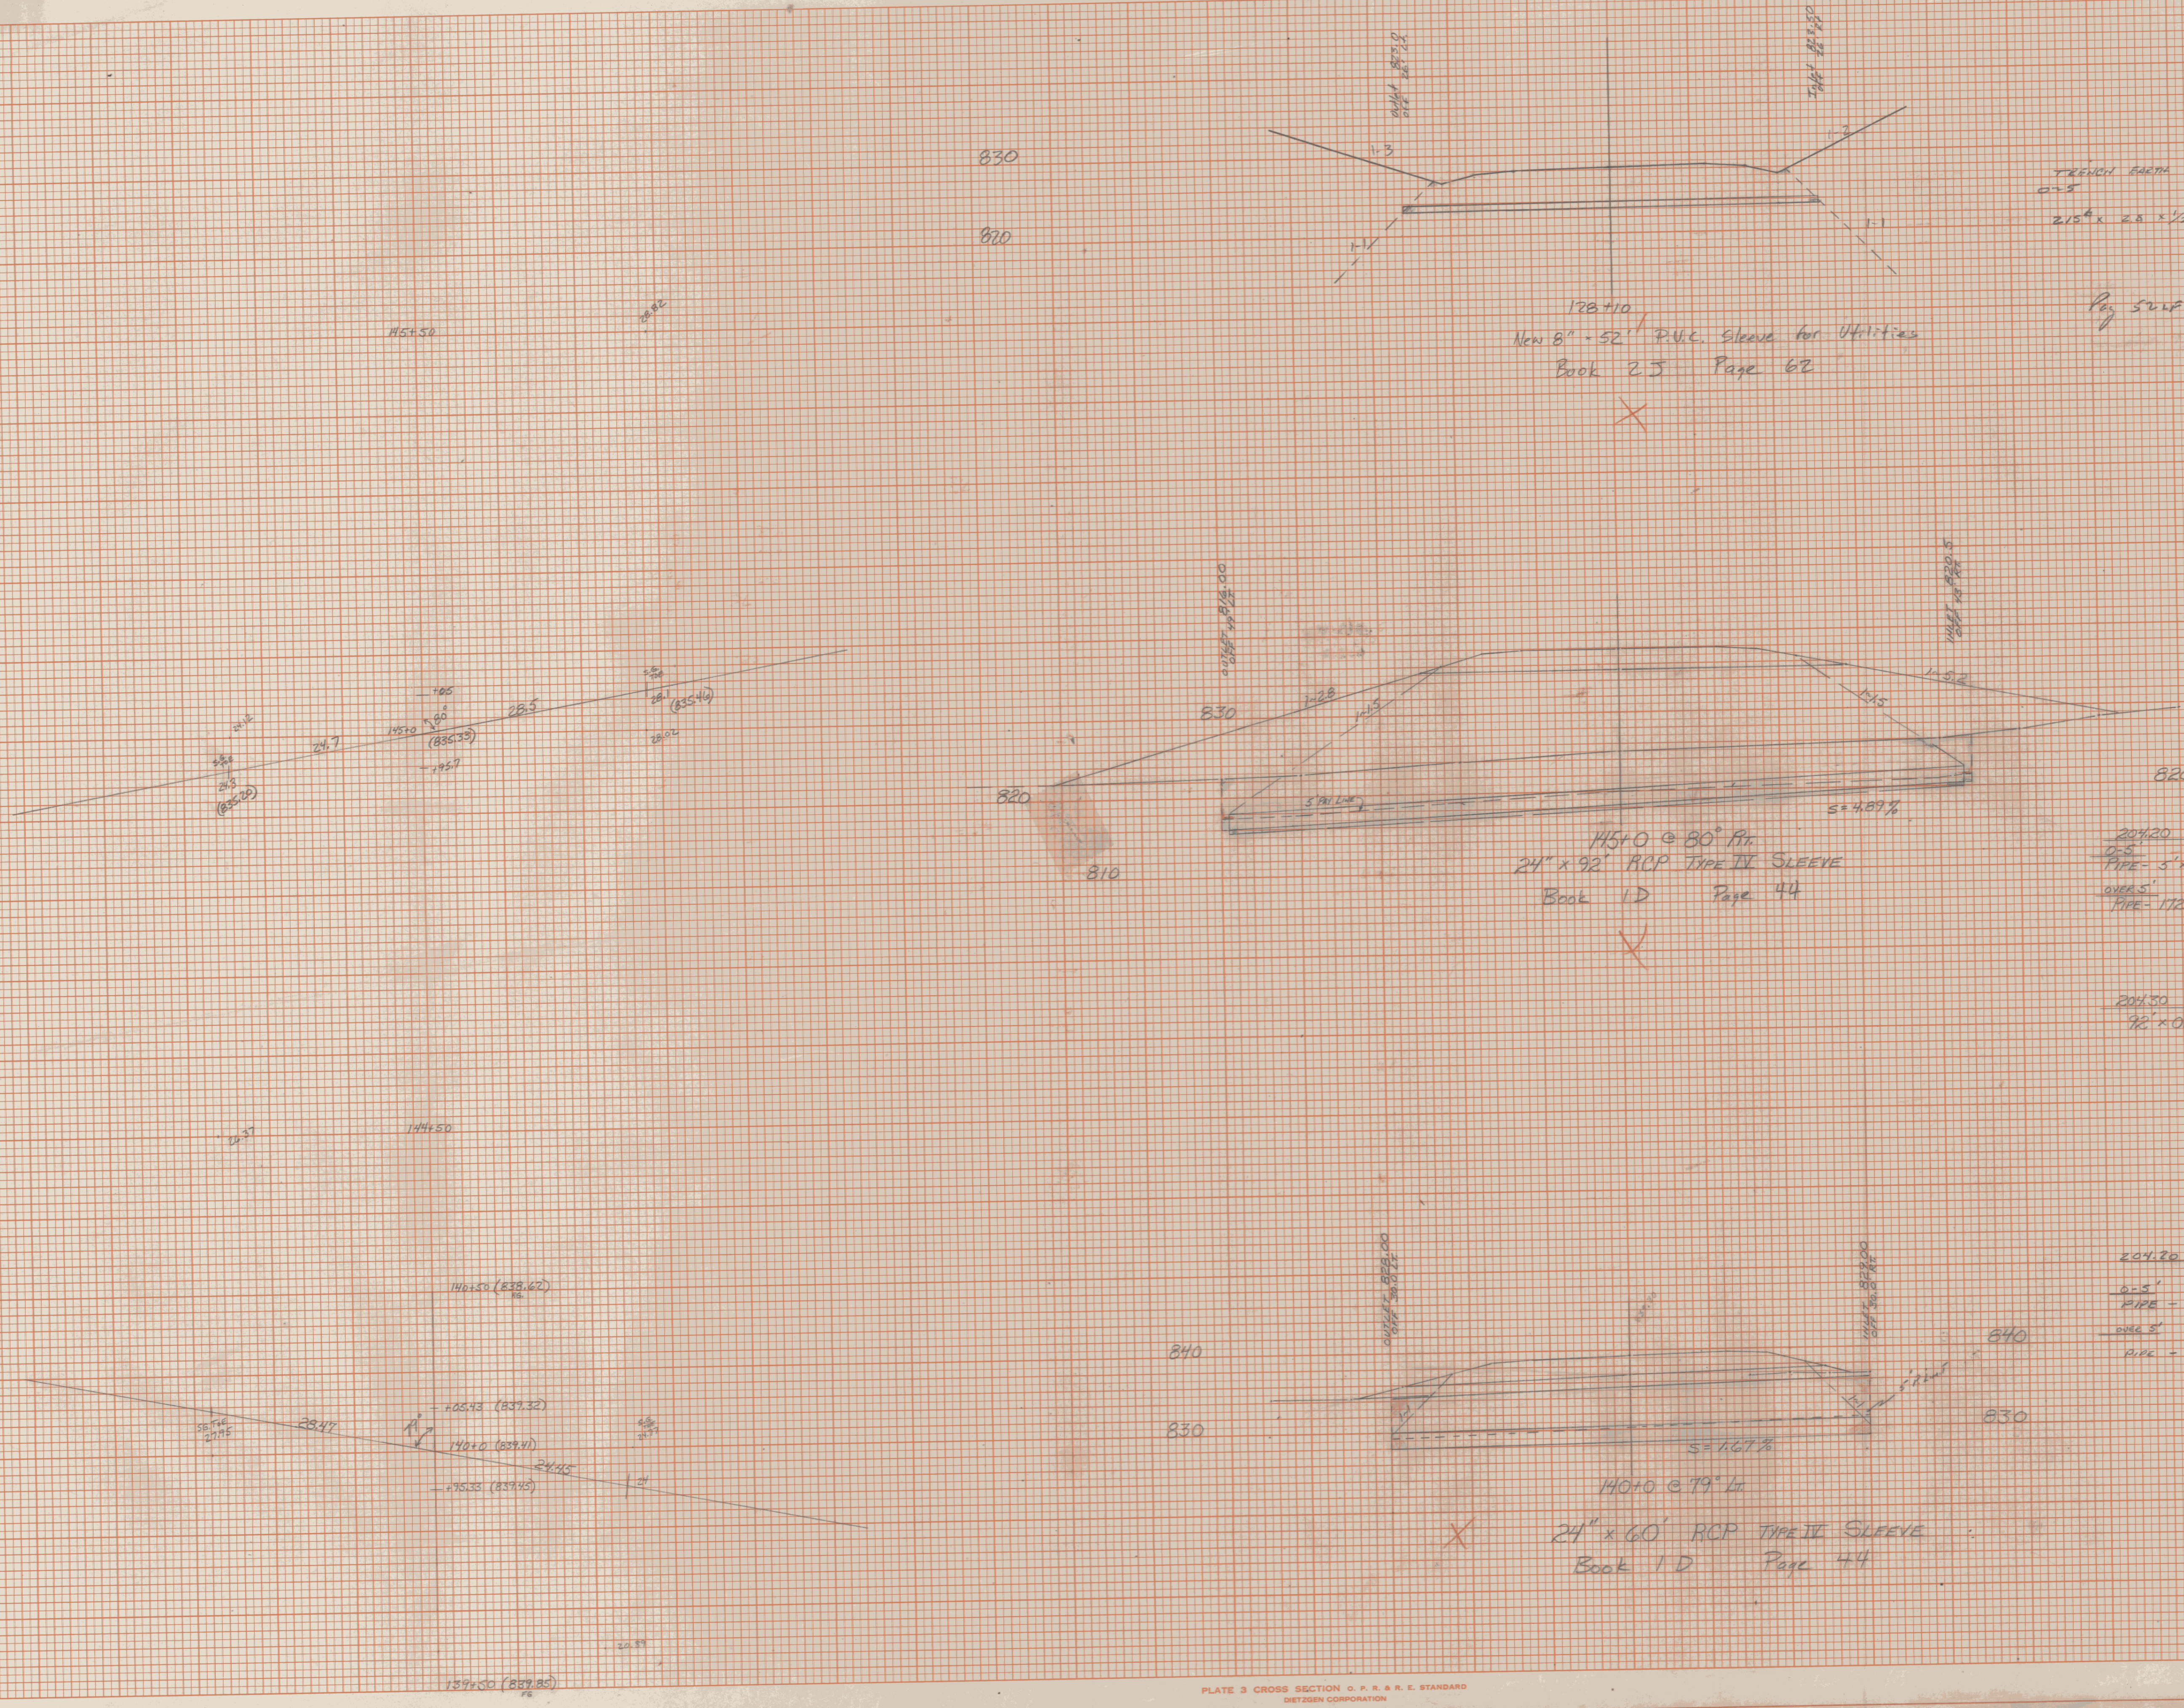

TRENCH EARTH
 0-5
 $215' \times 2.5 \times 1/2 = 223.3 \text{ cy}$
 12-22-91
 Pgs 50-51 ITEM 670.21A
 TO BK 25 PG 6

20420 TRENCH EARTH
 0-5
 PIPE - $5' \times 74' \times 4.5' = 2115 \text{ ft}^3$
 OVER 5'
 PIPE - $112' \times 4.5' \times 1.5' = 1161 \text{ ft}^3$
 TOTAL = $3276 \text{ ft}^3 \div 27 = 121.3 \text{ cy}$
 11-14-91
 TO BK 10 P10

20430 GRAIN BINS FOR STRUCTURES
 $92' \times 0.5' \times 4.5' \times 1/2 = 207 \text{ ft}^3$
 TO BK 10 P44

20420 TRENCH EARTH
 0-5
 PIPE - $5' \times 60' \times 4.5' = 1350 \text{ ft}^3$
 OVER 5'
 PIPE - $102' \times 4.5' \times 1.5' = 709 \text{ ft}^3$
 TOTAL = $2059 \text{ ft}^3 \div 27 = 76.2 \text{ cy}$
 1-12-92
 TO BK 10 P10

128+10
 New 8" x 52' P.V.C. Sleeve for Utilities
 Book 23 Page 62

115+0 @ 80' P.P.
 24" x 92' RCP TYPE IV SLEEVE
 Book 10 Page 44

140+0 @ 79' L.L.
 24" x 60' RCP TYPE II SLEEVE
 Book 10 Page 44

TROY RS 0311(1)
 DRAINAGE SHEET #26

326 DRAIN