

FINAL SURVEY NOTE BOOK No. _____


SUBMITTED BY DATE

TRIMLINE AREA CHECKED

ORIGINAL SURVEY NOTE BOOK No. _____

SUBMITTED BY DATE

TRIMLINE AREA CHECKED

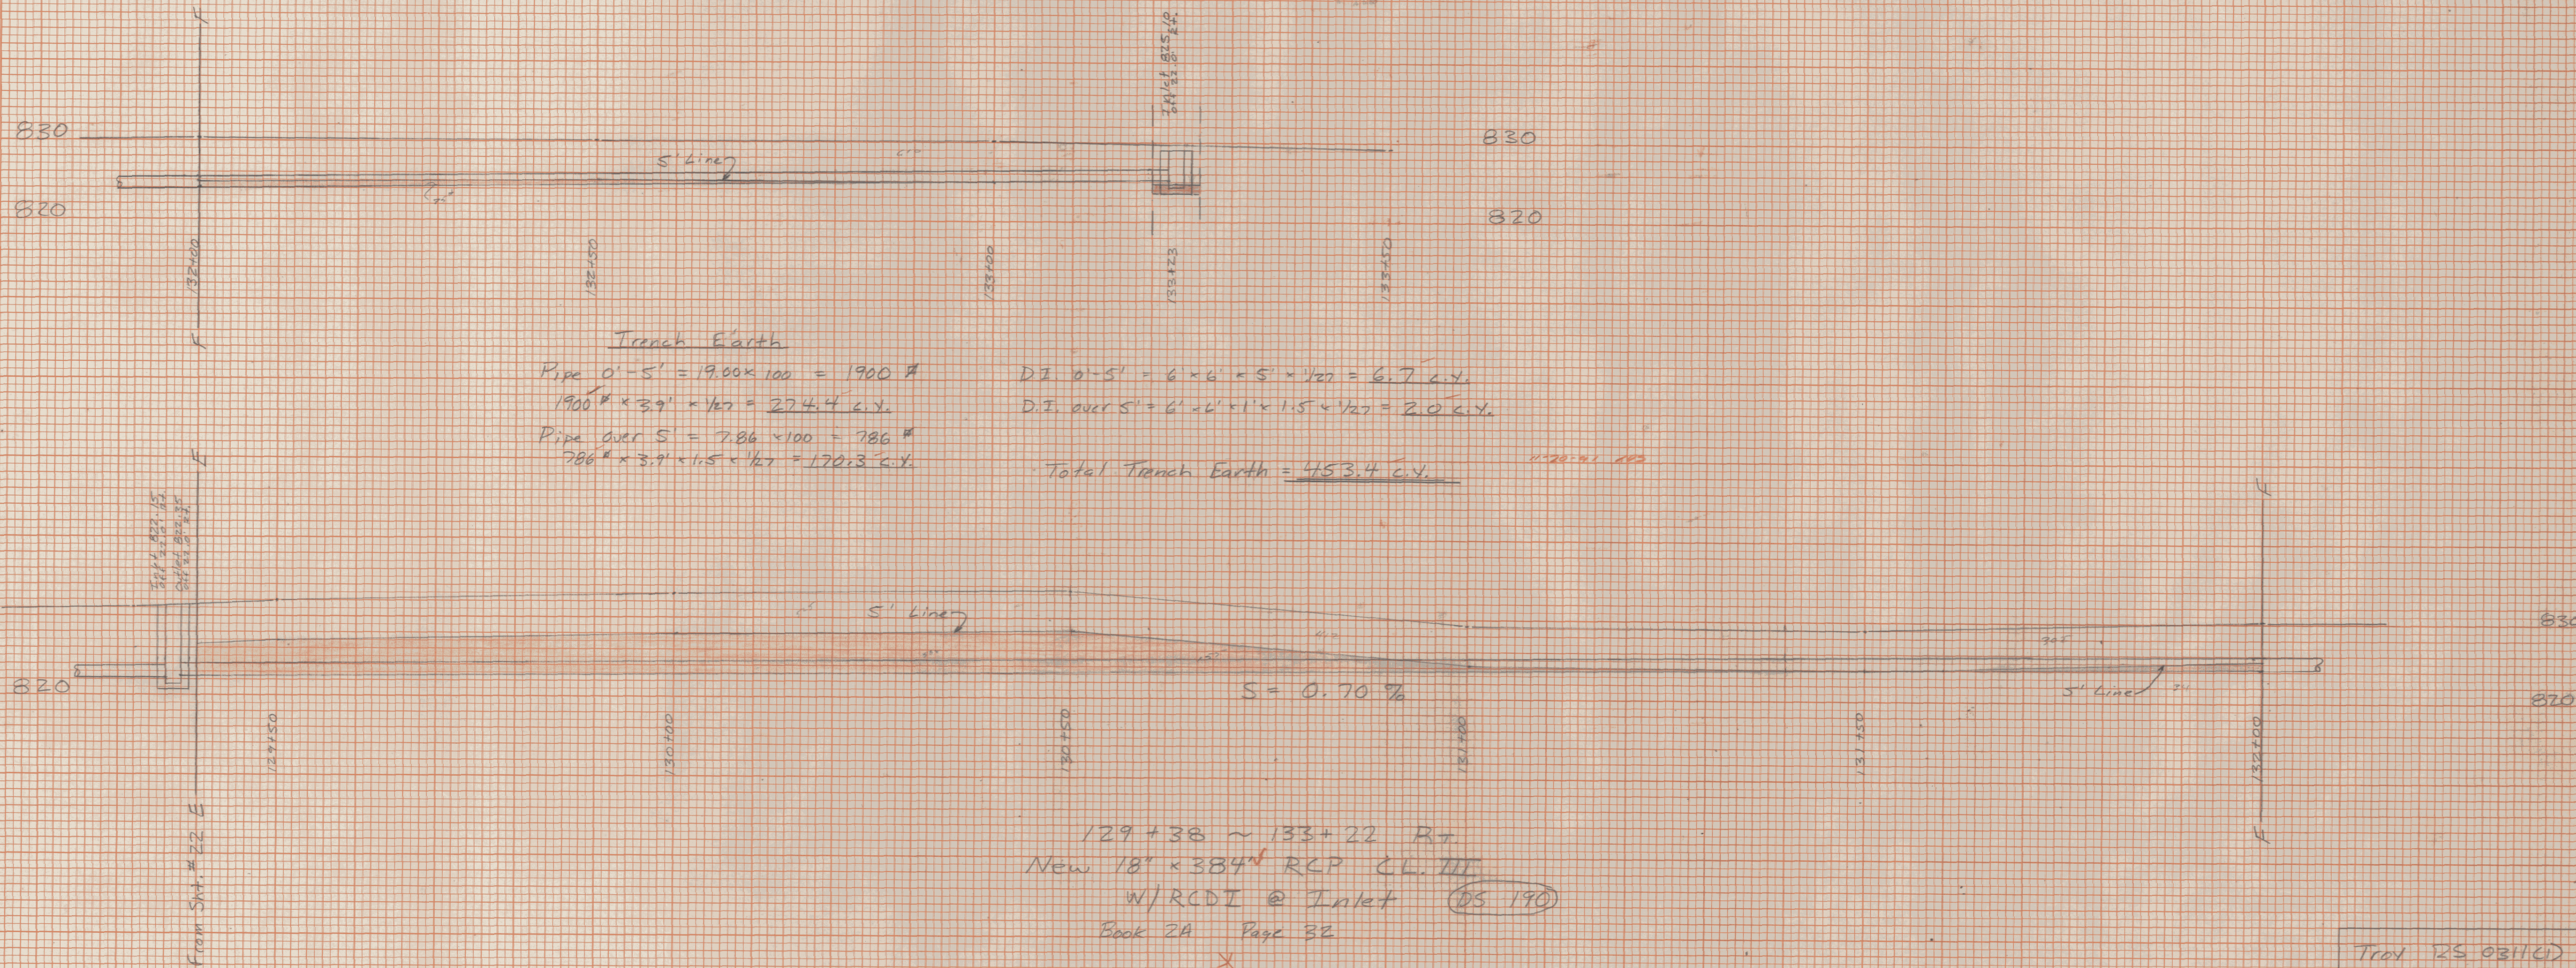

Trench Earth

Pipe 0'-5' = 19.00 x 100 = 1900 #

1900 # x 3.9' x 1/27 = 274.4 c.y.

Pipe over S' = 7.86 x 100 = 786 #

786 # x 3.9' x 1.5 x 1/27 = 170.3 c.y.

D.I. 0'-5' = 6' x 6' x 5' x 1/27 = 6.7 c.y.

D.I. over S' = 6' x 6' x 1' x 1.5 x 1/27 = 2.0 c.y.

Total Trench Earth = 453.4 c.y.

129+38 ~ 133+22 Rt

New 18" x 384" RCP CL III

w/ RCDI @ Inlet (DS 190)

Book 2A Page 32

Trod 25 0311(1)

Drainage Sheet #30