


FINAL SURVEY  
 QUANTITIES  
 PLOTTED  
 TEMPLATE  
 AREAS  
 CHECKED  
 NO.

ORIGINAL SURVEY  
 QUANTITIES  
 PLOTTED  
 TEMPLATE  
 AREAS  
 CHECKED  
 NO.

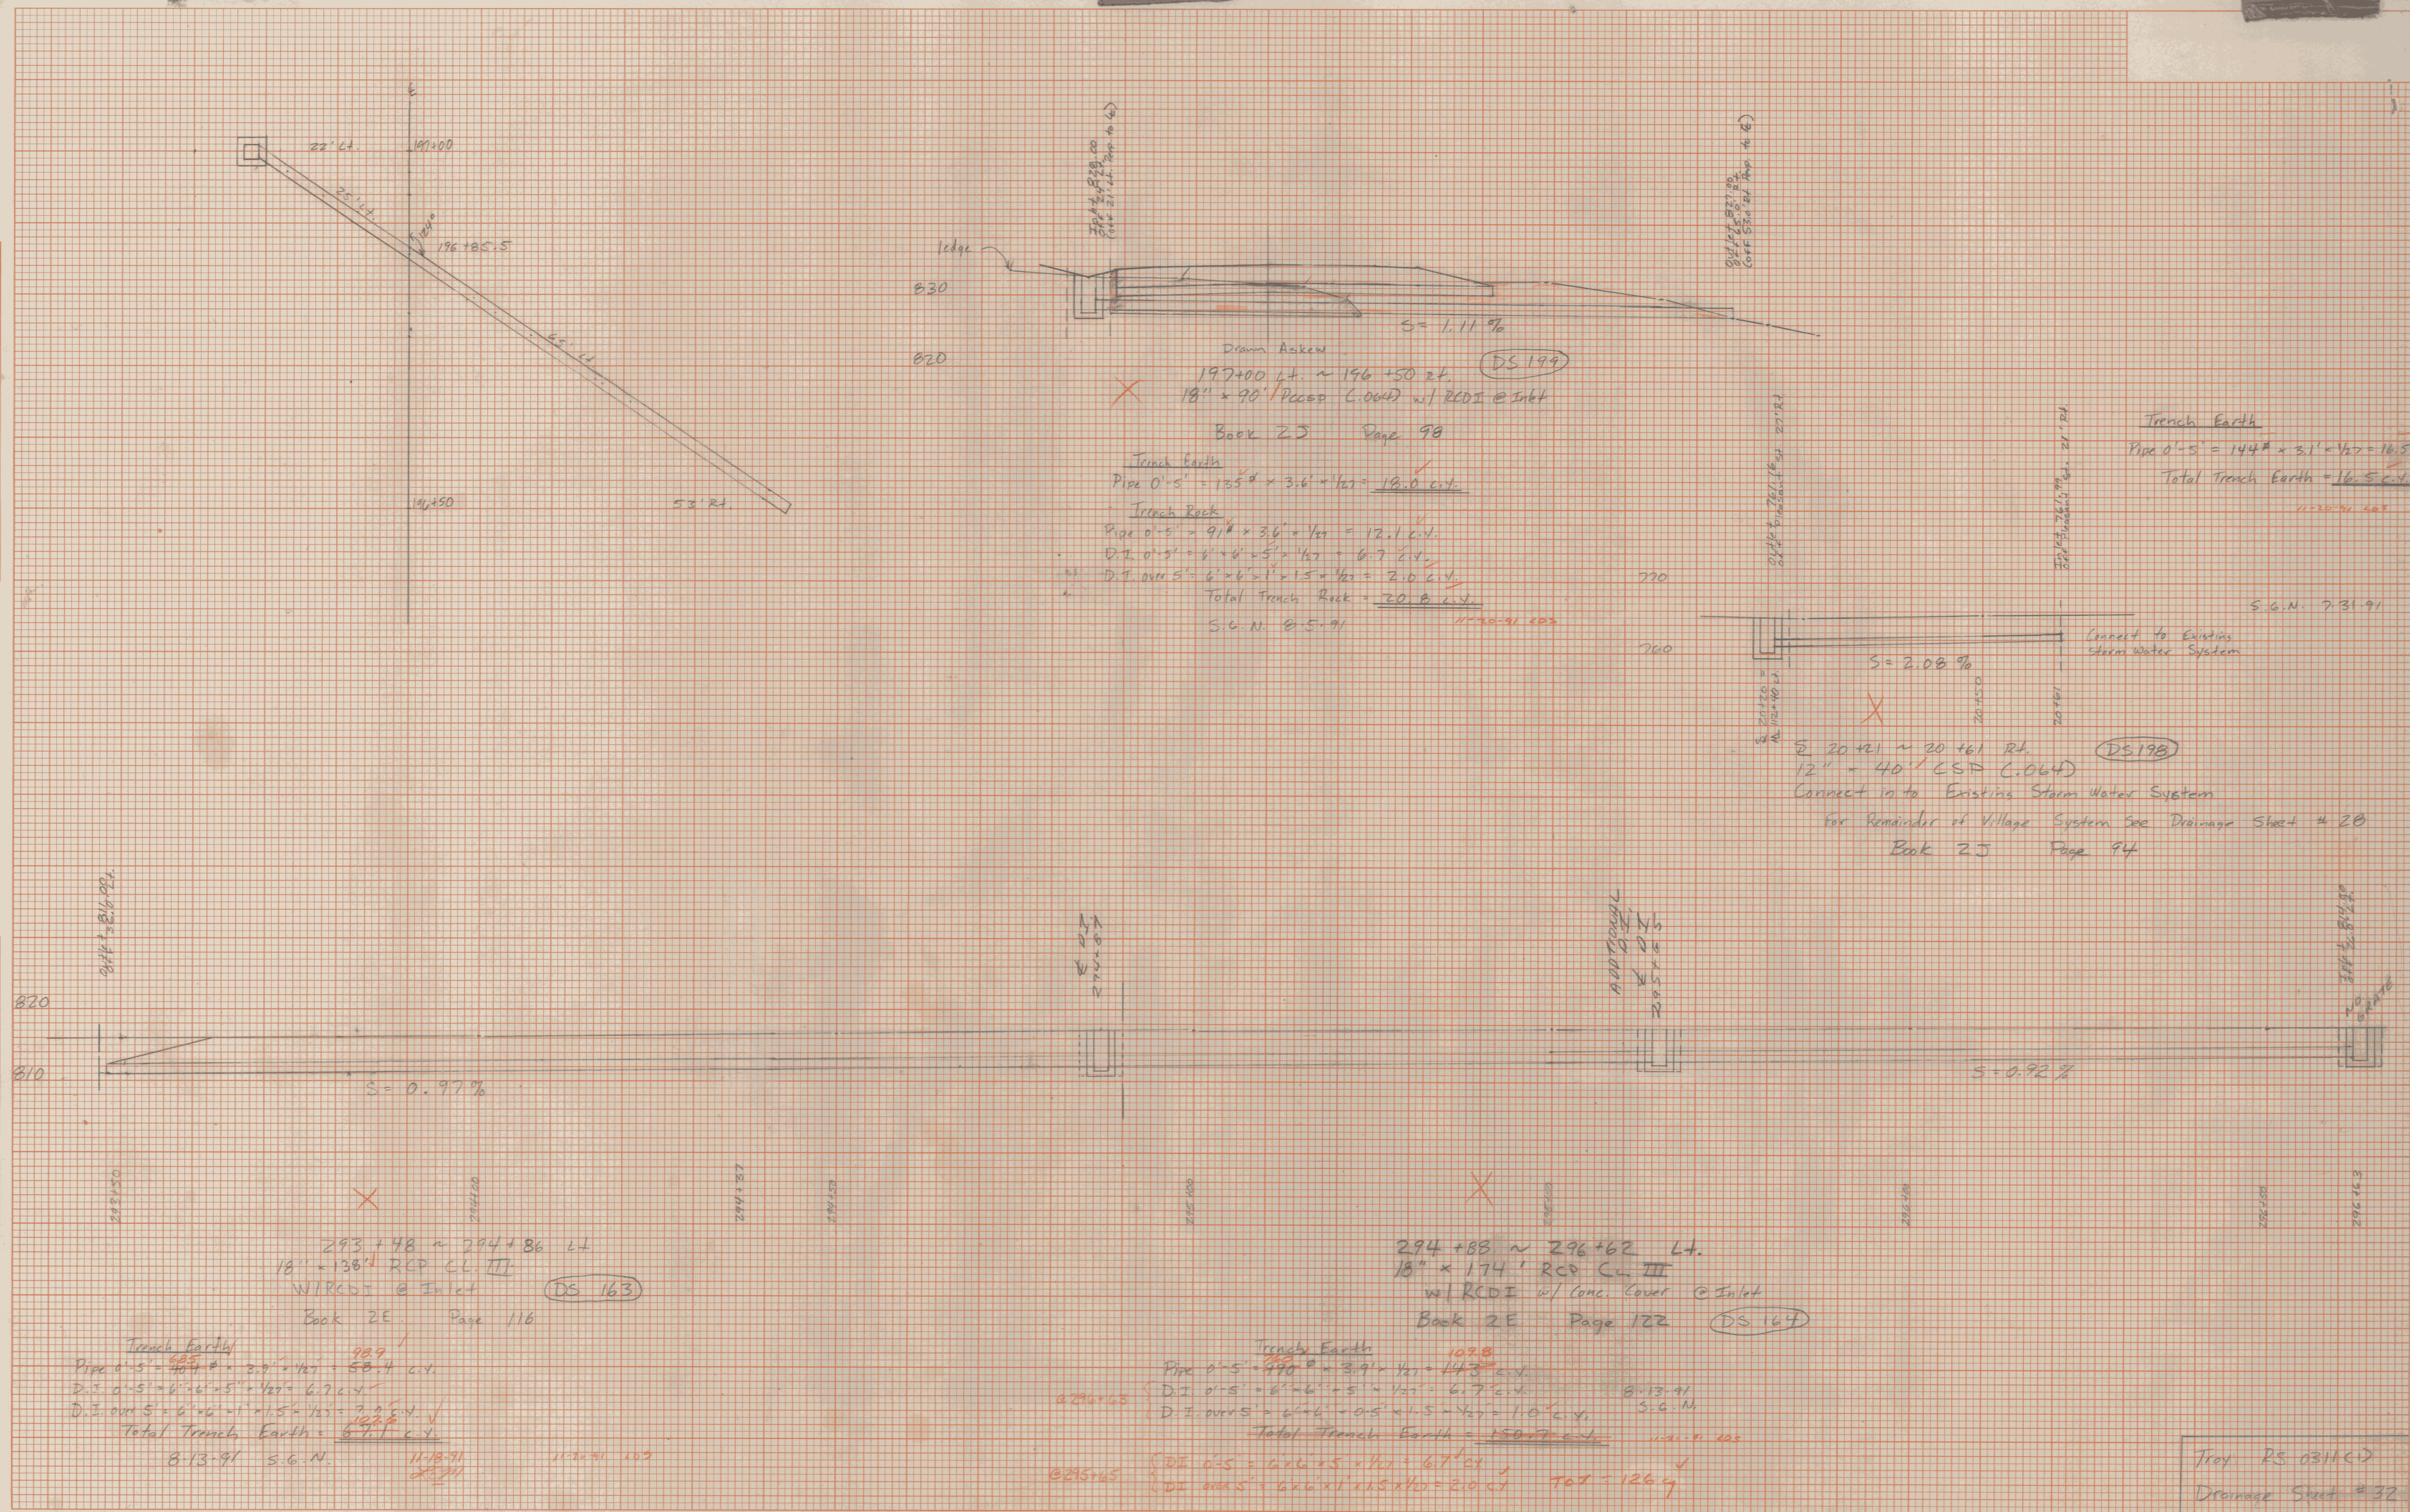

Drawn Askew  
 197+00 Lt. ~ 196+50 Rt. (DS 199)  
 18" x 90' RCP @ C.L. III w/ RCDI @ Inlet  
 Book 25 Page 98

Trench Earth  
 Pipe 0'-5" = 135' x 3.6' x 1/2" = 18.0 c.y.

Trench Rock  
 Pipe 0'-5" = 91' x 3.6' x 1/2" = 12.1 c.y.  
 D.I. 0'-5" = 6' x 6' x 5' x 1/2" = 6.7 c.y.  
 D.I. over 5" = 6' x 6' x 1' x 1.5' x 1/2" = 2.0 c.y.  
 Total Trench Rock = 20.8 c.y.  
 S.G.N. 8-5-91 11-20-91 105

Connect to Existing storm Water System  
 S = 2.08 %  
 20+41 ~ 20+61 Rt. (DS 198)  
 12" x 40' CSP (.064)  
 Connect in to Existing Storm Water System  
 For Remainder of Village System See Drainage Sheet # 28  
 Book 25 Page 94  
 S.G.N. 7-31-91

293+48 ~ 294+86 Lt.  
 18" x 138' RCP C.L. III  
 w/ RCDI @ Inlet (DS 163)  
 Book 2E Page 116

Trench Earth  
 Pipe 0'-5" = 459' x 3.9' x 1/2" = 58.4 c.y.  
 D.I. 0'-5" = 6' x 6' x 5' x 1/2" = 6.7 c.y.  
 D.I. over 5" = 6' x 6' x 1' x 1.5' x 1/2" = 2.0 c.y.  
 Total Trench Earth = 67.1 c.y.  
 8-13-91 S.G.N. 11-18-91 11-20-91 105

294+88 ~ 296+62 Lt.  
 18" x 174' RCP C.L. III  
 w/ RCDI w/ Conc. Cover @ Inlet (DS 167)  
 Book 2E Page 122

Trench Earth  
 Pipe 0'-5" = 490' x 3.9' x 1/2" = 143.3 c.y.  
 D.I. 0'-5" = 6' x 6' x 5' x 1/2" = 6.7 c.y.  
 D.I. over 5" = 6' x 6' x 0.5' x 1.5' x 1/2" = 1.0 c.y.  
 Total Trench Earth = 150.7 c.y.  
 8-13-91 S.G.N. 11-20-91 105  
 D.I. 0'-5" = 6' x 6' x 5' x 1/2" = 6.7 c.y.  
 D.I. over 5" = 6' x 6' x 1' x 1.5' x 1/2" = 2.0 c.y.  
 Tot = 126.4