
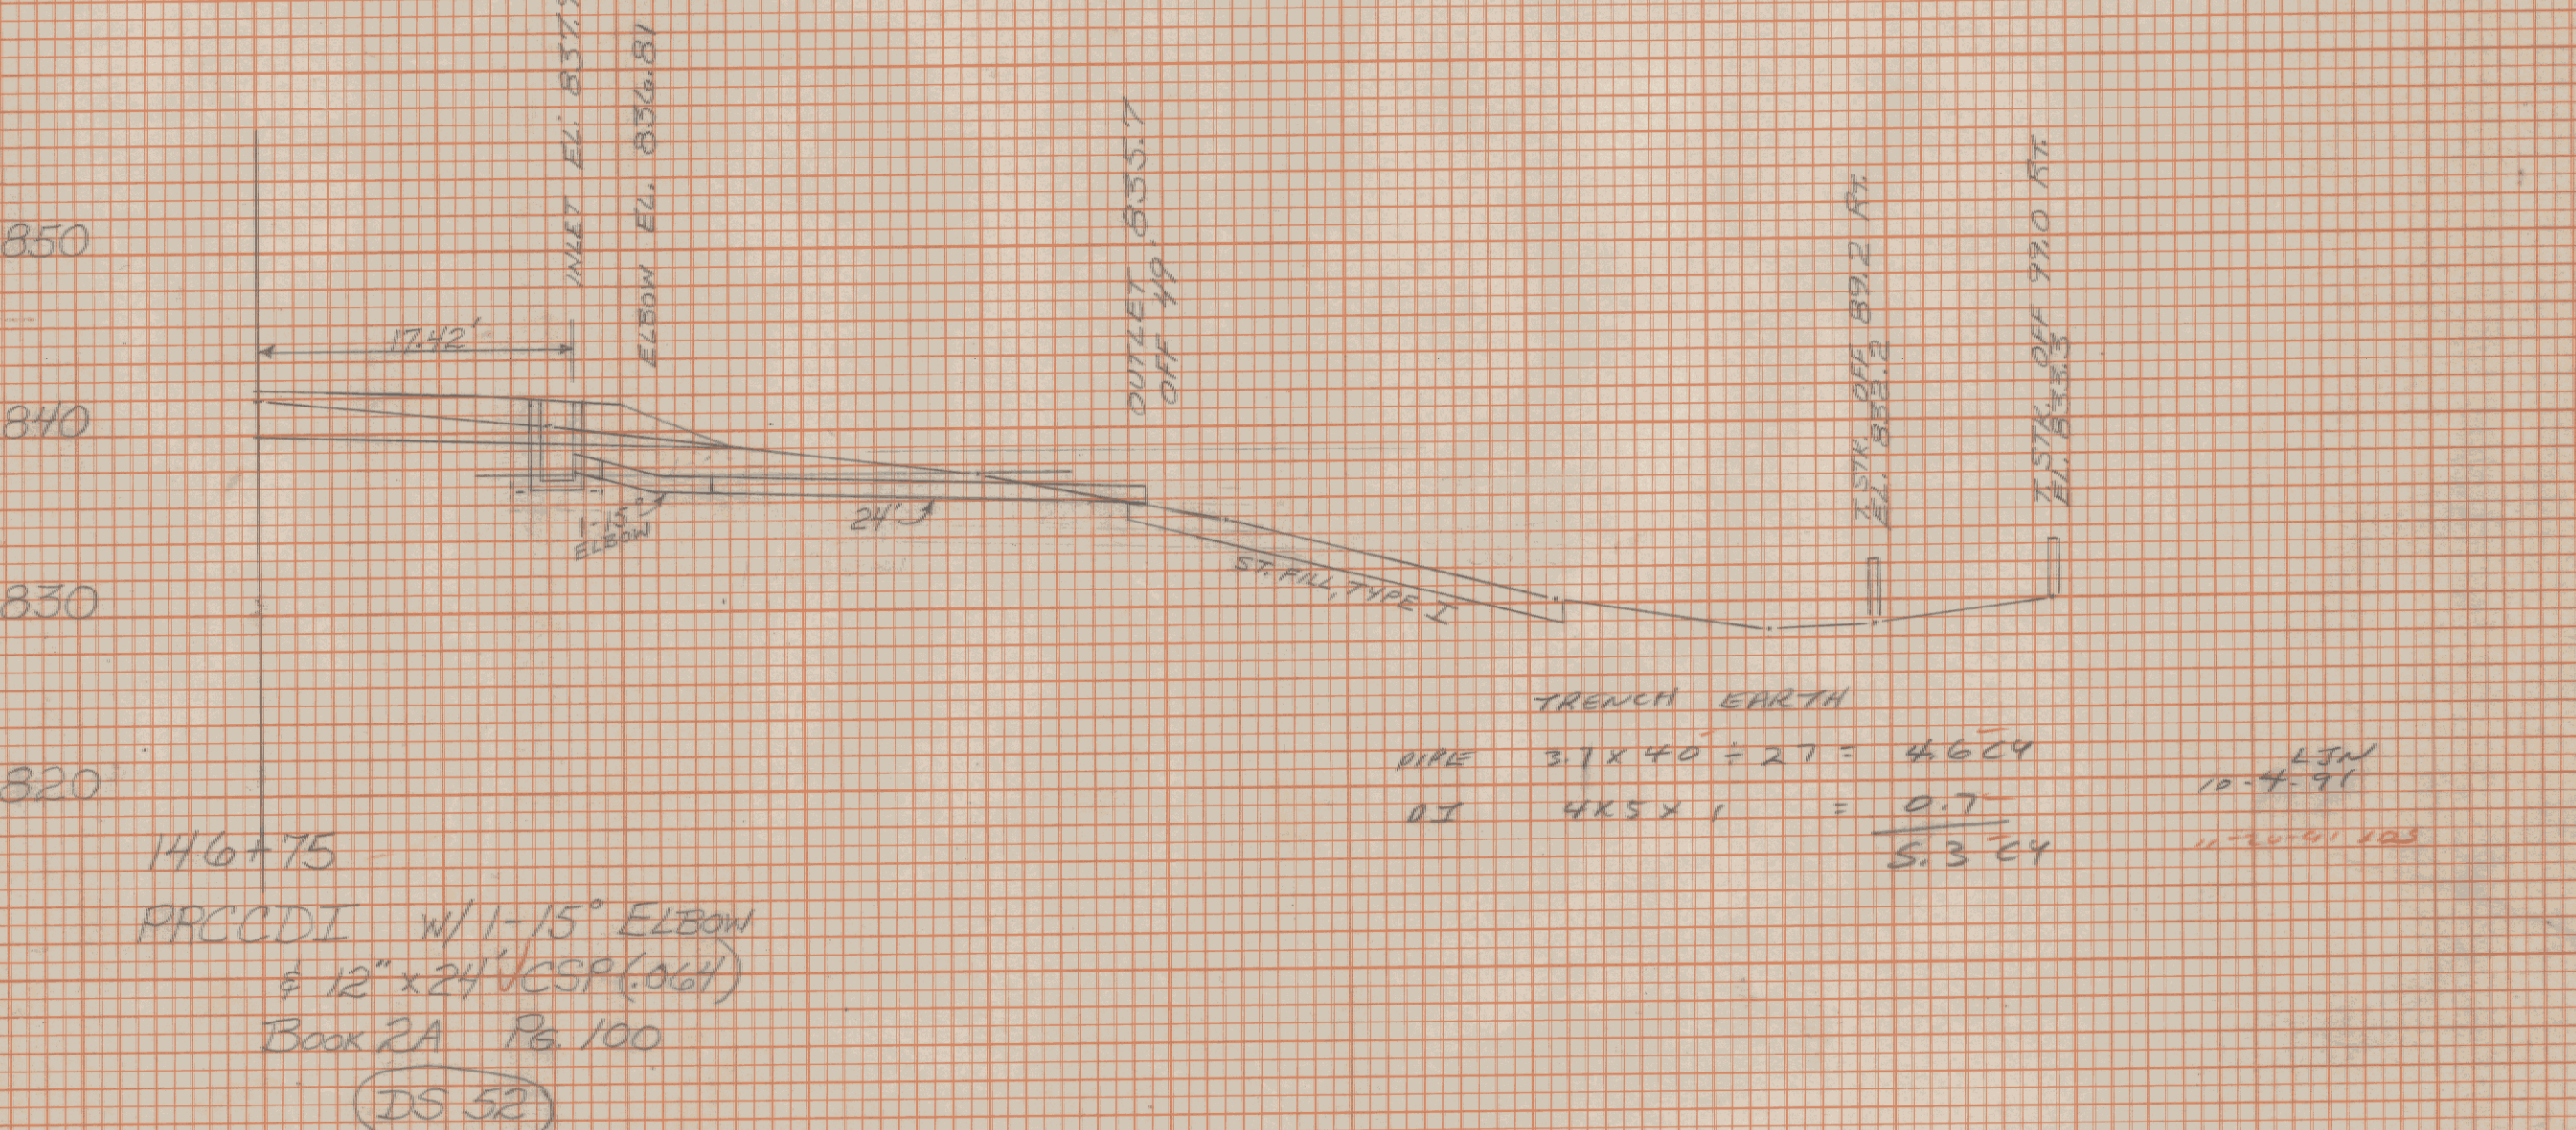
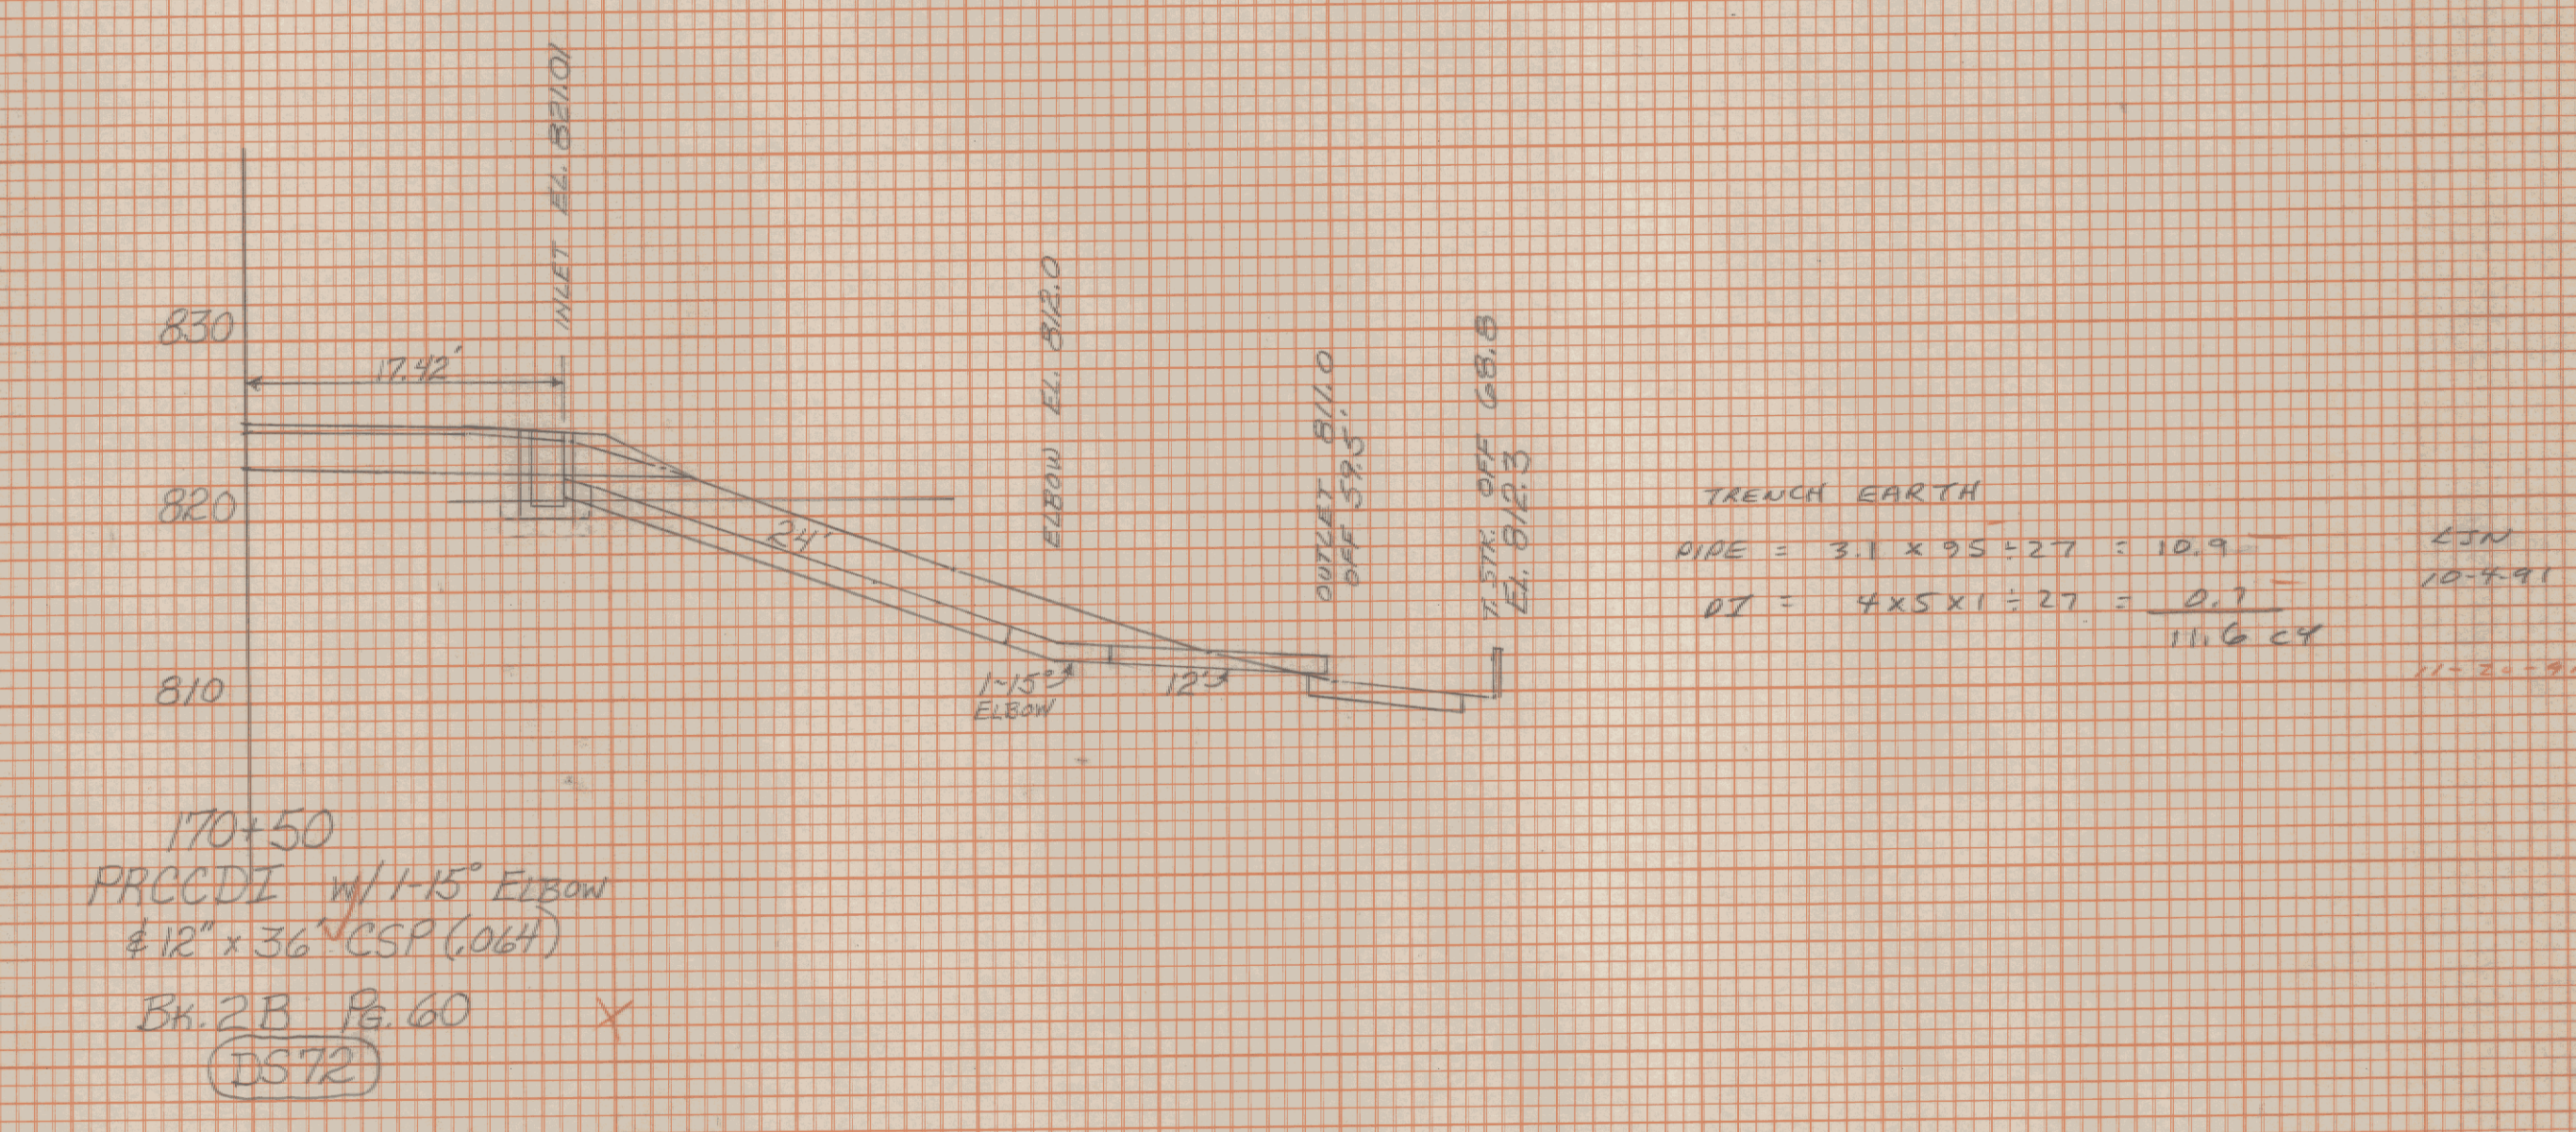
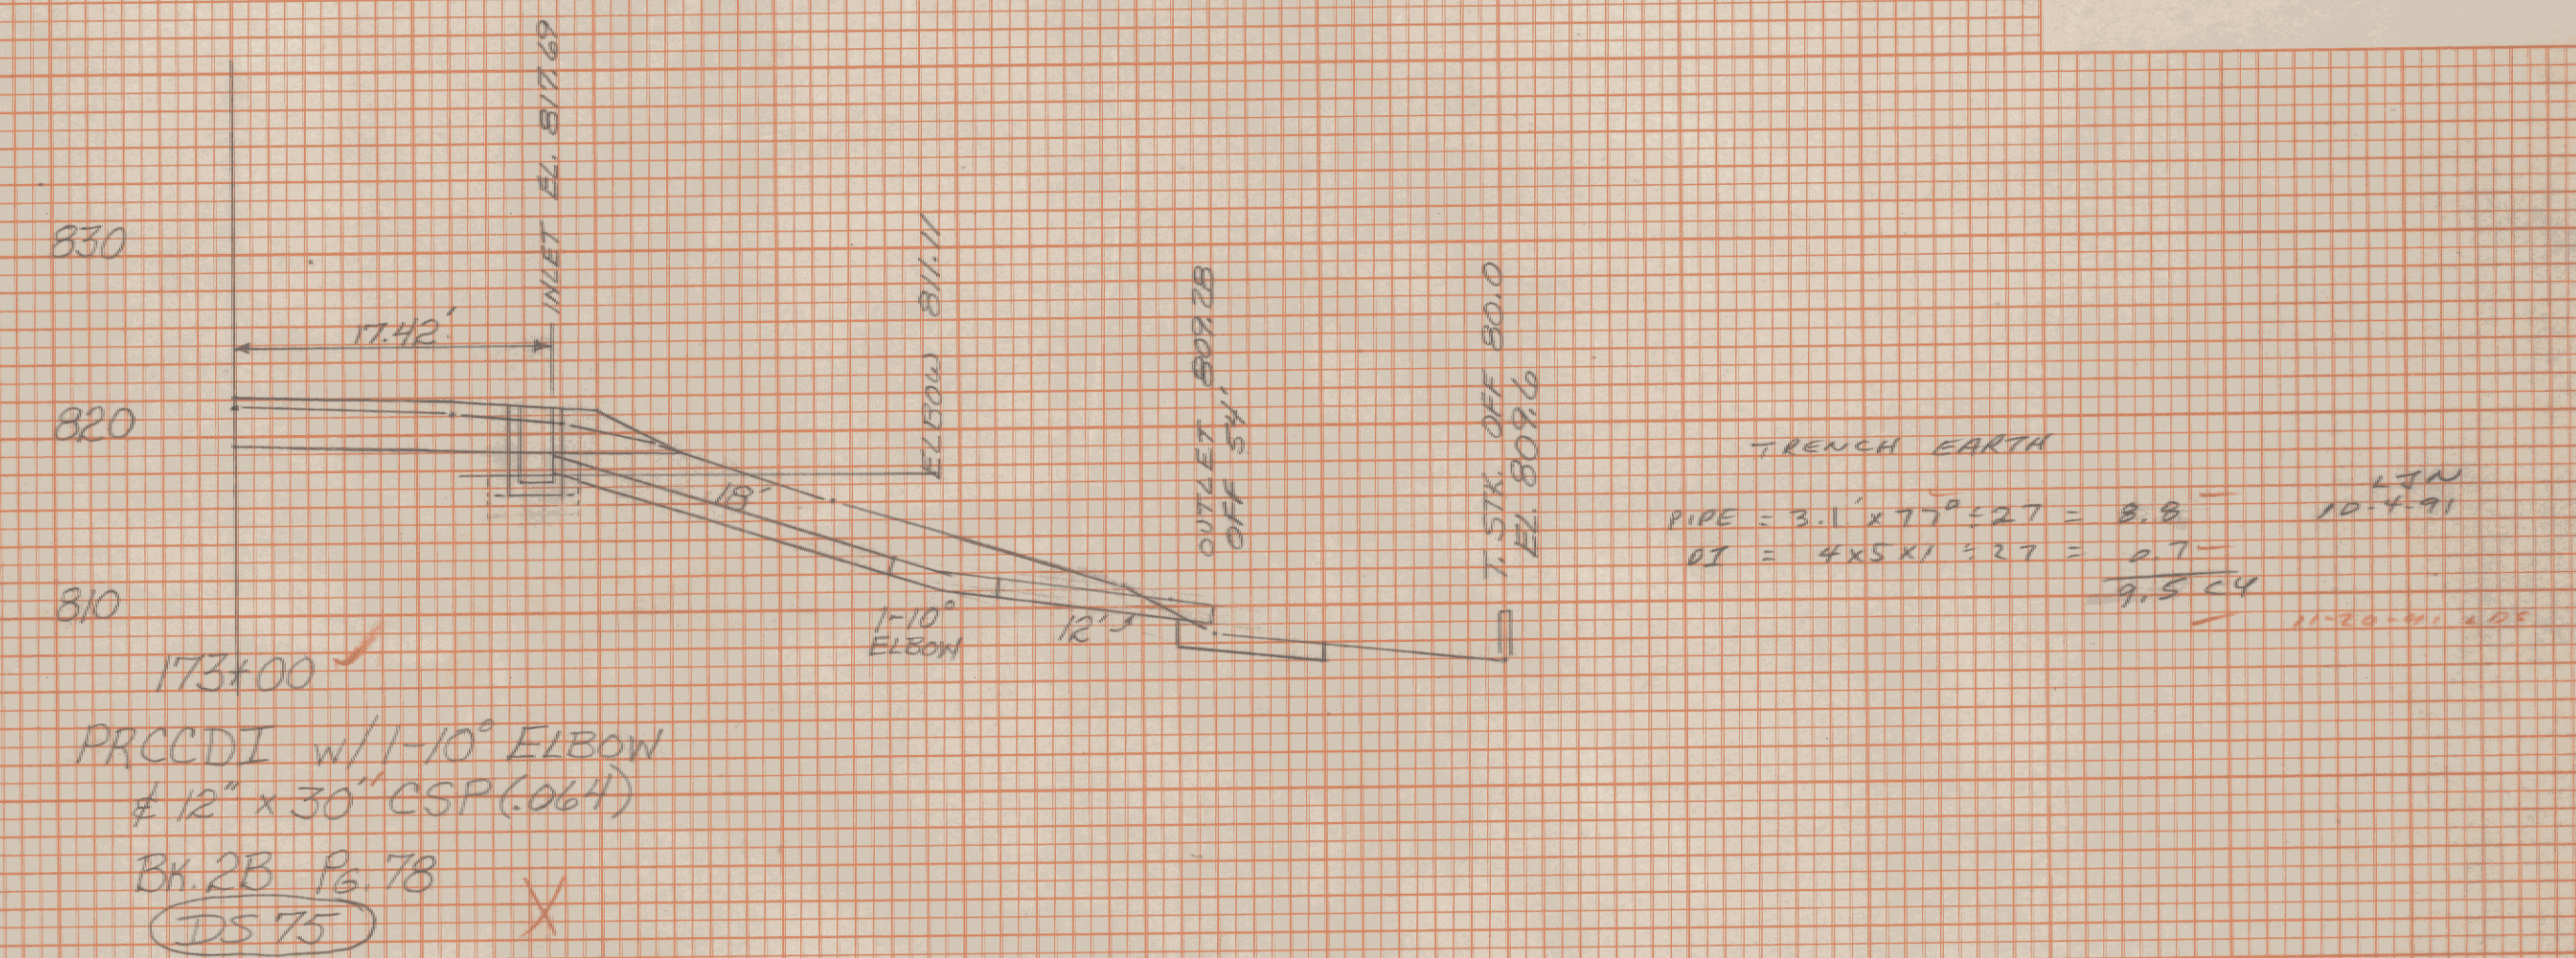
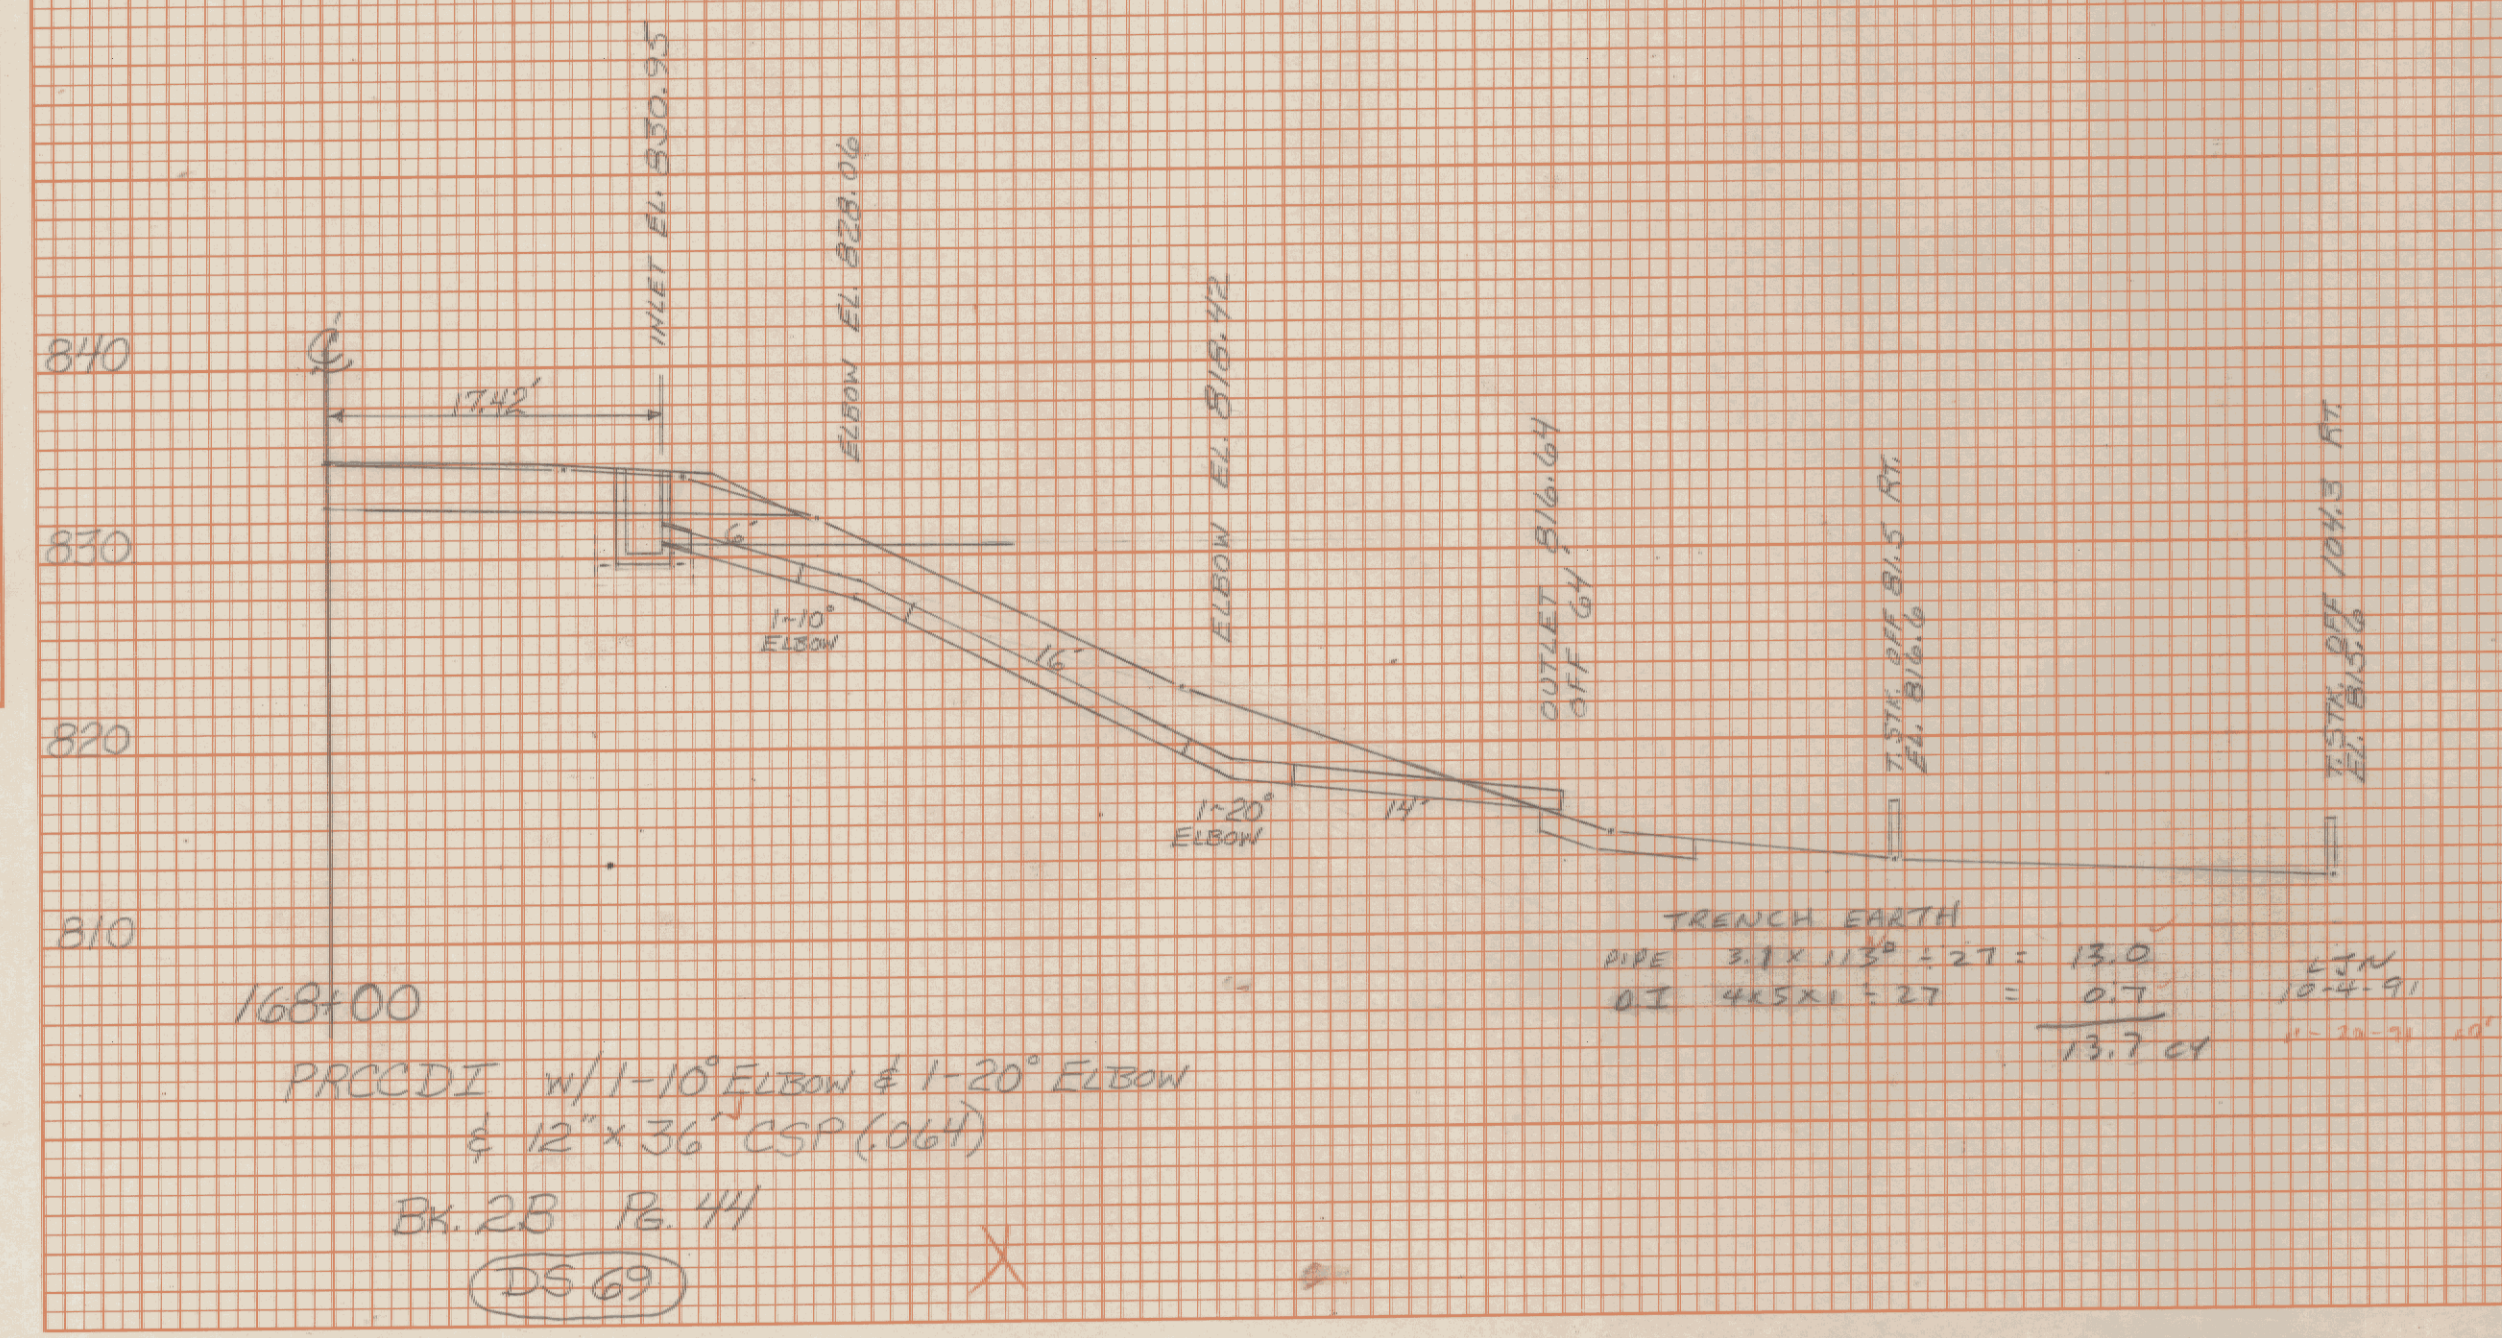
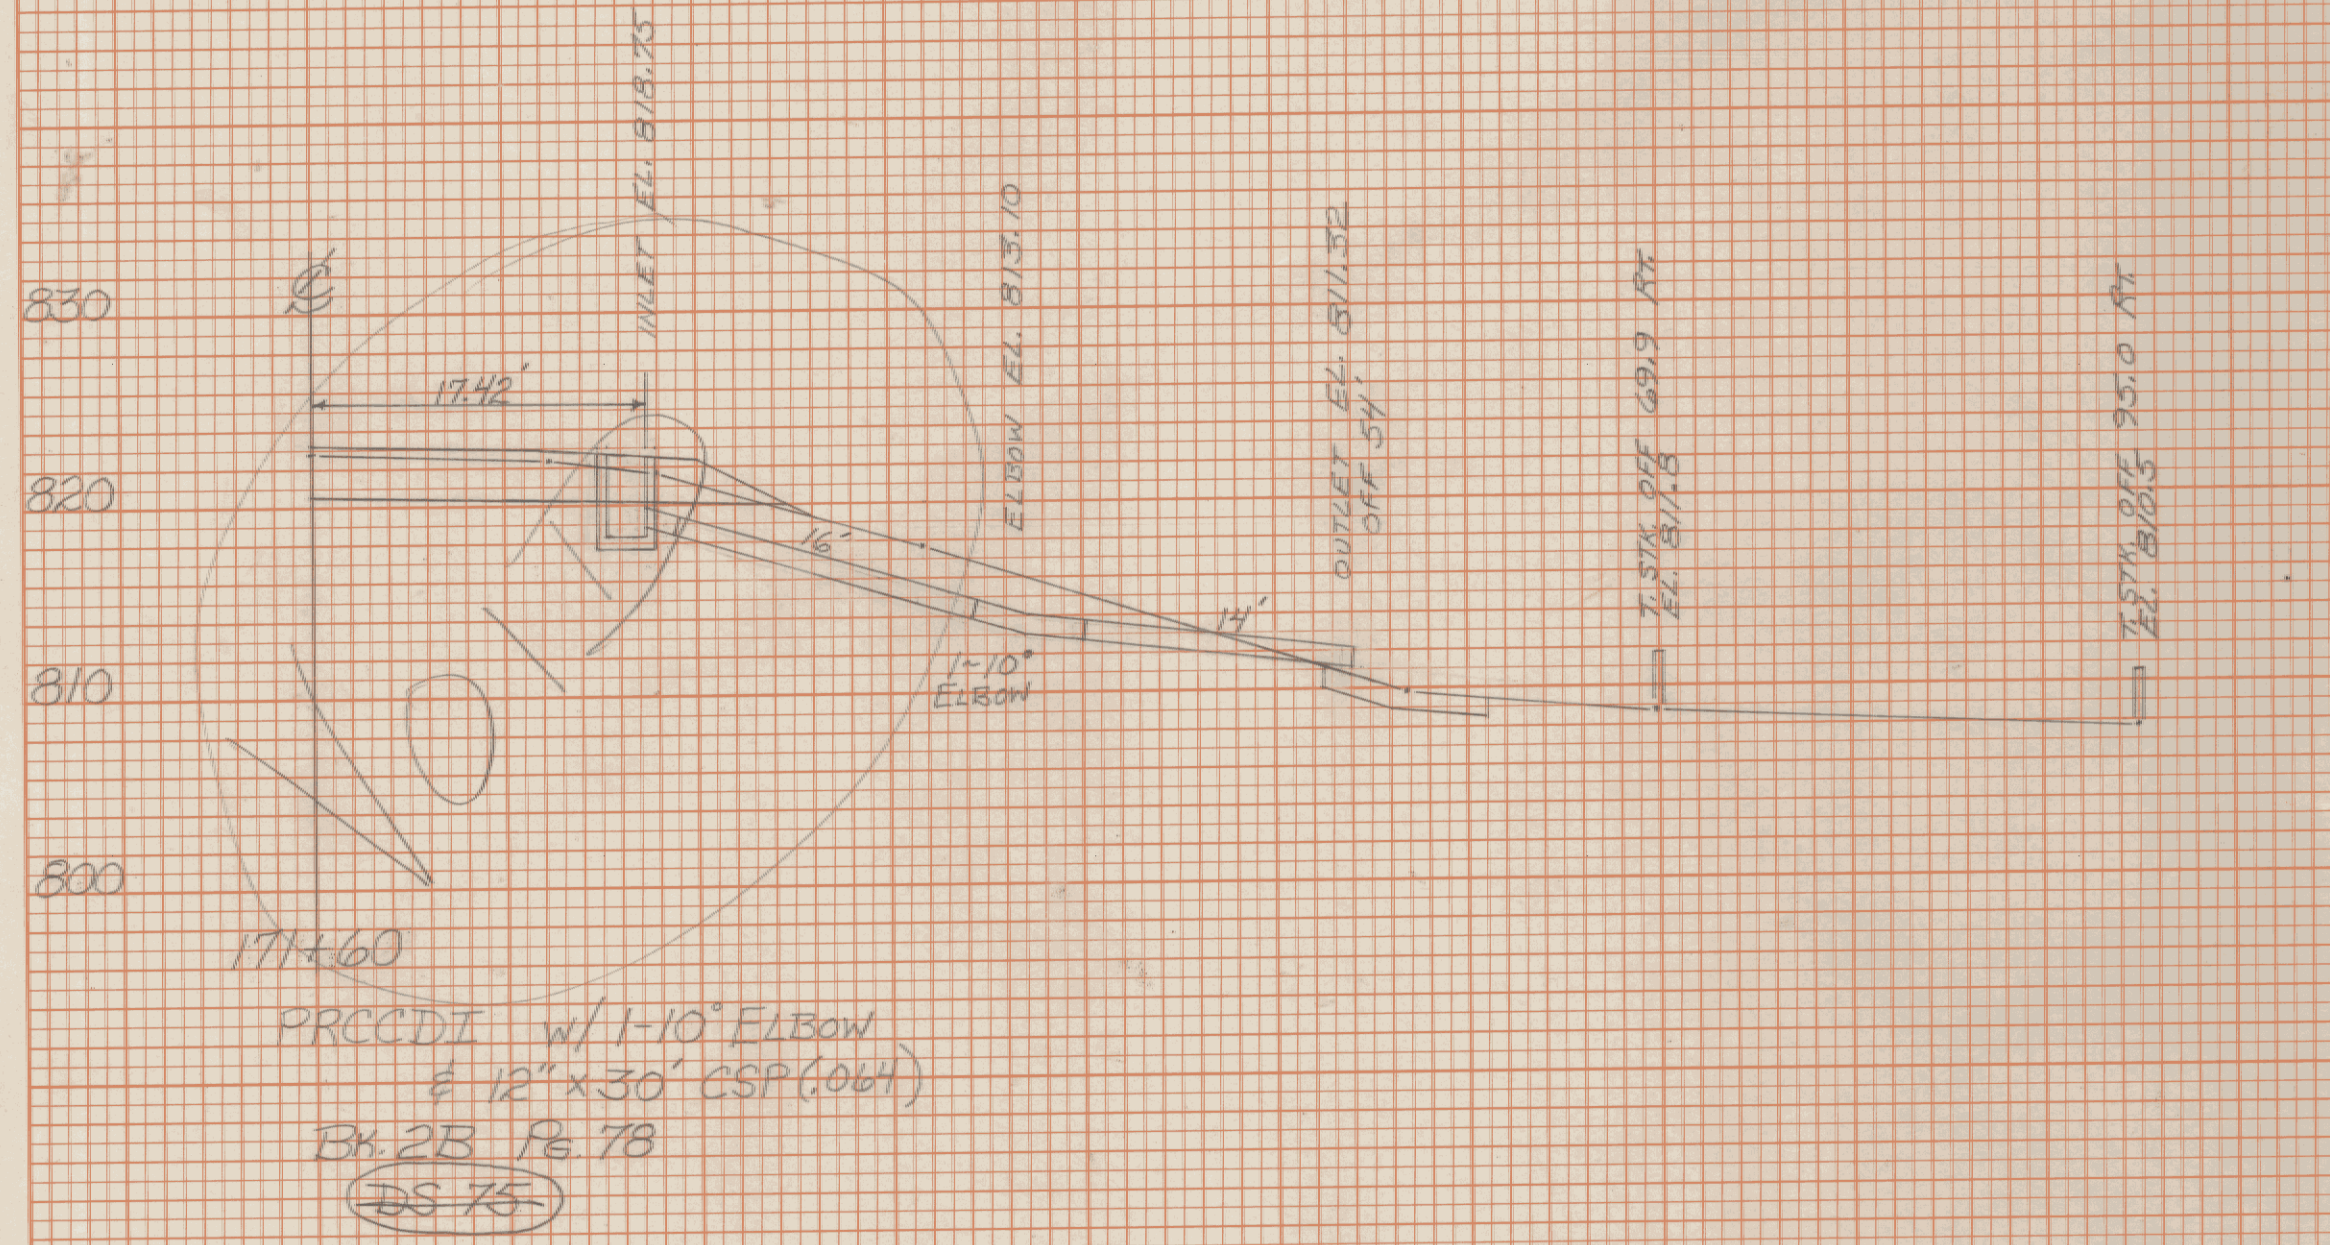


DATE	
BY	
NO.	
FINAL SURVEY	
NOTED	
TEMPERATURE	
AREAS	
AREAS CIRCLED	
NO.	

DATE	
BY	
NO.	
ORIGINAL SURVEY	
NOTED	
TEMPERATURE	
AREAS	
AREAS CIRCLED	
NO.	

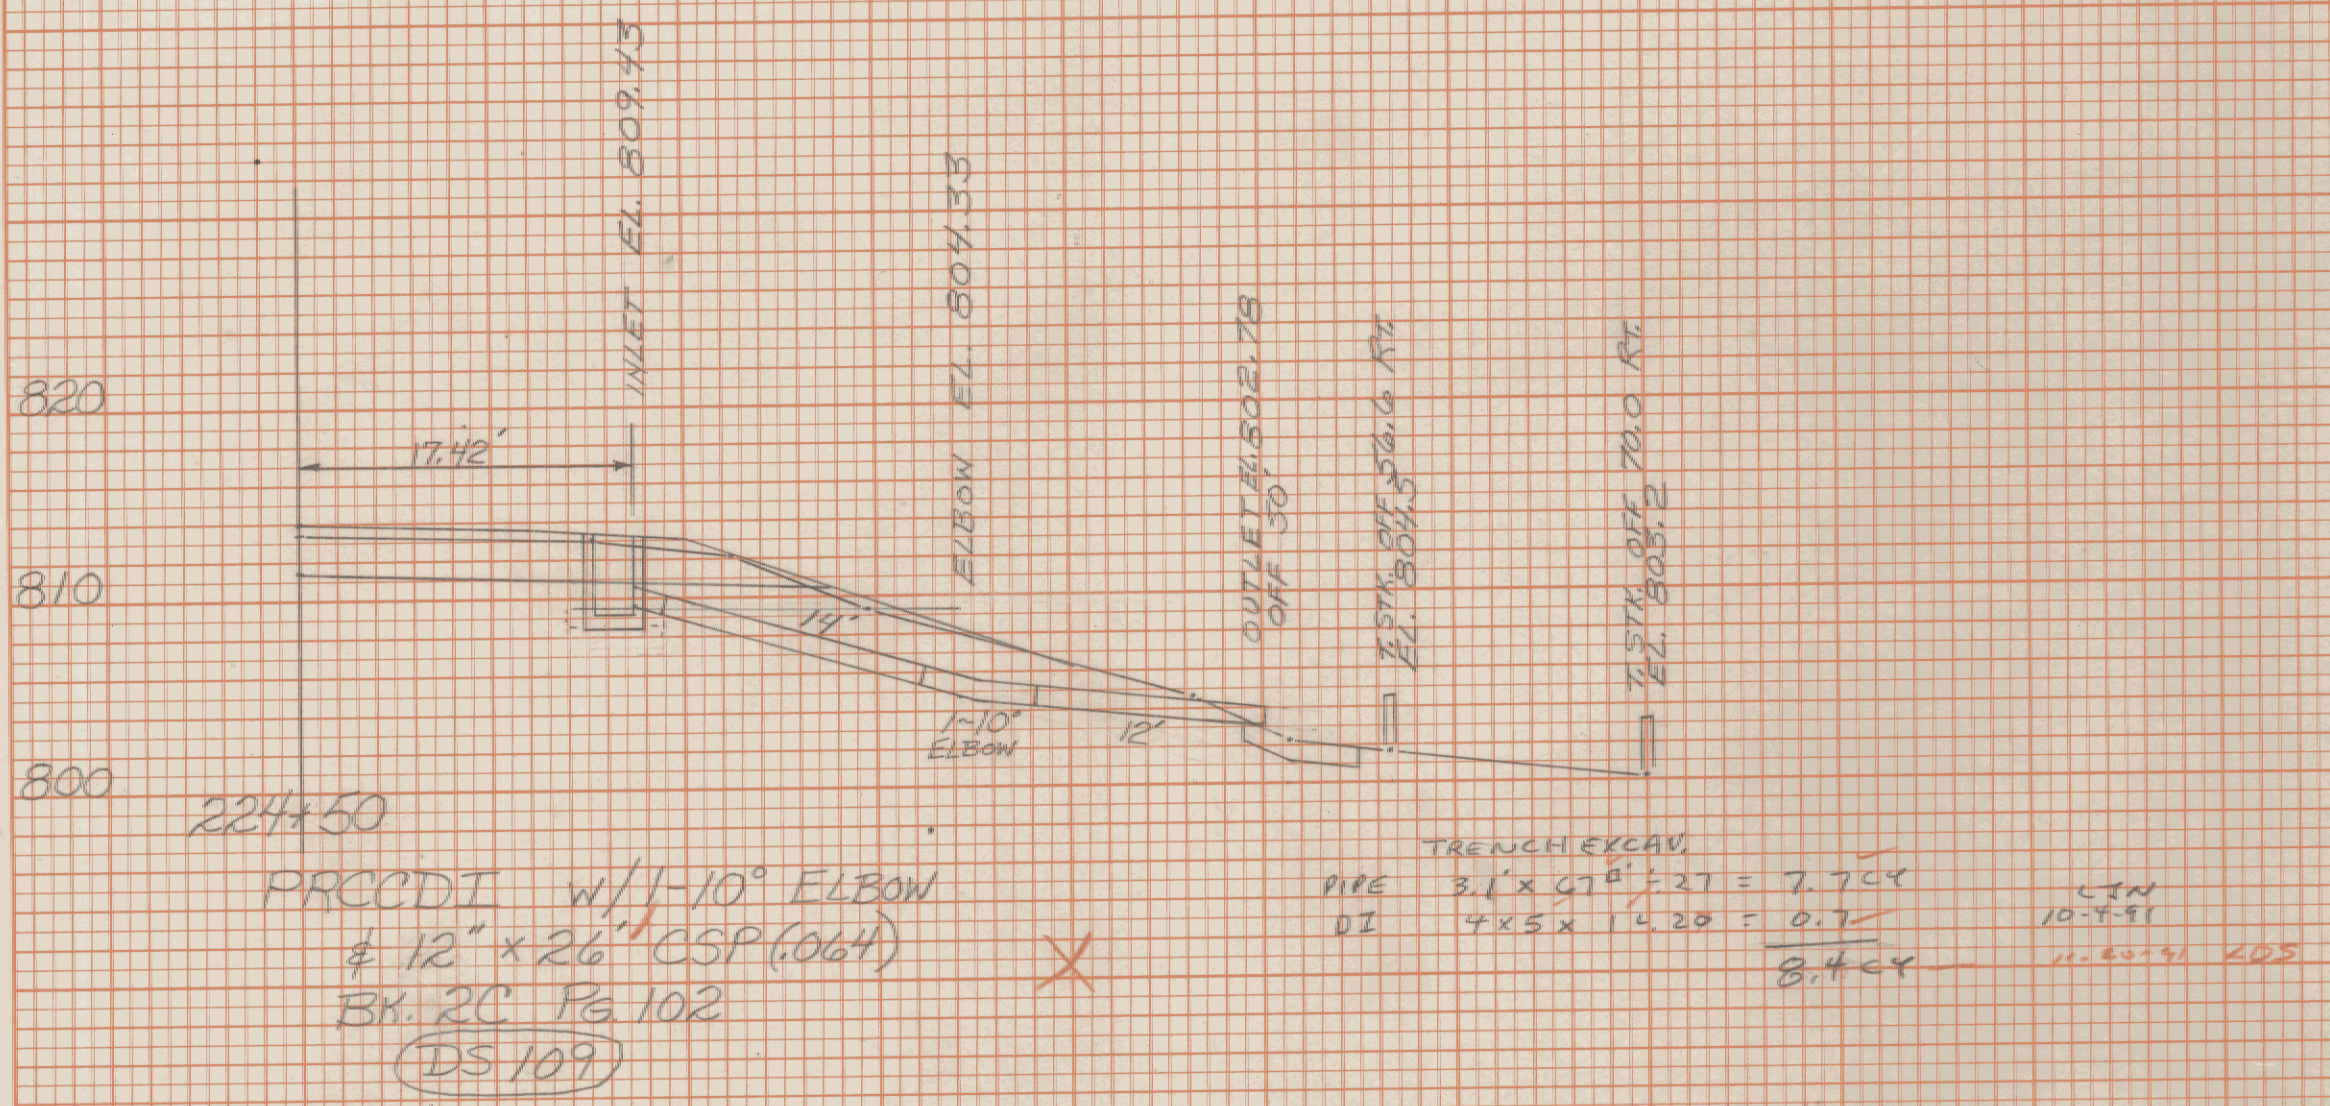

TROY RS 0311(1)  
DRAINAGE SHEET # 34