
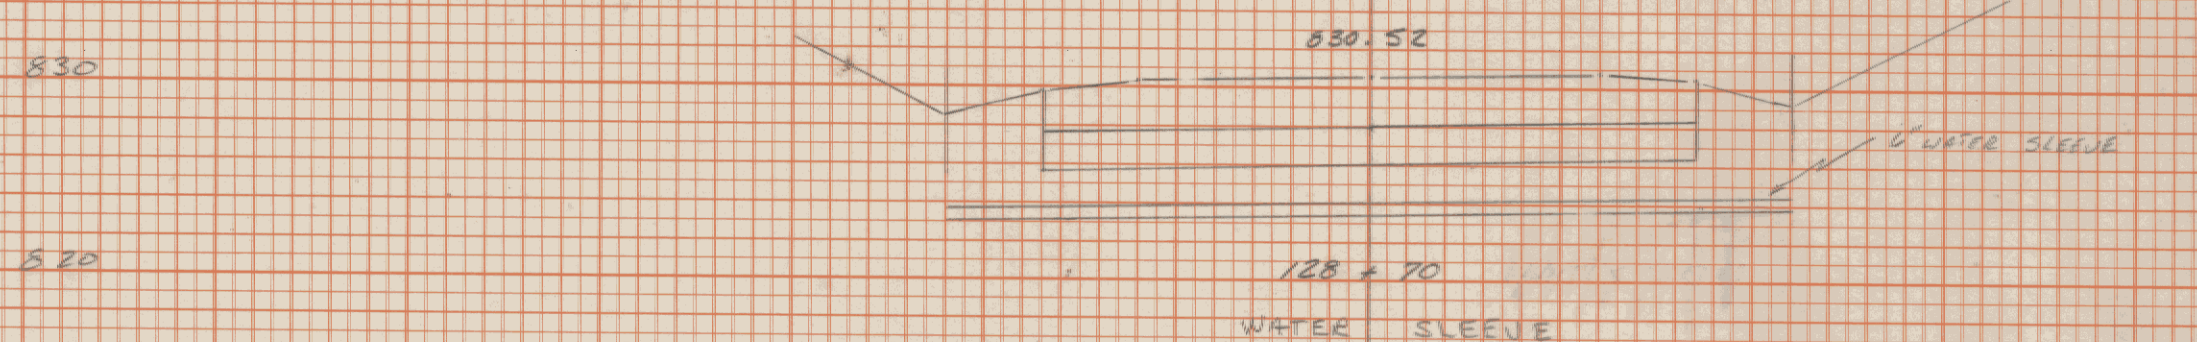
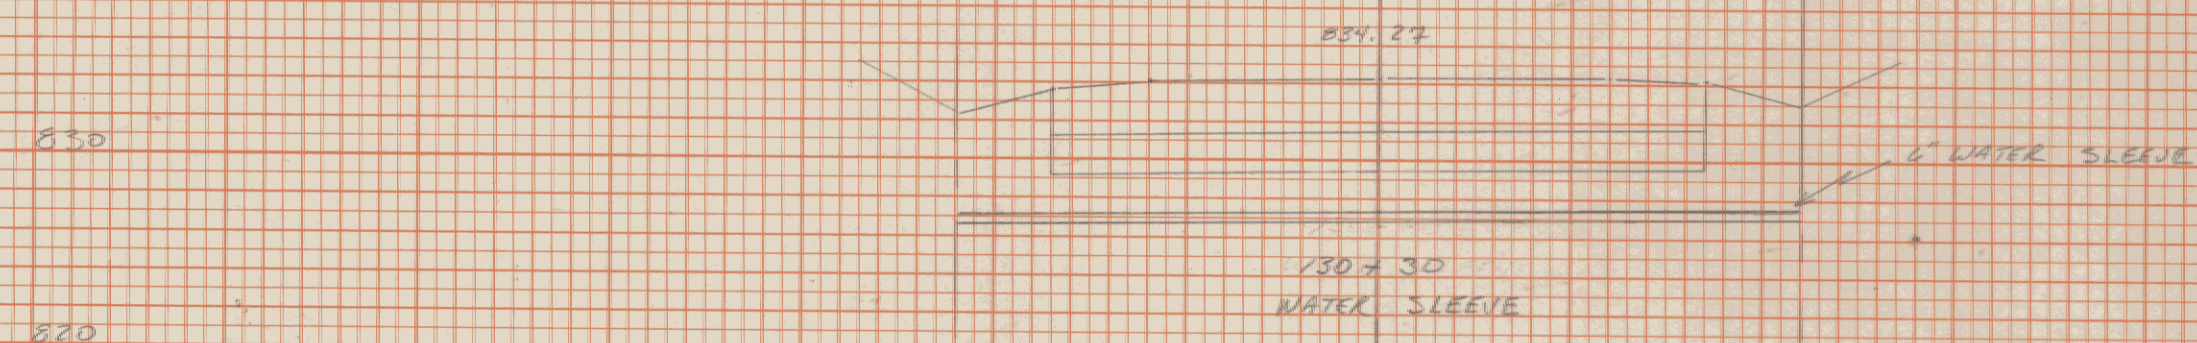


FINAL SURVEY NOTE BOOK No. _____
 SURVEYED BY _____ DATE _____
 PLOTTED BY _____
 TEMPLATE AREA CHECKED _____

ORIGINAL SURVEY NOTE BOOK No. _____
 SURVEYED BY _____ DATE _____
 PLOTTED BY _____
 TEMPLATE AREA CHECKED _____

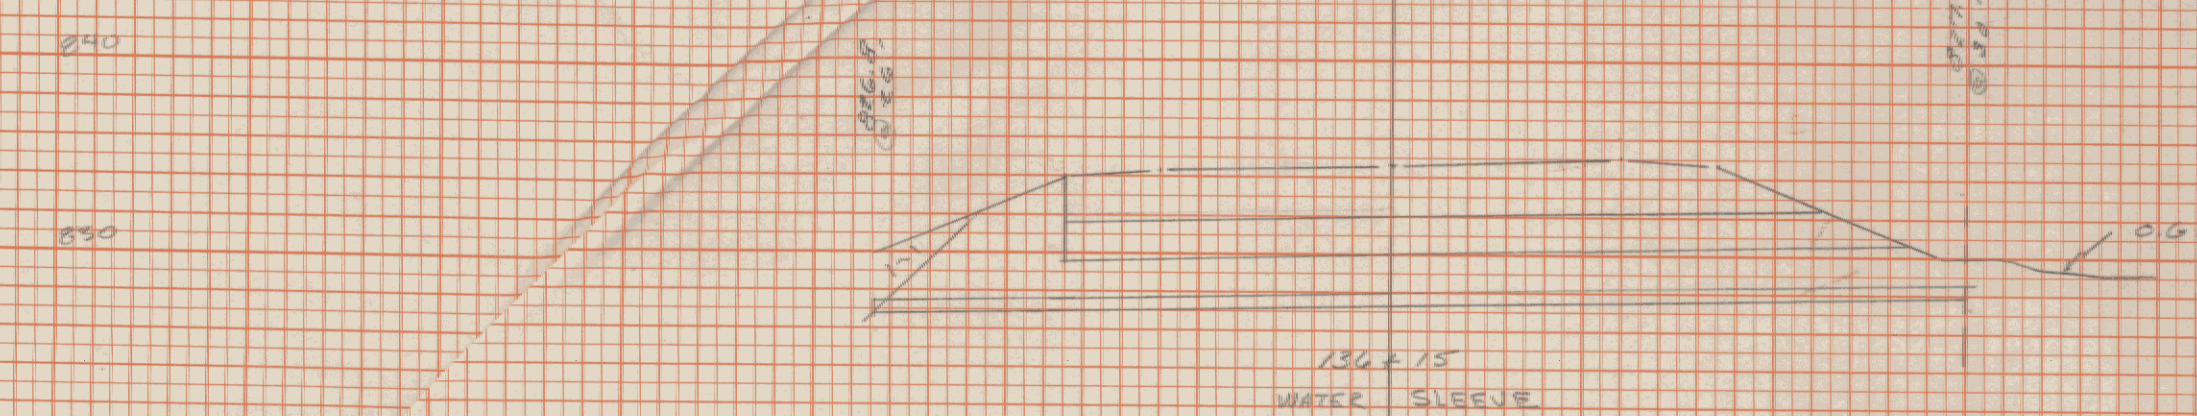

TRON R50311(1)
 SHEET # 35