
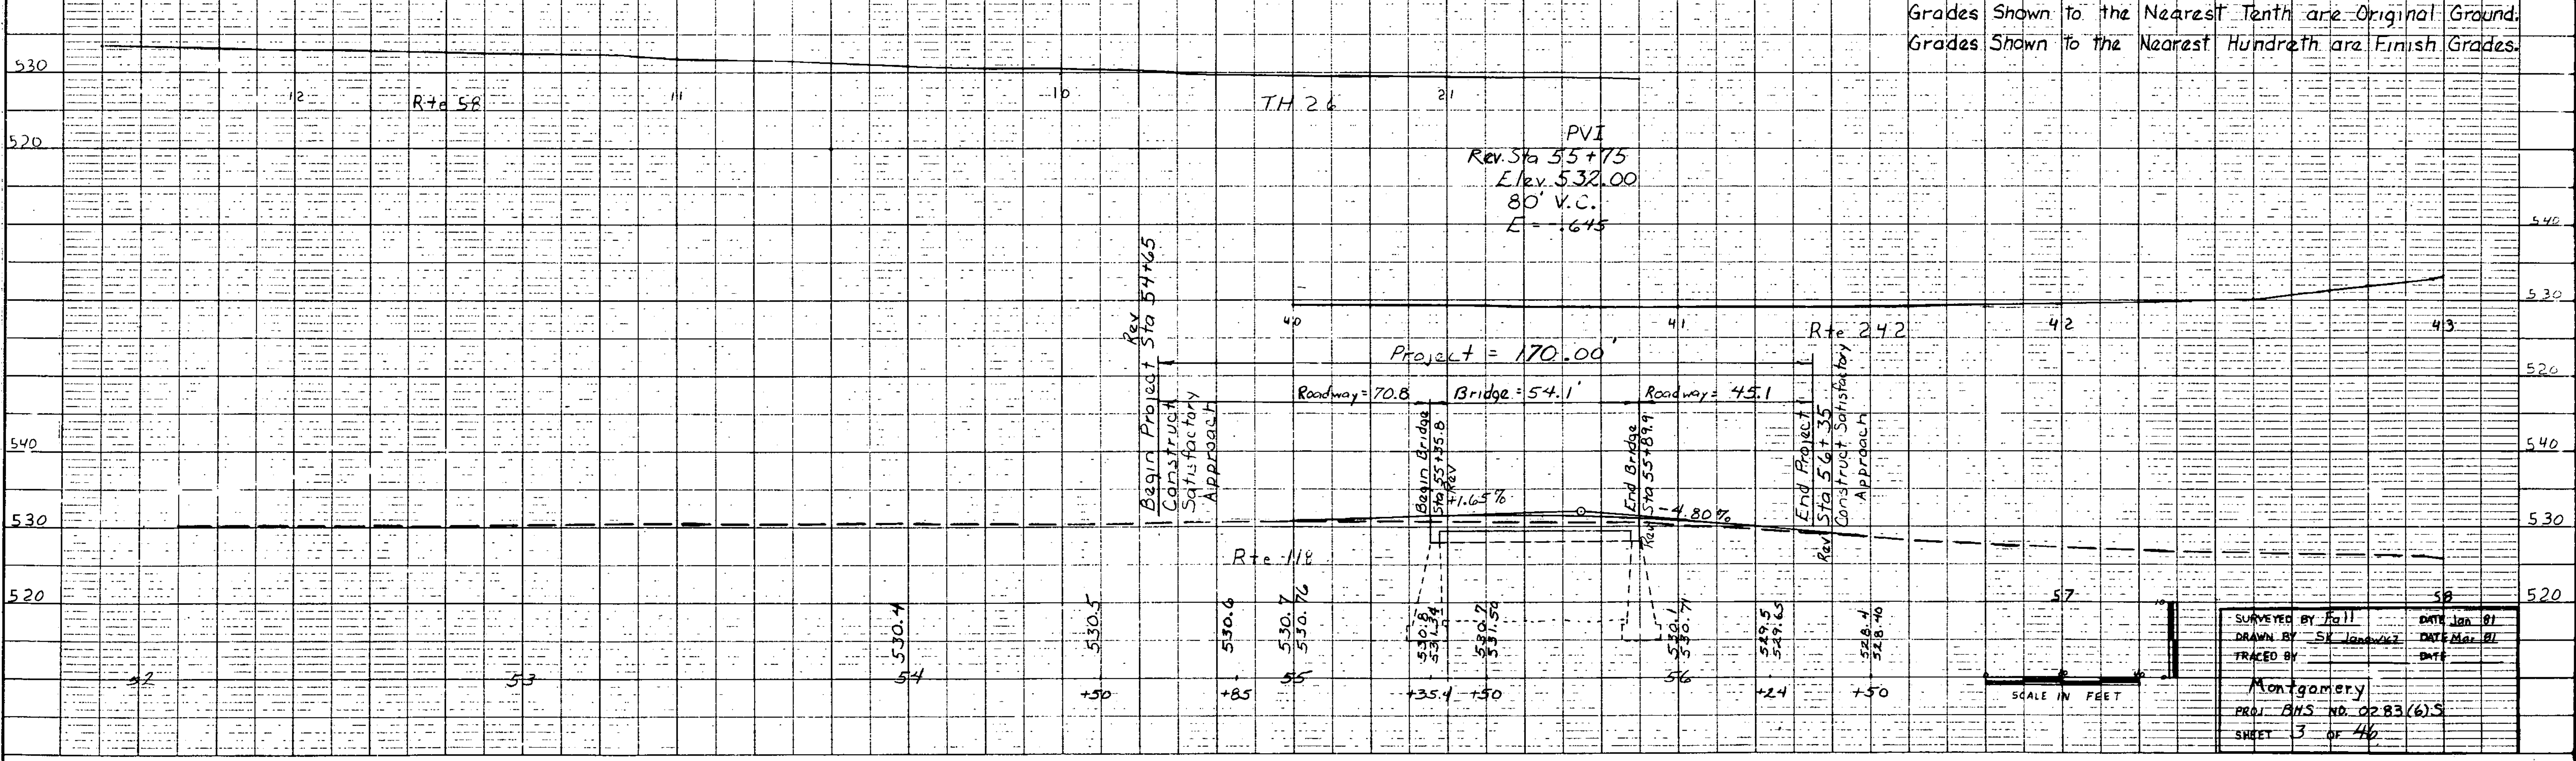
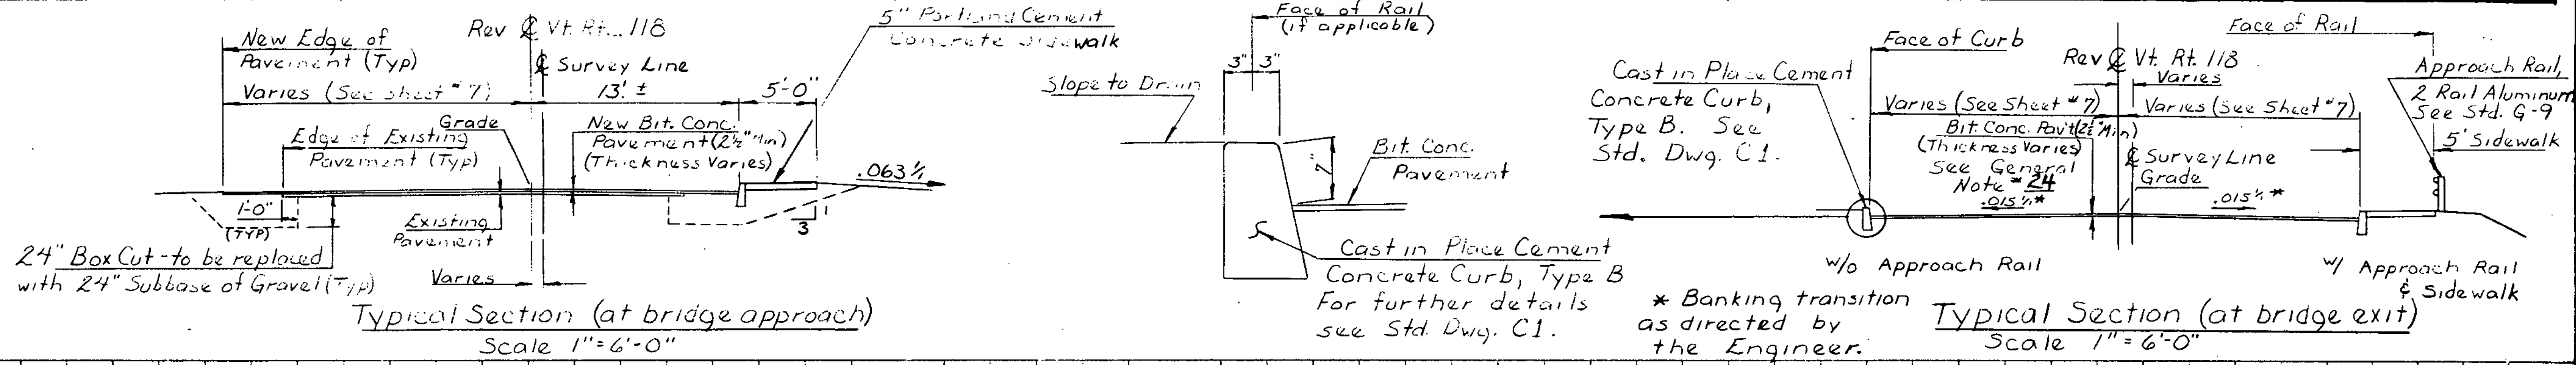


Survey Ties
NTS

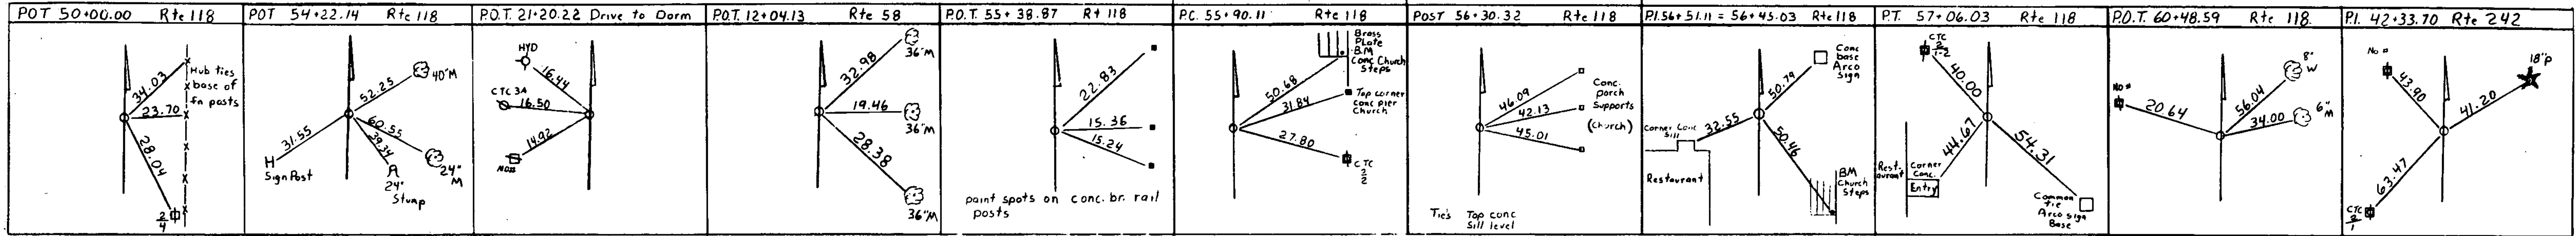

SURVEYED BY Fall DATE Jan 81
 DRAWN BY SK Jan 67 DATE Mar 81
 TRACED BY DATE
 Montgomery
 PROJ. BNS NO. 0283(6)S
 SHEET 3 of 46