


NOTE: SECTIONS A-A thru C-C appear on Sheet 14 of 46.

FF - Far Face  
NF - Near Face  
EF - Each Face

**ABUTMENT No. 1 PLAN**

Scale 3/8" = 1'-0"

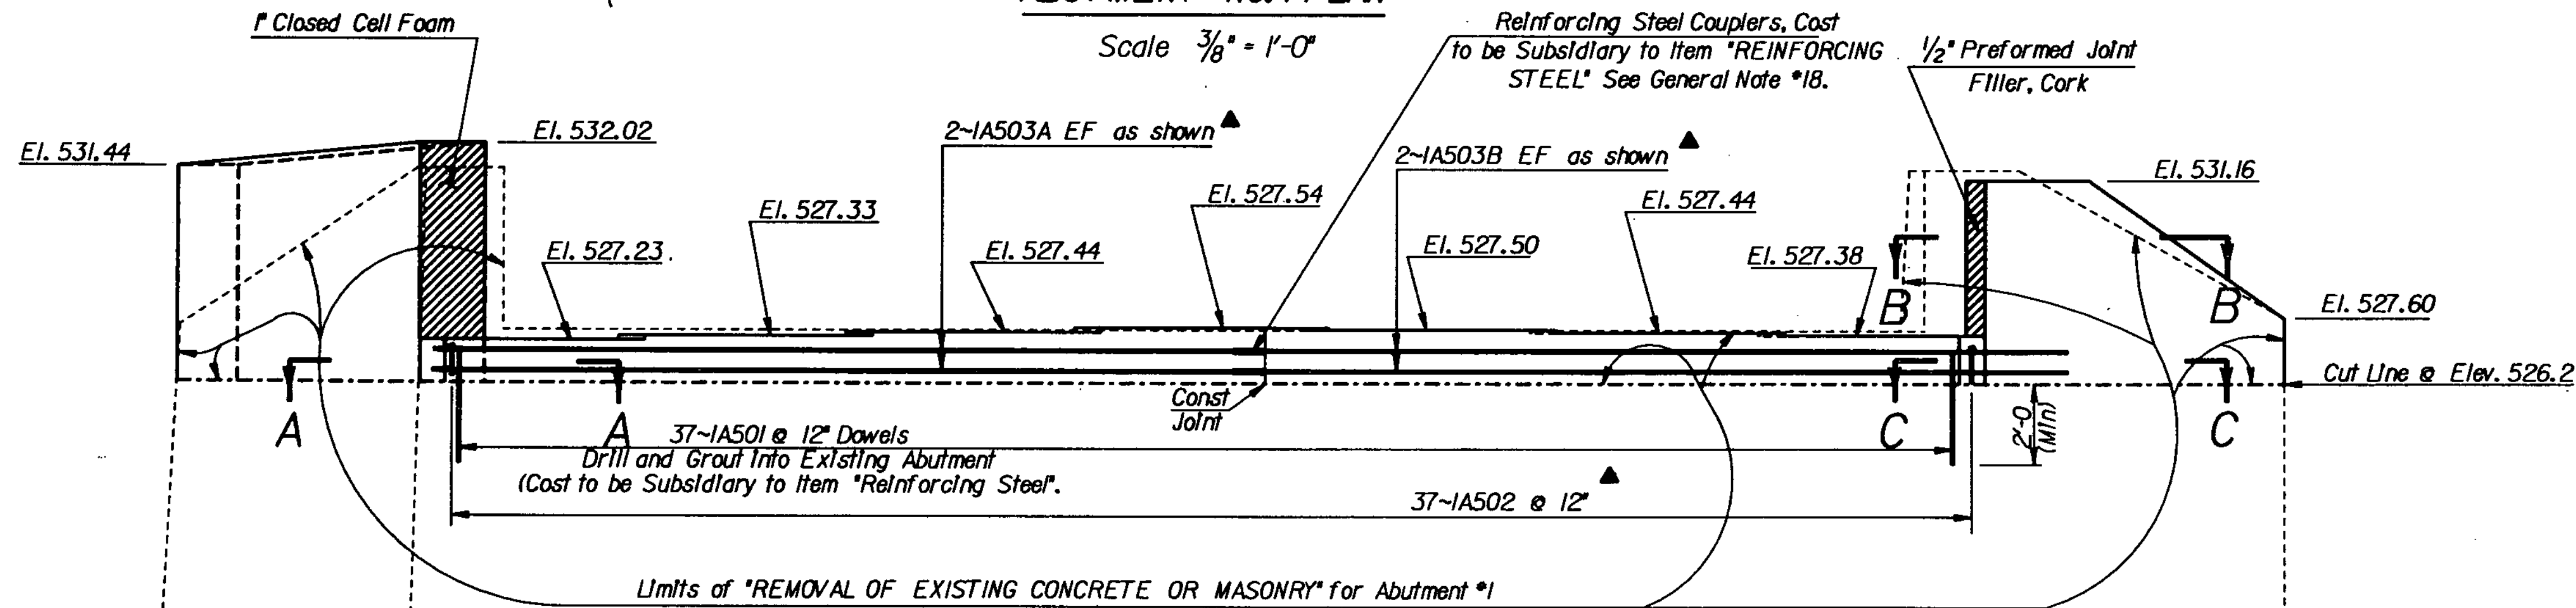

**ABUTMENT No. 1 ELEVATION**

Scale 3/8" = 1'-0"

**ABUTMENT No. 1 TYPICAL SECTION**

(ABUTMENT No. 2 SIMILAR)

Scale 1/2" = 1'-0"

<b>STATE OF VERMONT</b>			
<b>AGENCY OF TRANSPORTATION</b>			
Town Of	MONTGOMERY	Bridge No.	15
Highway No.	Vt Rte 118	Log Sta.	296+30
		Surv. Sta. Rev	55+62.85
Vt Rte 118 over the Trout River			
Abutment No. 1 Details			
Designed By	R. Sitaro	Drawn By	E. Blodgett
Checked By	R. Sitaro	Date	9/84
		Bridge Design Supervisor	F. N. Bolikum Date 12/84
PROJECT	MONTGOMERY	PROJECT NO.	BHS 0283(6)S
L.G.C. Info.	OSAM 302378E15ABLDGN		
Bridge Sheet No.	Sheet 12 of 46		