


ABUTMENT No.2 PLAN

Scale $\frac{3}{8}'' = 1'-0''$

FF - Far Face
 NF - Near Face
 EF - Each Face

▲ Cut to Fit In Field

NOTE: SECTION A-A thru D-D Appear on Sheet 14 of 46.

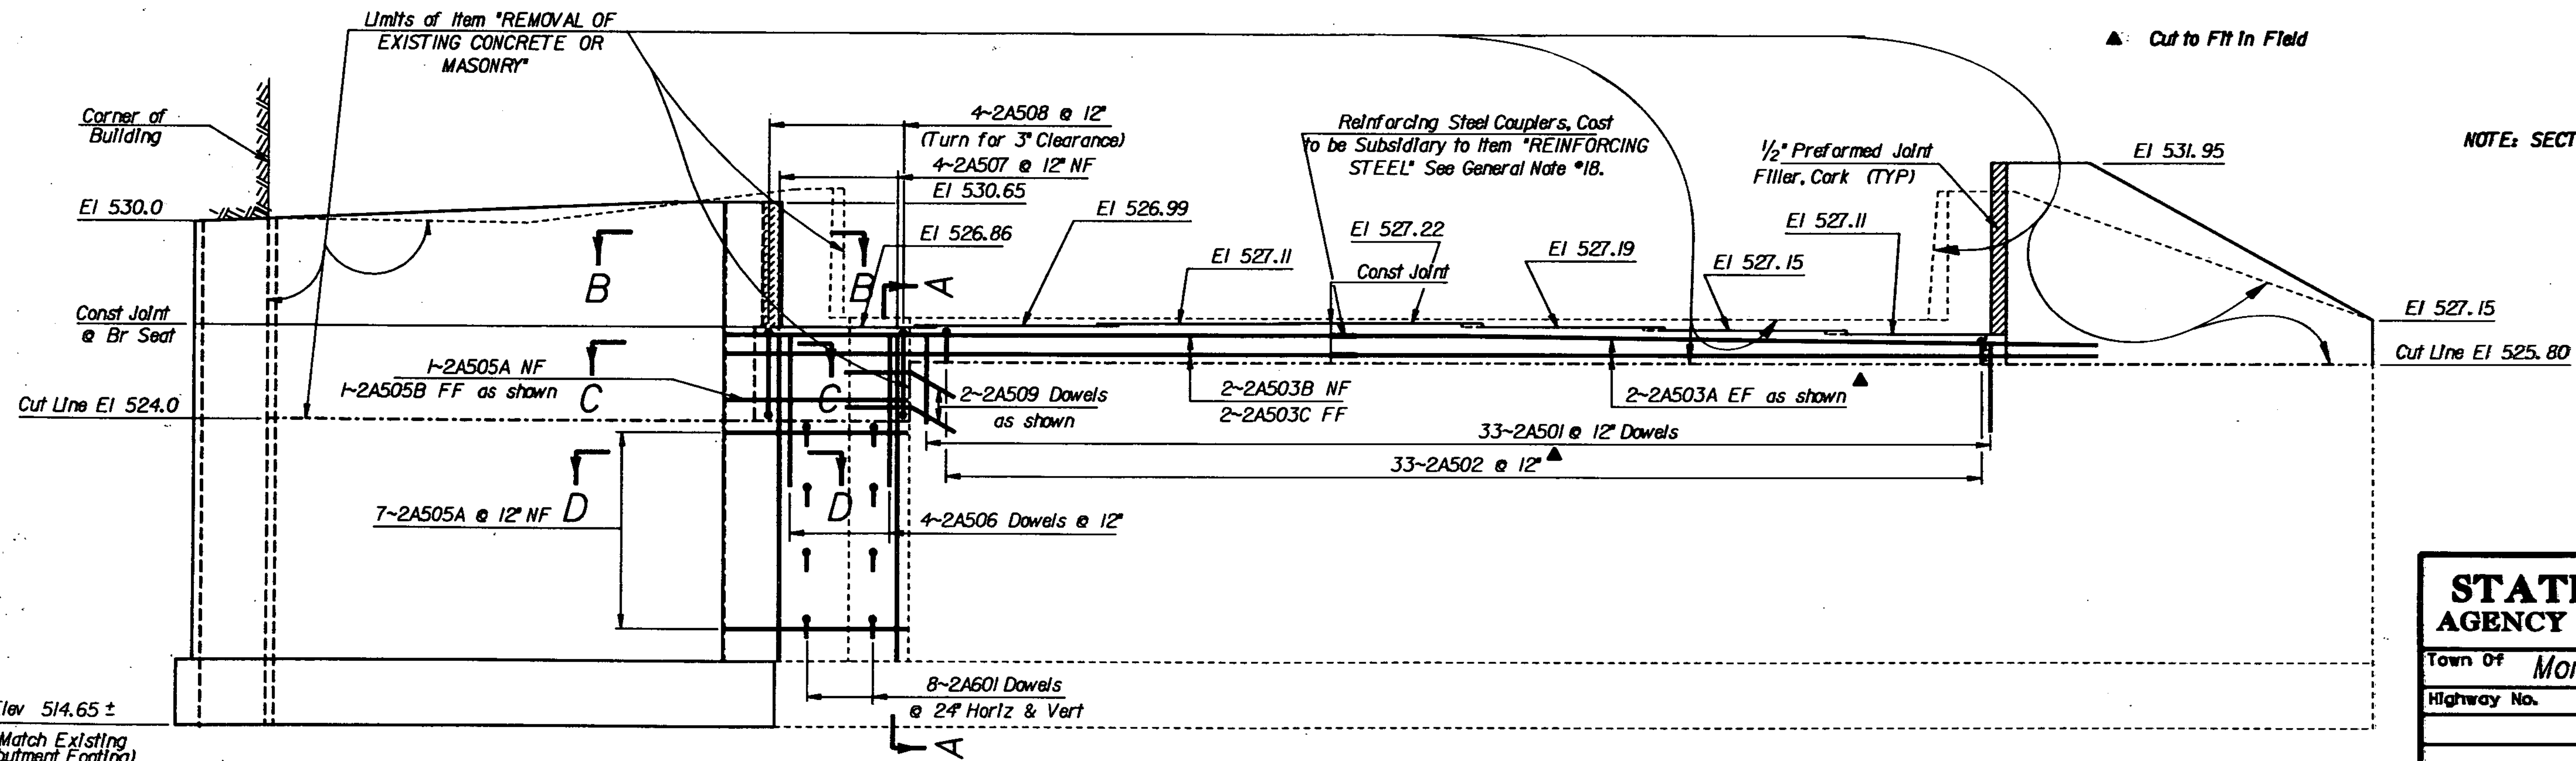

ABUTMENT No.2 ELEVATION

Scale $\frac{3}{8}'' = 1'-0''$

STATE OF VERMONT AGENCY OF TRANSPORTATION	
Town Of <i>Montgomery</i>	Bridge No. <i>15</i>
Highway No. <i>Vt Rte 118</i>	Log Sta. <i>296+30</i> Surv. Sta. <i>Rev 55+62.85</i>
<i>Vt Rte 118 over the Trout River</i>	
Abutment No.2 Details	
Designed By <i>K.R.Shaw</i>	Drawn By <i>E. Budge</i>
Checked By <i>K.R.Shaw</i>	Date <i>9/84</i>
Bridge Design Supervisor <i>J.F.W. Balkum Date 12/84</i>	
PROJECT <i>Montgomery</i>	PROJECT NO. <i>BHS 02831615</i>
L.G.C. Info. <small>OS&S/12/25/78/BS/ARZ/DOR</small>	
Bridge Sheet No.	Sheet <i>13</i> of <i>46</i>