


Rev Sta 54+65 Begin Project  
Construct Satisfactory Approach

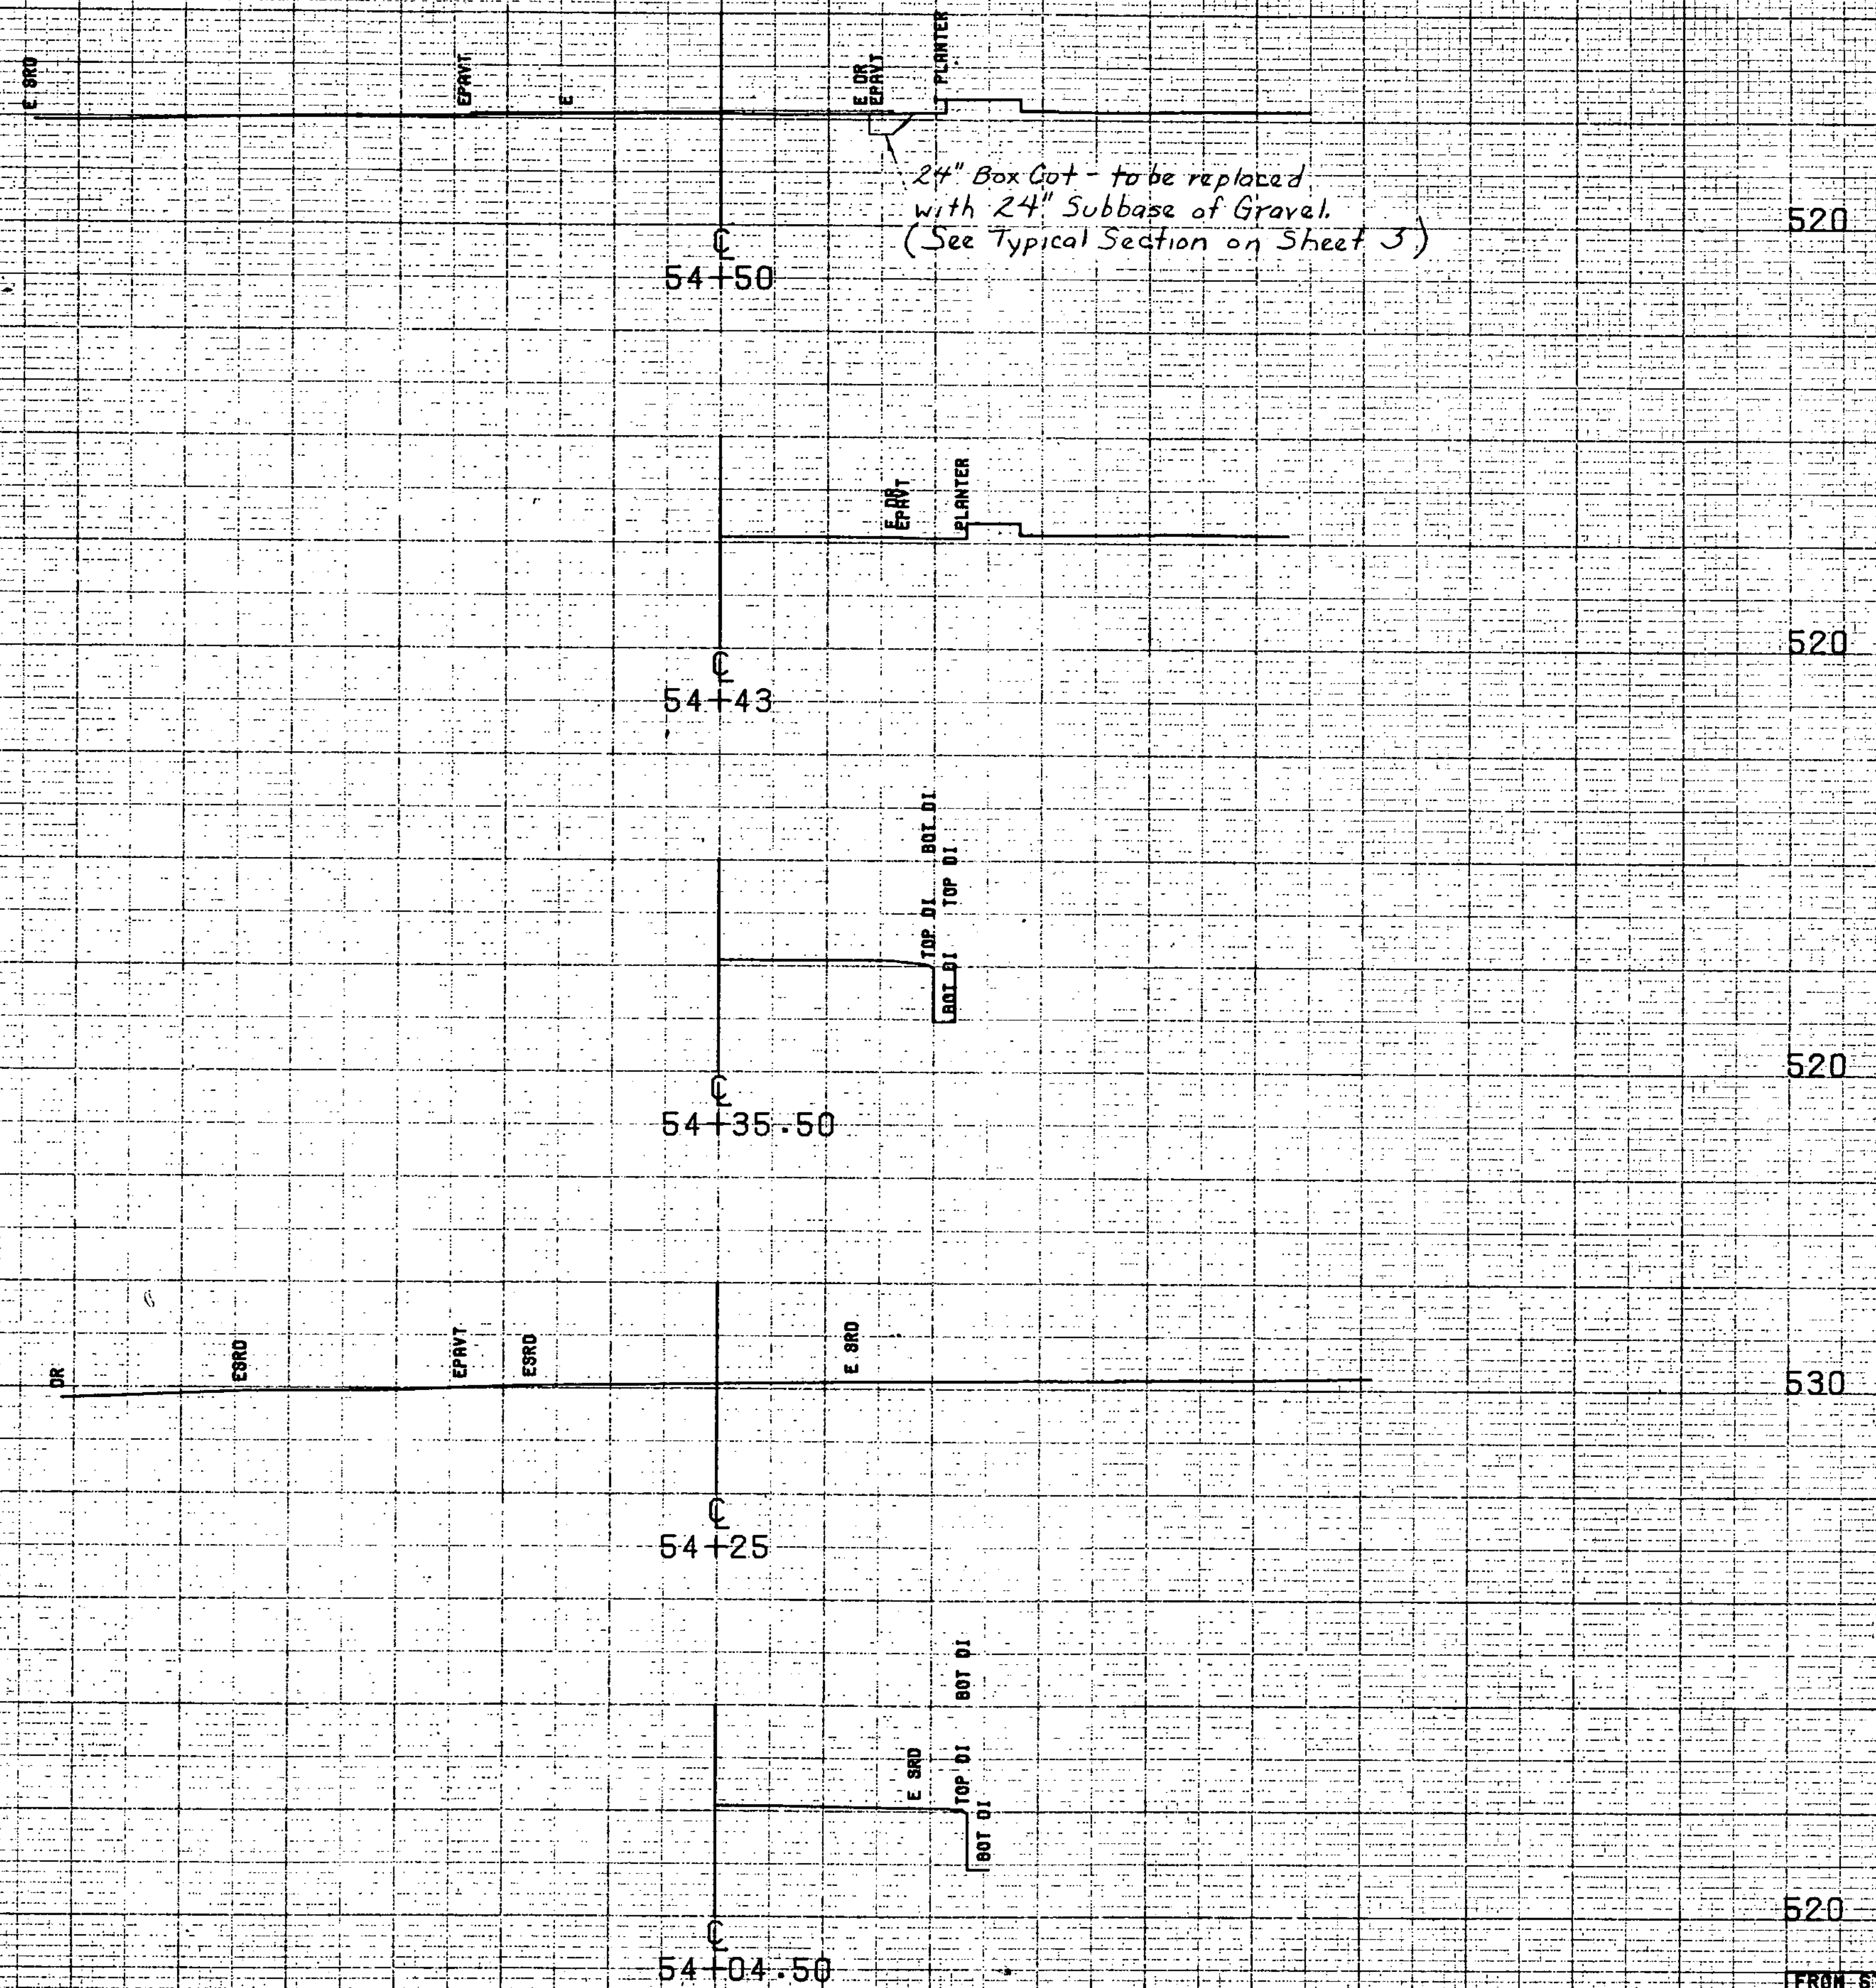

FROM STA. 54+04.50 TO STA. 54+50  
PROJECT NAME: MONTGOMERY MAIN  
NO. 244-10283(6)S  
SURVEYED BY: FALL  
SHEET 16 OF 26 SHEETS  
PLOTTED 03/08/81  
12-80/1-81

SCALE: 1" = 10'