




520

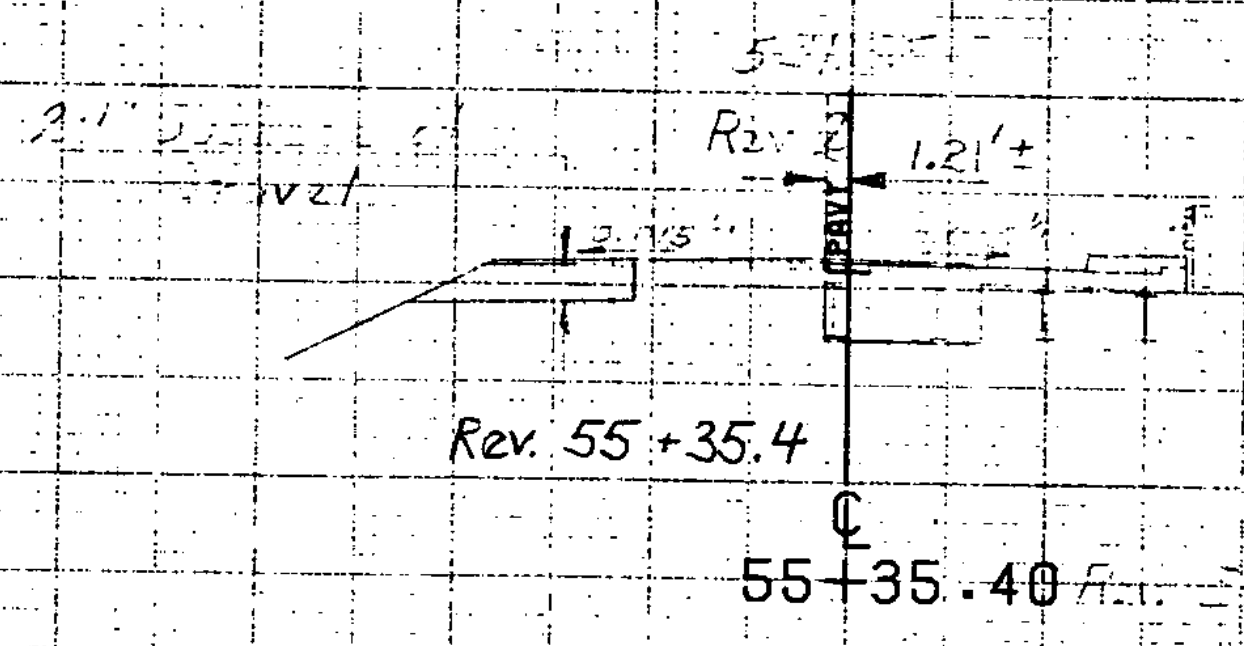

520

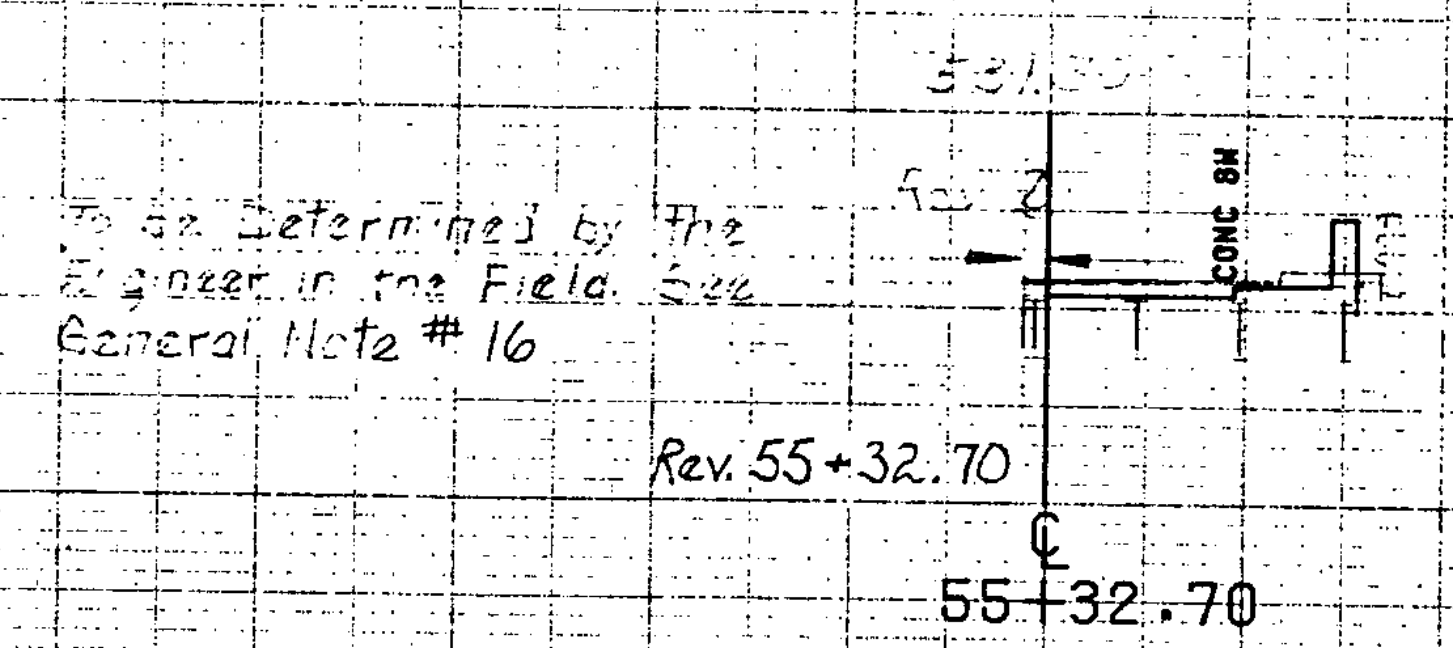

530

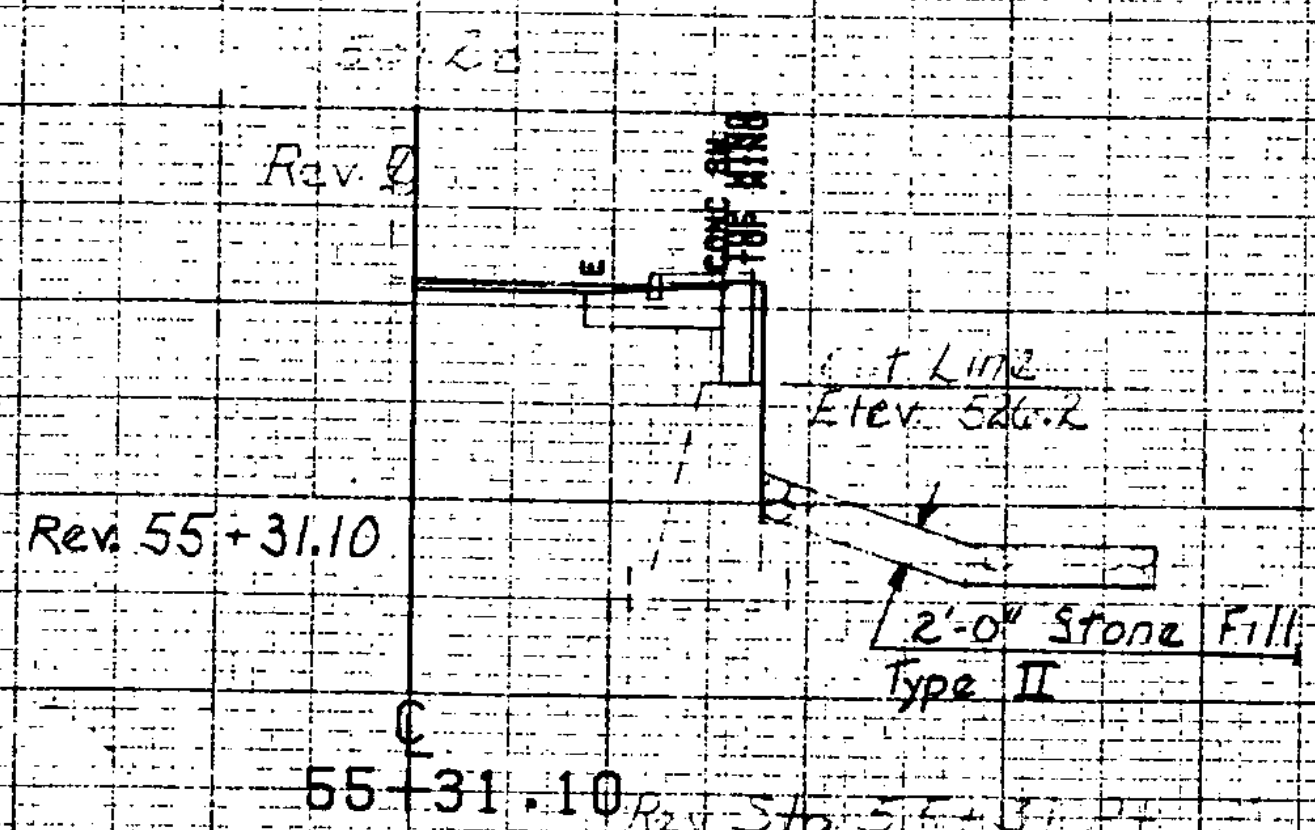

520

Rev. Sta. 55+11.9 - Begin Approach
2 R.R. Abutments

Rev. Sta. 55+31.0 - Begin Bridge Rail
near Rail

FROM STA. 55+31.10 TO STA. 55+39.70
PROJECT NAME MONTGOMERY MAIN
NO. 015-0288(6)S PLOTTED 08/09/81
SURVEYED BY FALL 12-00/1-81
SHEET 20 OF 42 SHEETS

SCALE 1"=10'