

520


29+90



510

29+85.20


Sta. 29+85 Rt. Begin Structure Excavation

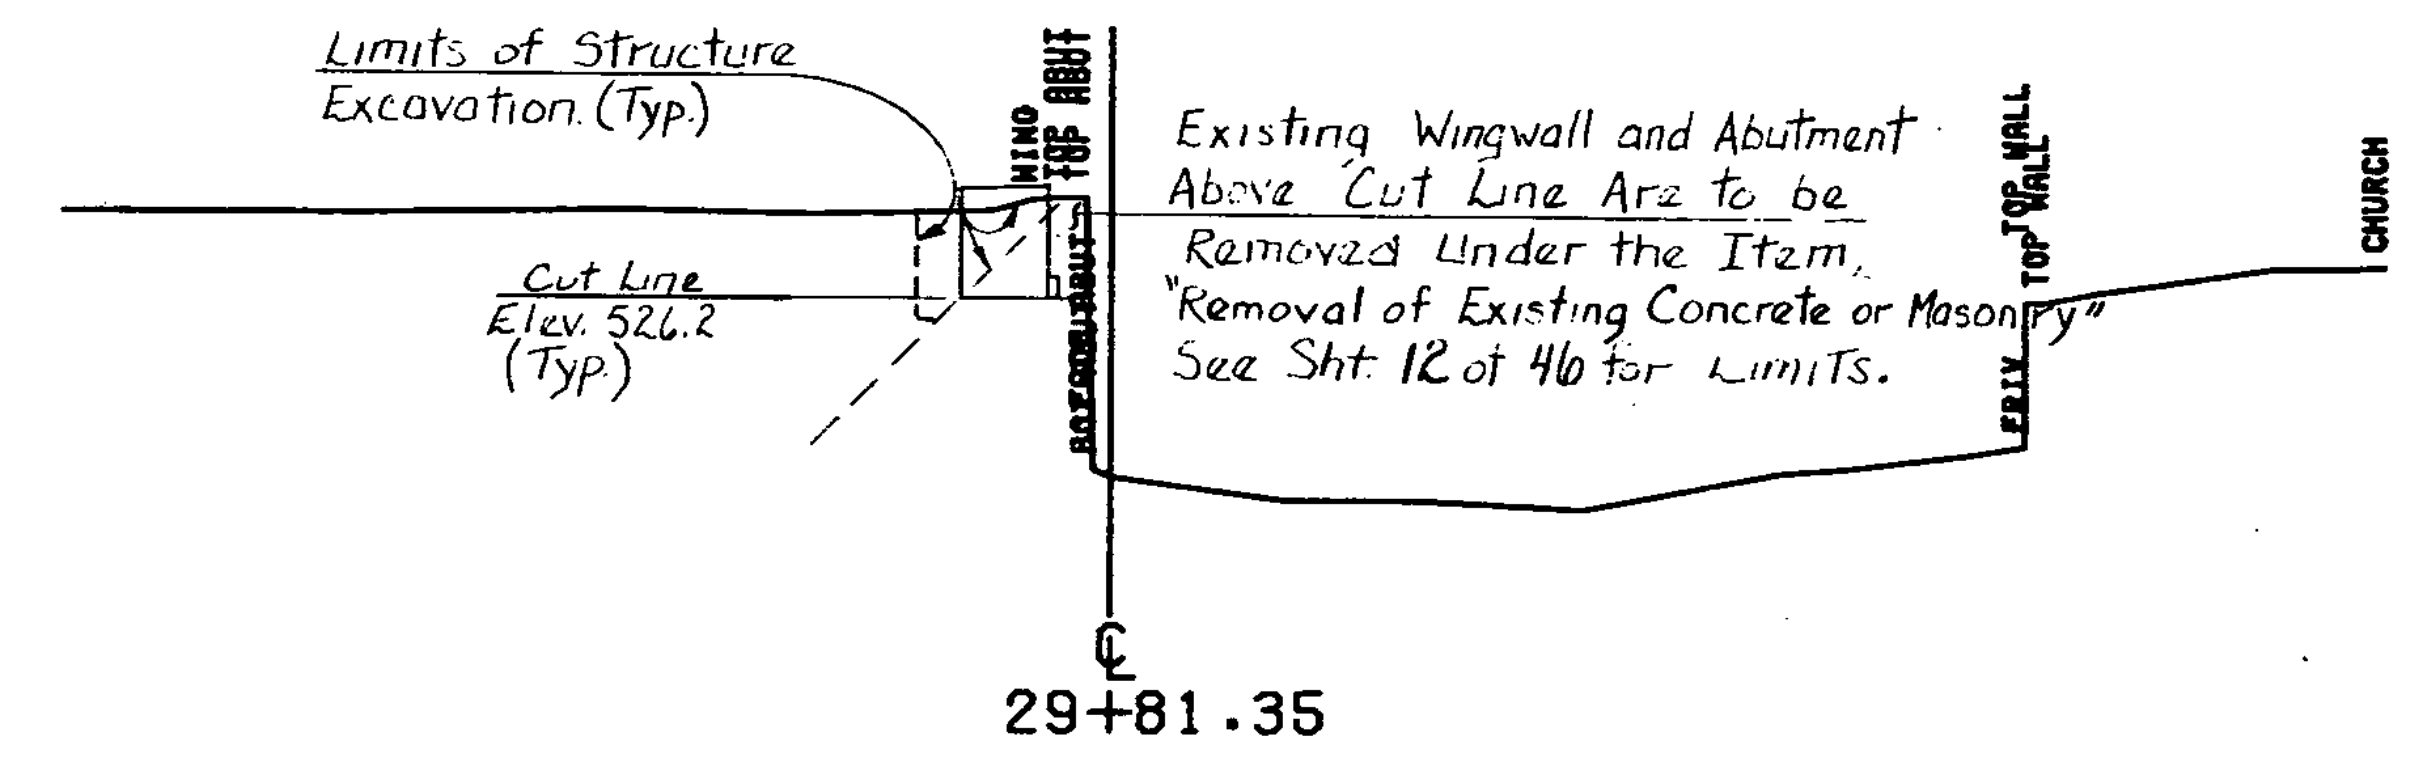

520

29+81.35

Sta 29+81 Lt. End Unclassified Channel Excavation.
End Stone Fill, Type II.

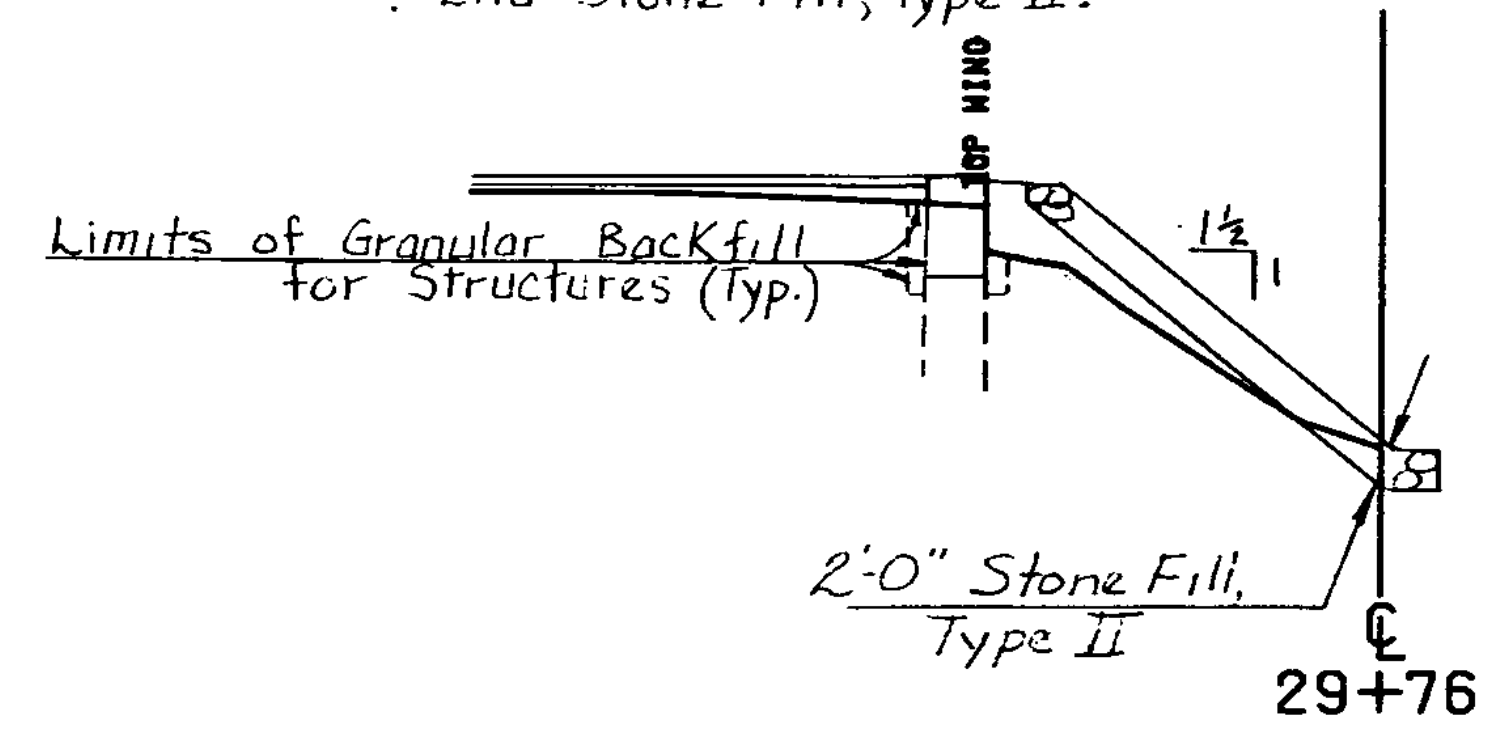

520

29+76

Sta 29+75 Lt. Begin Structure Excavation

SCALE 1" = 40 FEET

FROM STA. 29+76	TO STA. 29+80
PROJECT NAME	MONTGOMERY CHAN
NO. BMS-0269(6)S	PLOTTED 03/09/81
SURVEYED BY FALL	12-80/1-81
SHEET 27 OF 46 SHEETS	