


ABUTMENT#1 TYPICAL WINGWALL SECTION
(NOT TO SCALE)

SEE SUBSTRUCTURE EARTHWORKS SHEET 1
FOR ADDITIONAL DETAIL AND NOTES.

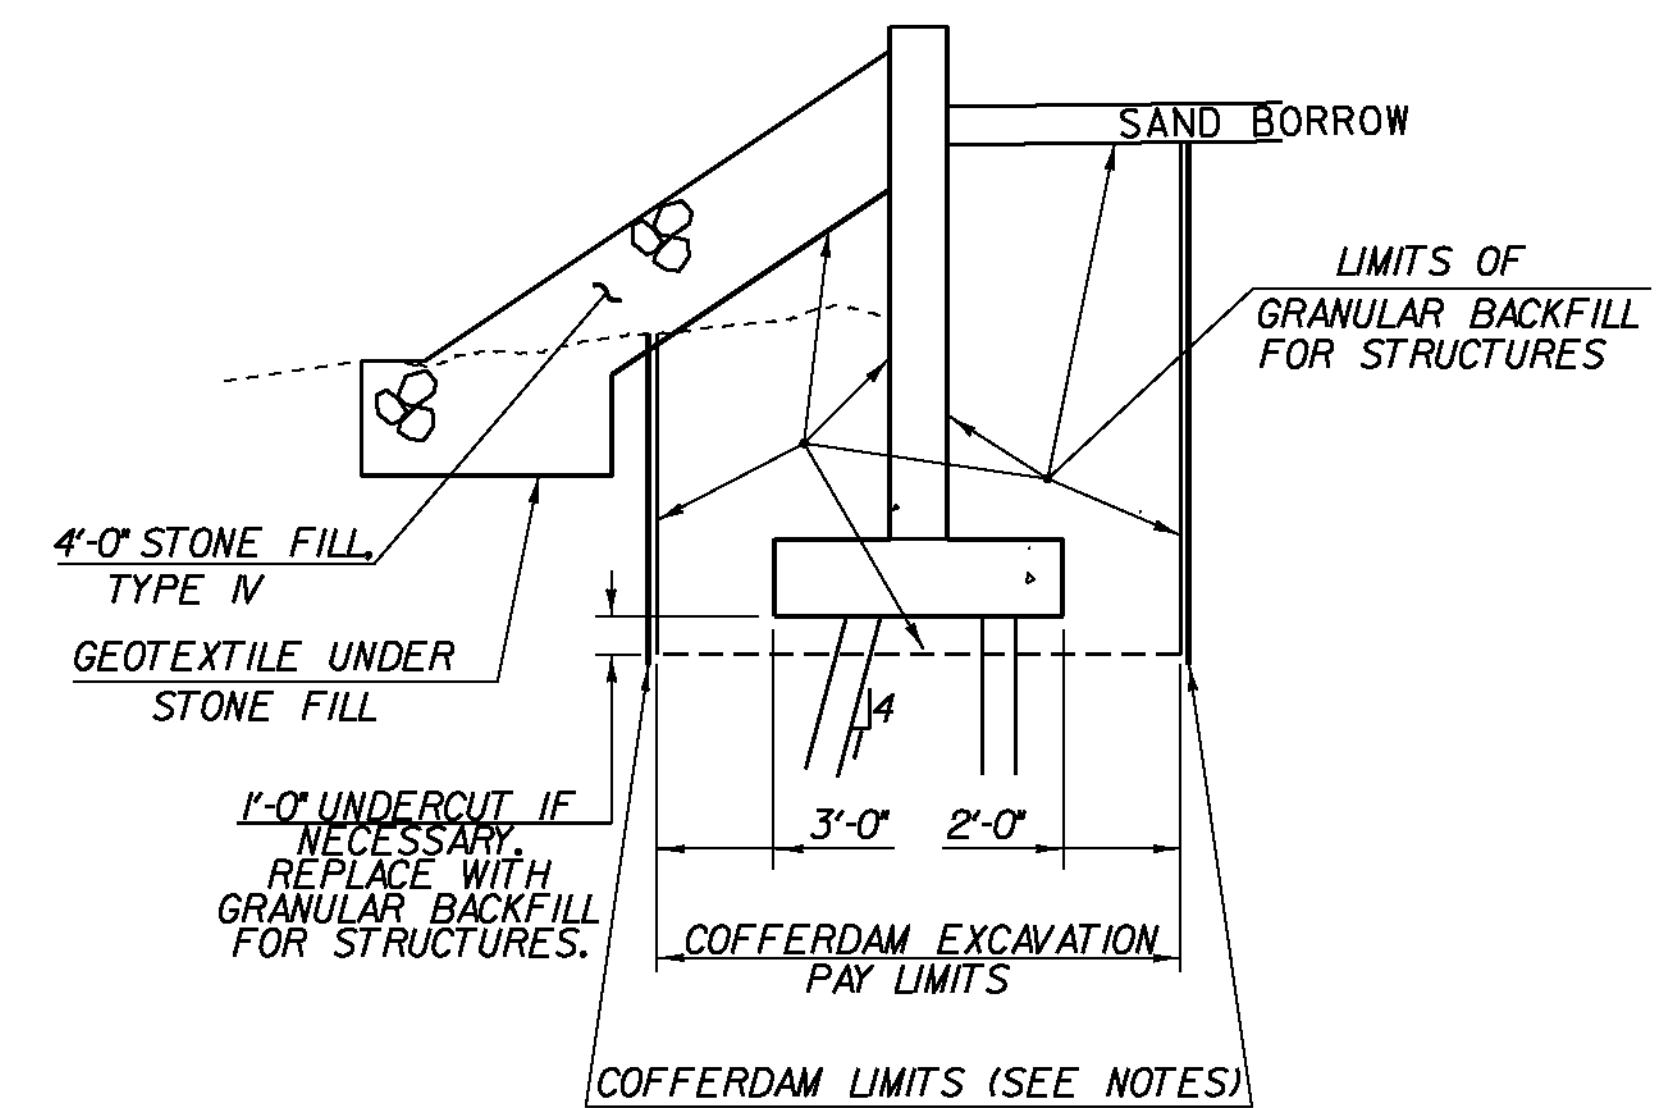

ABUTMENT#2 TYPICAL WINGWALL SECTION
(NOT TO SCALE)

SEE SUBSTRUCTURE EARTHWORKS SHEET 1
FOR ADDITIONAL DETAIL AND NOTES.

PROJECT NAME:	BETHEL	FILE NAME:	sf161+yp.dgn	PLOT DATE:	20-MAY-2011
PROJECT NUMBER:	BRF 022-1(14)	PROJECT LEADER:	M. EVANS-MONGEON	DRAWN BY:	G. ROKES
		DESIGNED BY:	S. SCRIBNER	CHECKED BY:	S. SCRIBNER
		SUBSTRUCTURE EARTHWORKS SHEET 2		SHEET	8 OF 148