

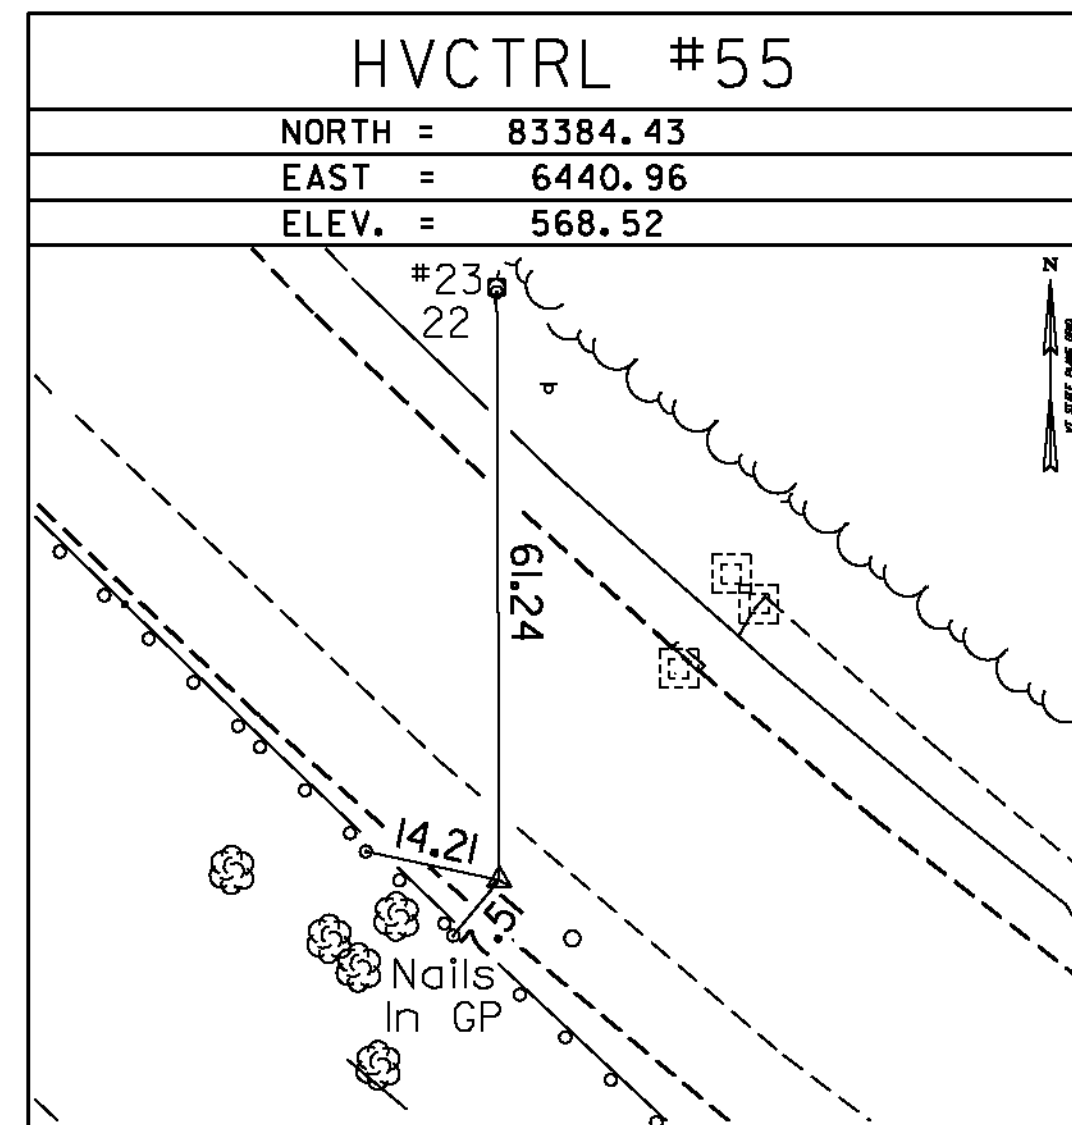
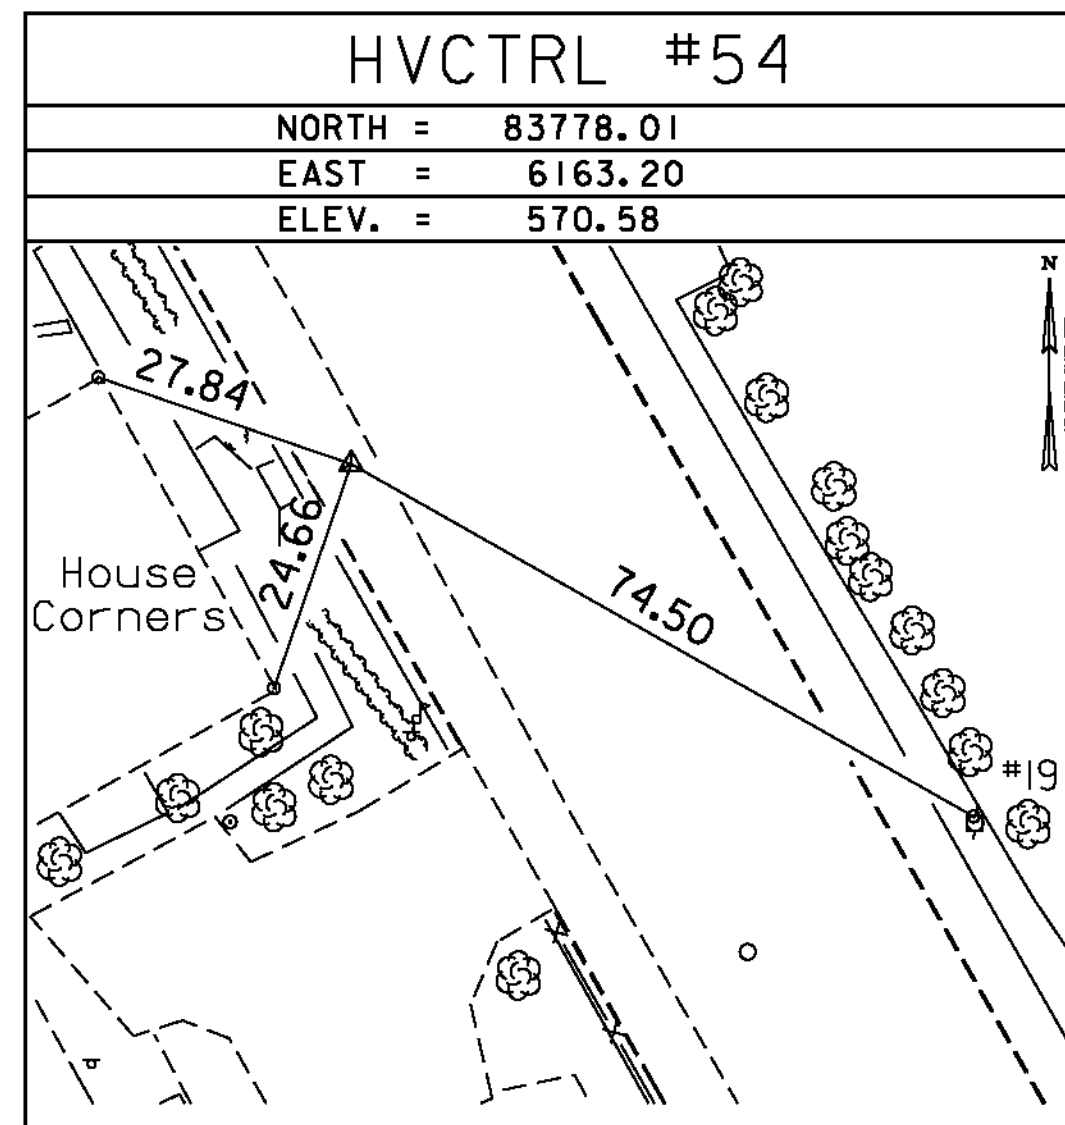


Traverse Ties





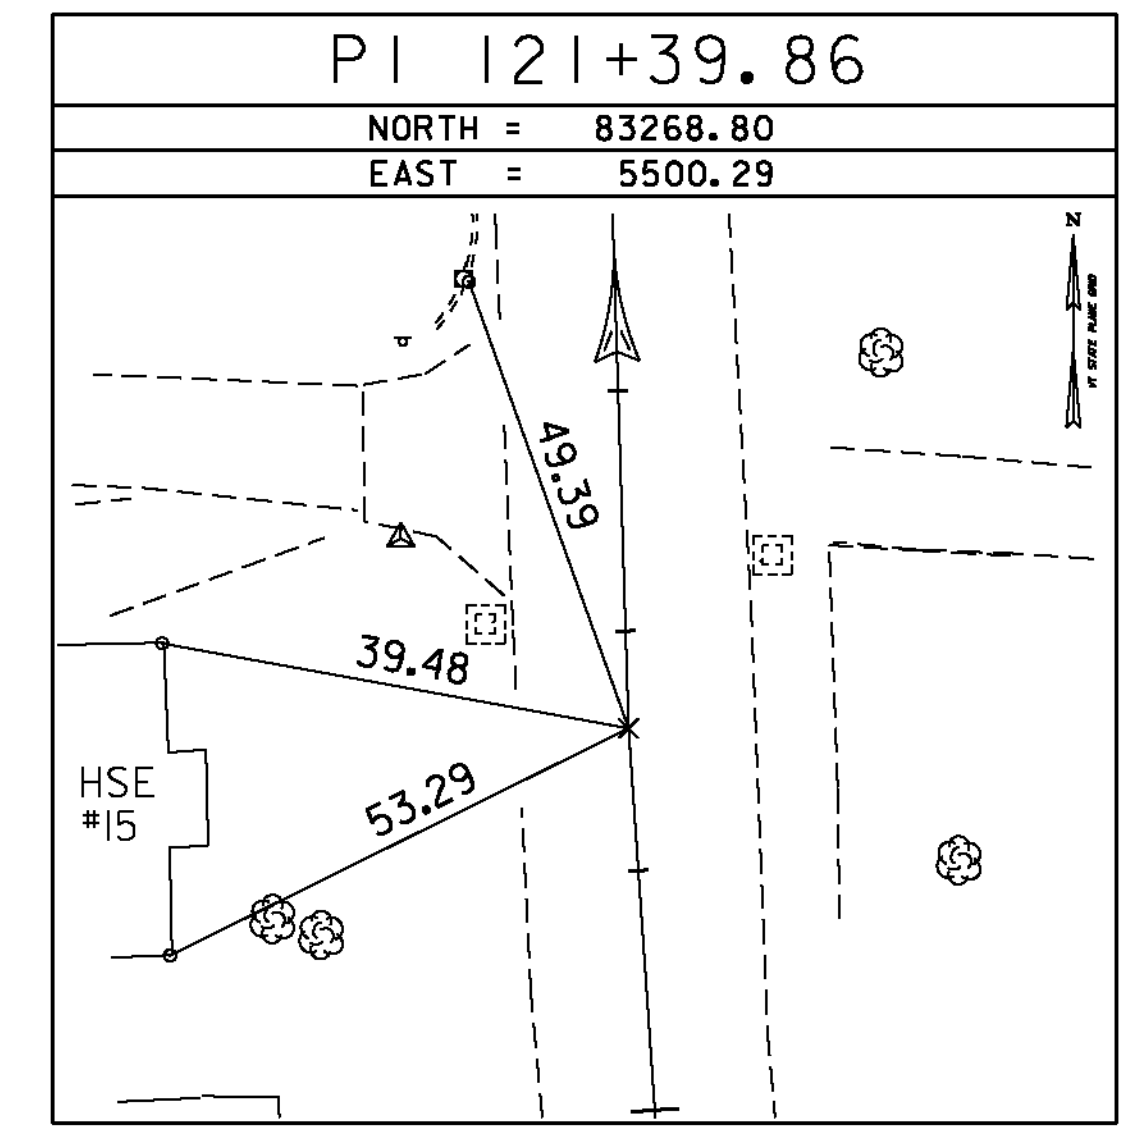


ALIGNMENT TIES




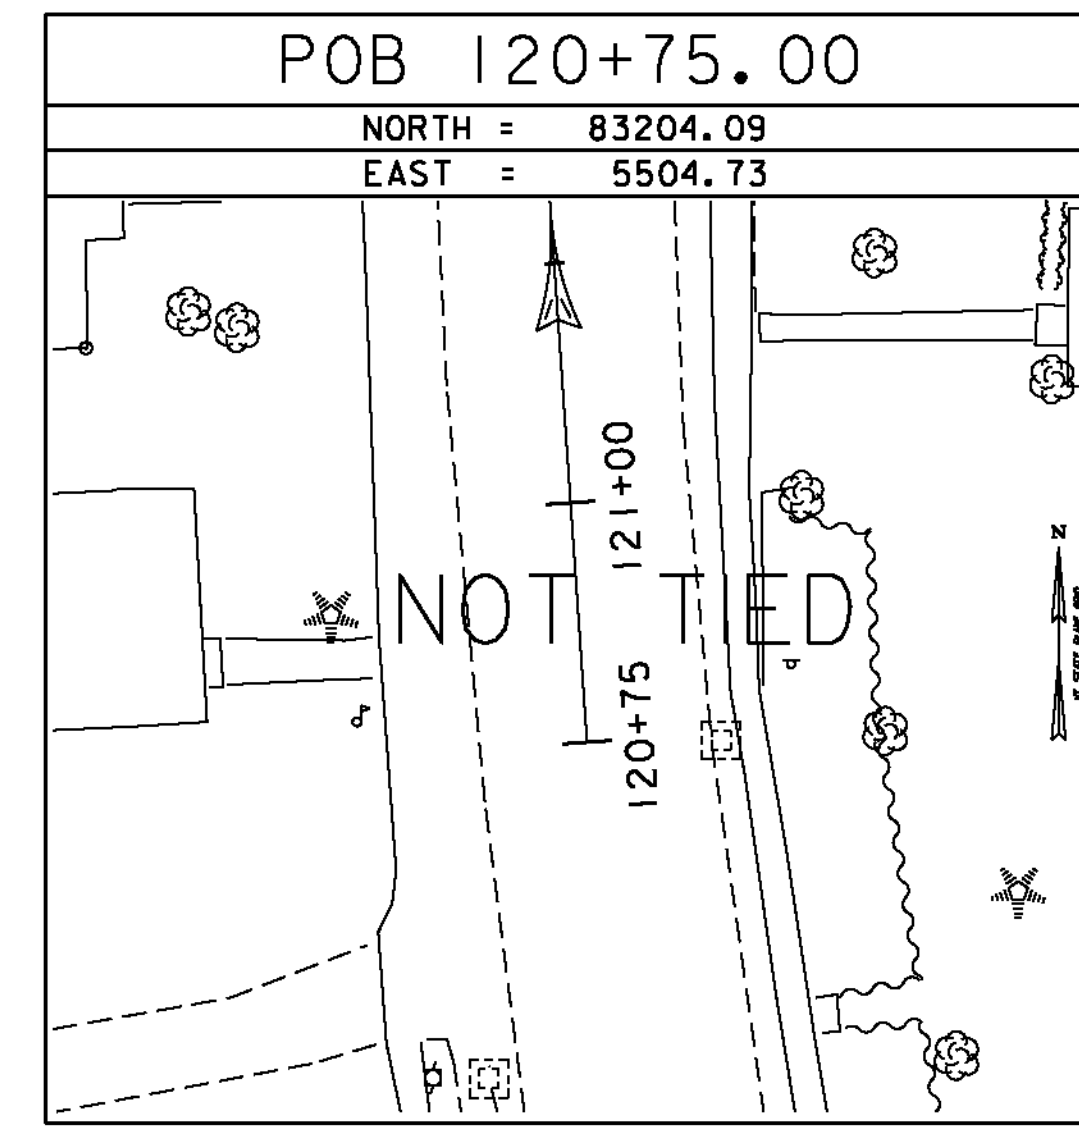


• Alignment Staked 3/22/07 by R.Gilman P.C. & P.Winters & R.Bullock

Alignment Ties

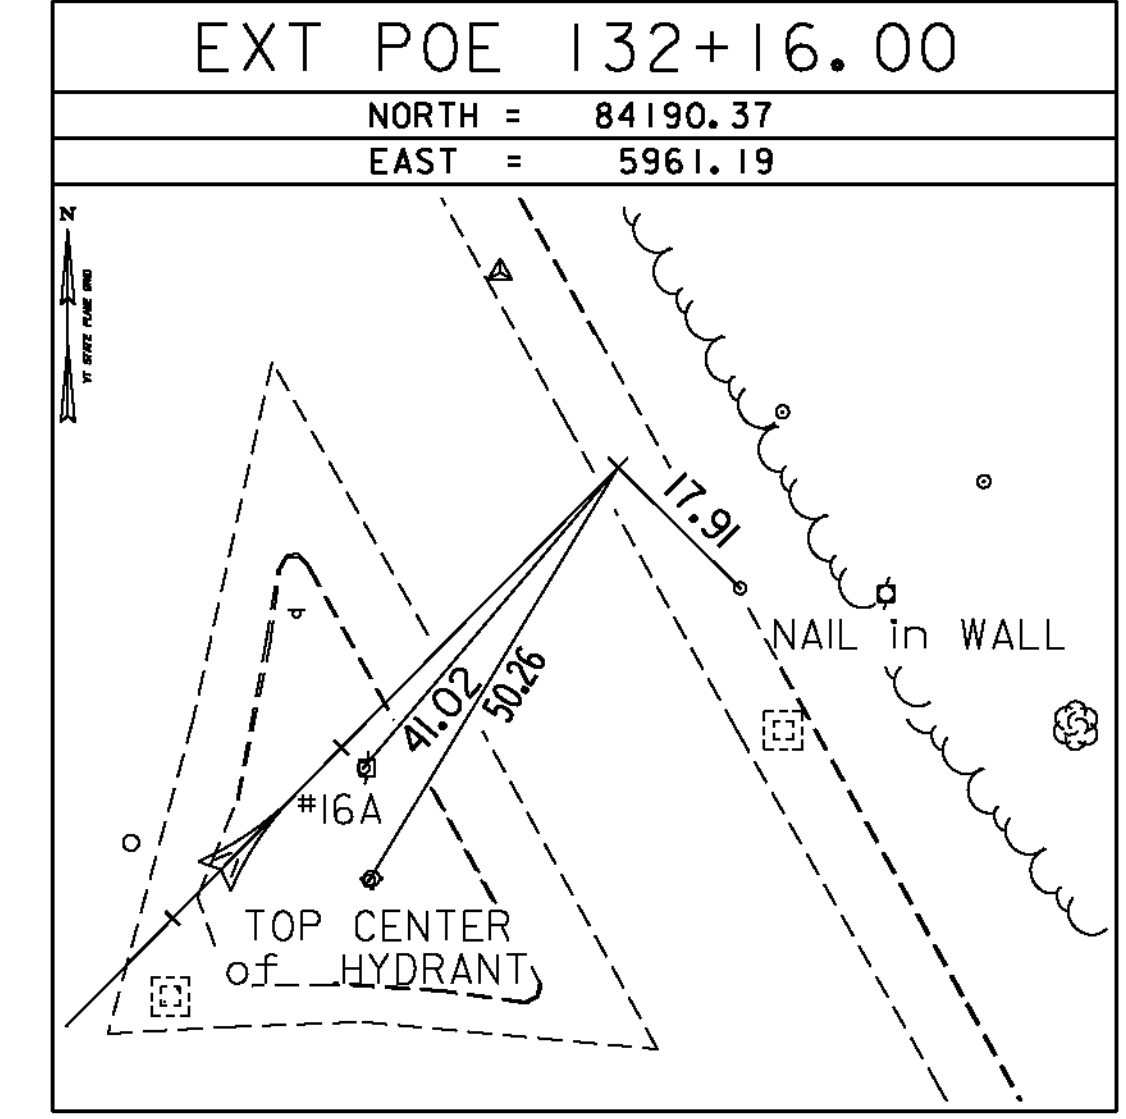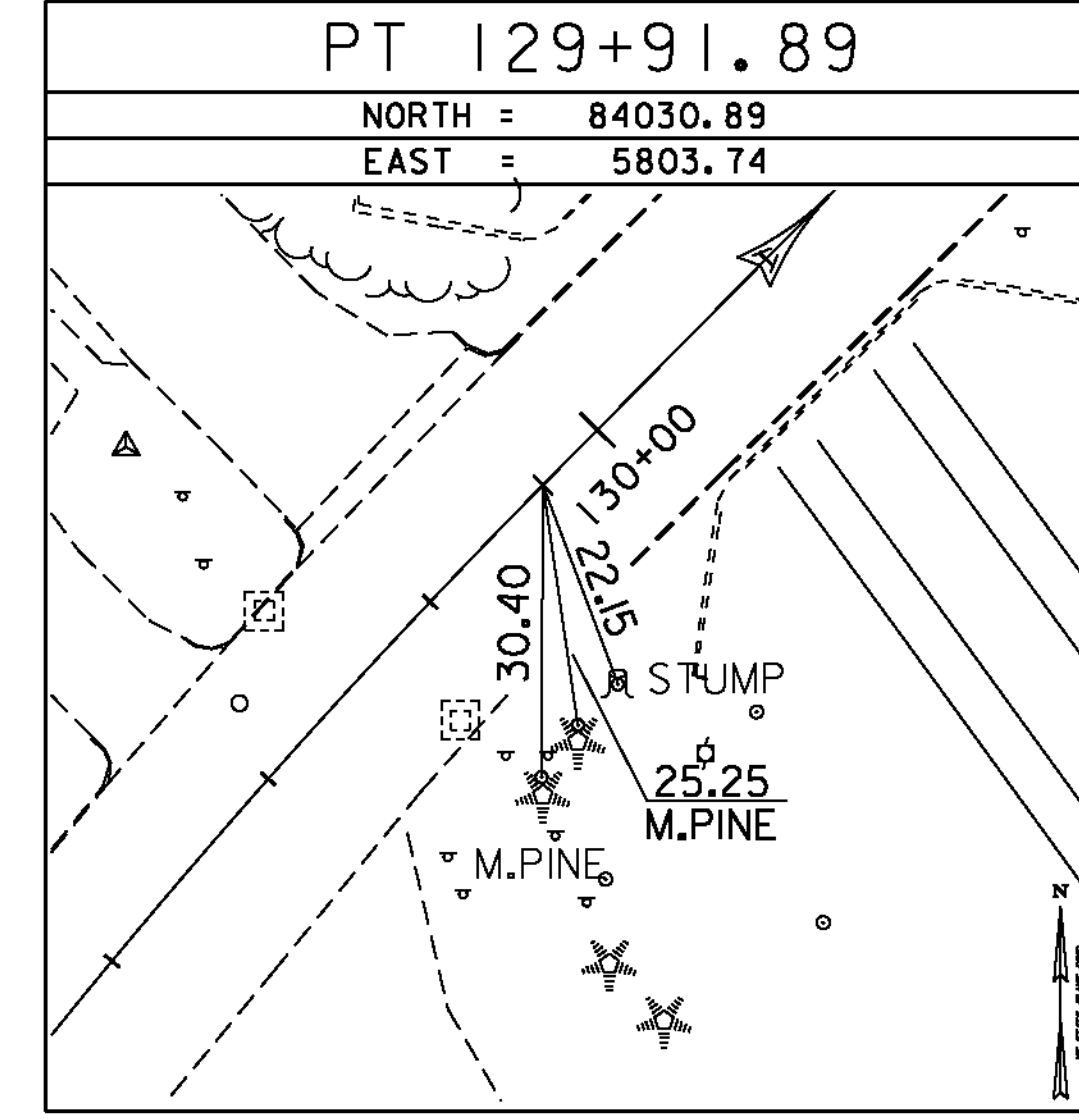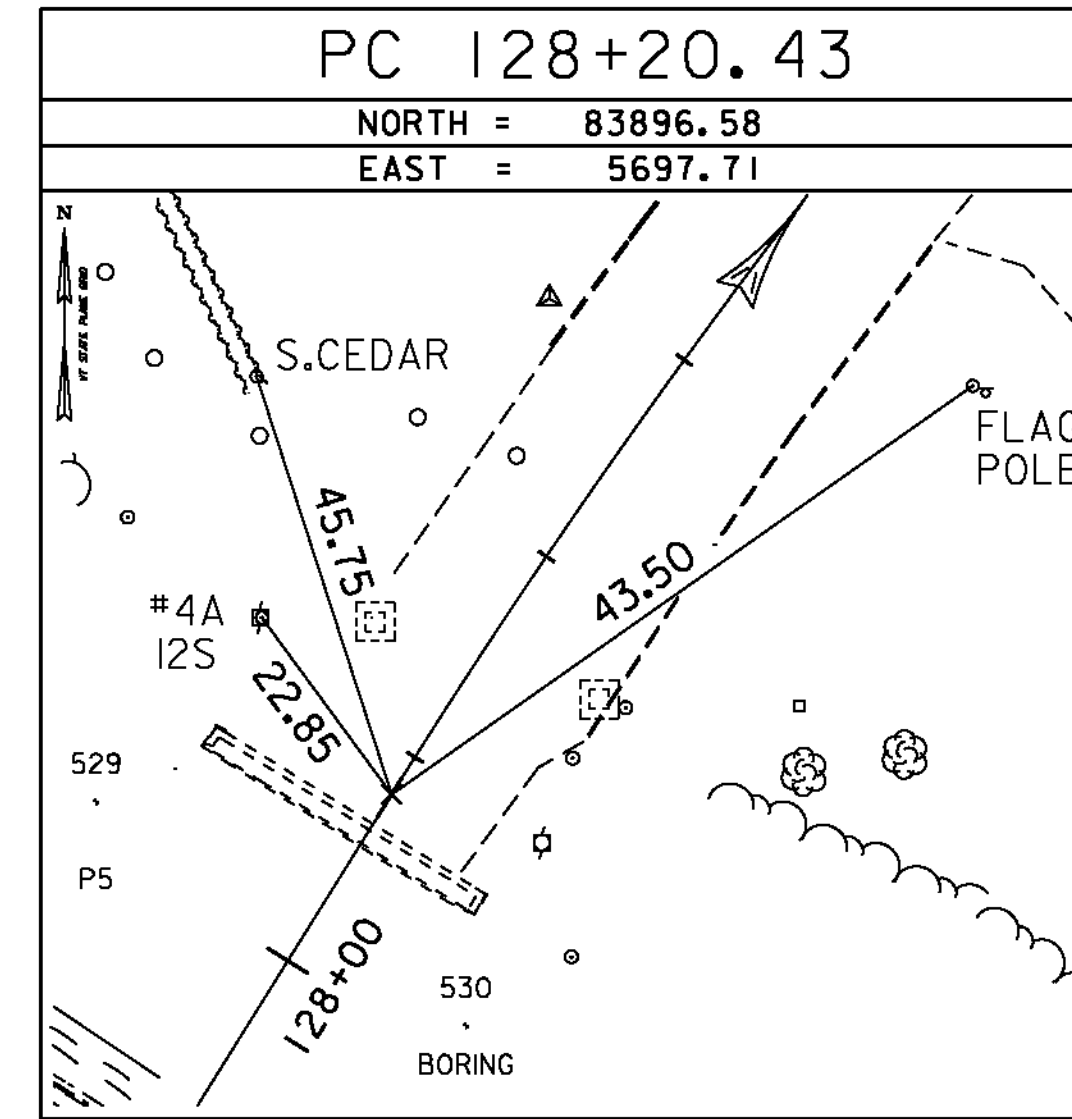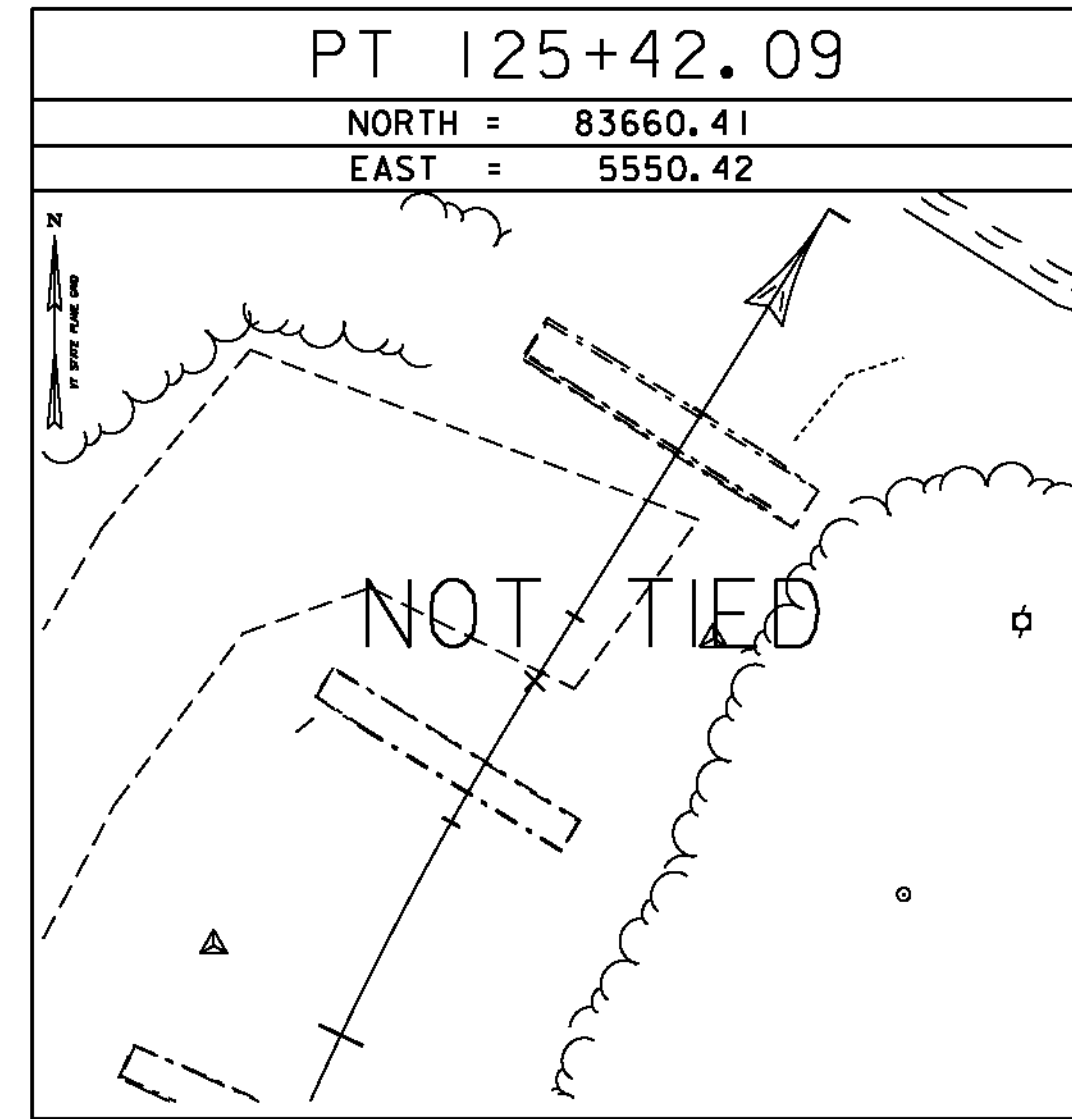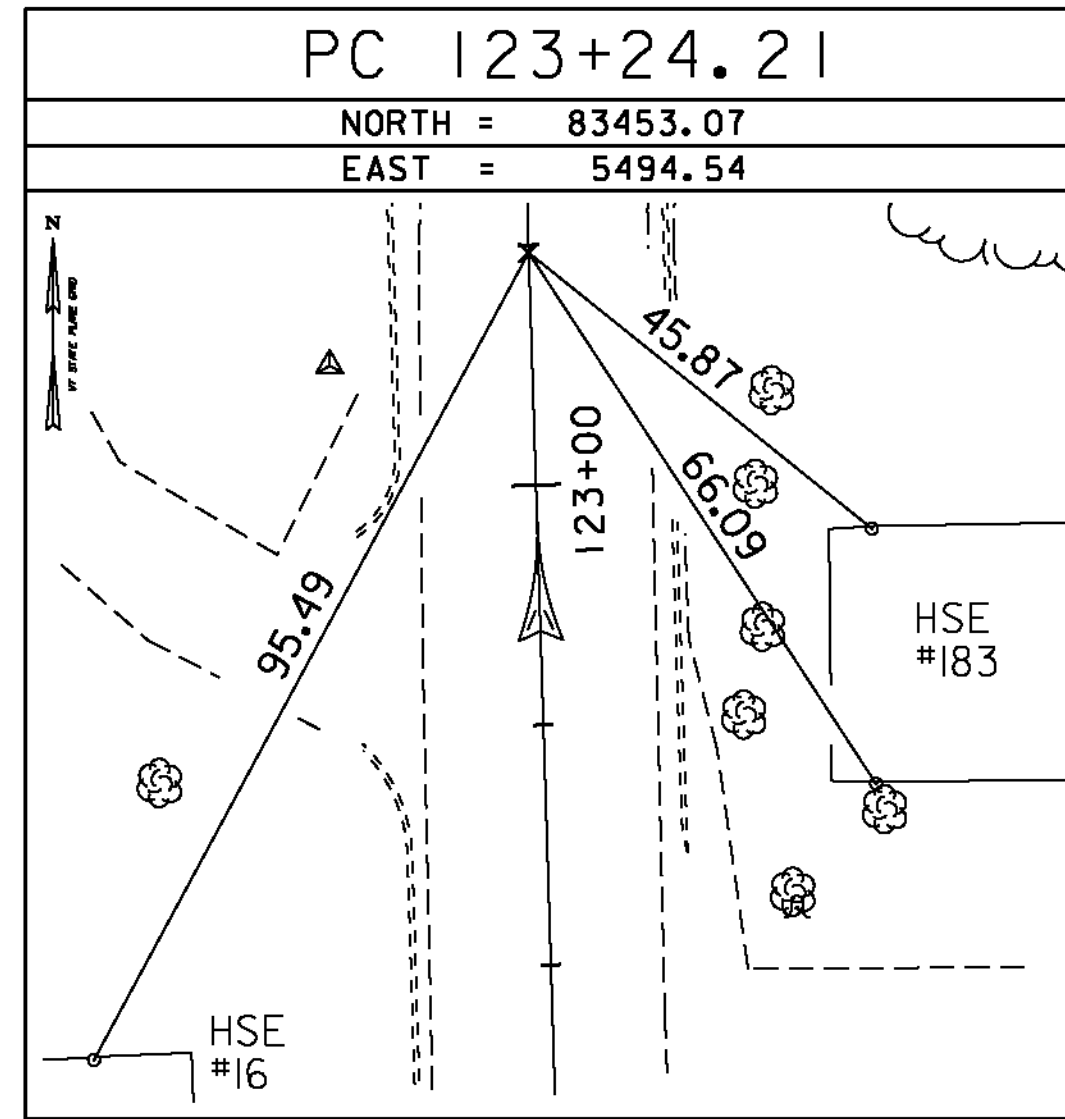

ALIGNMENT TIES

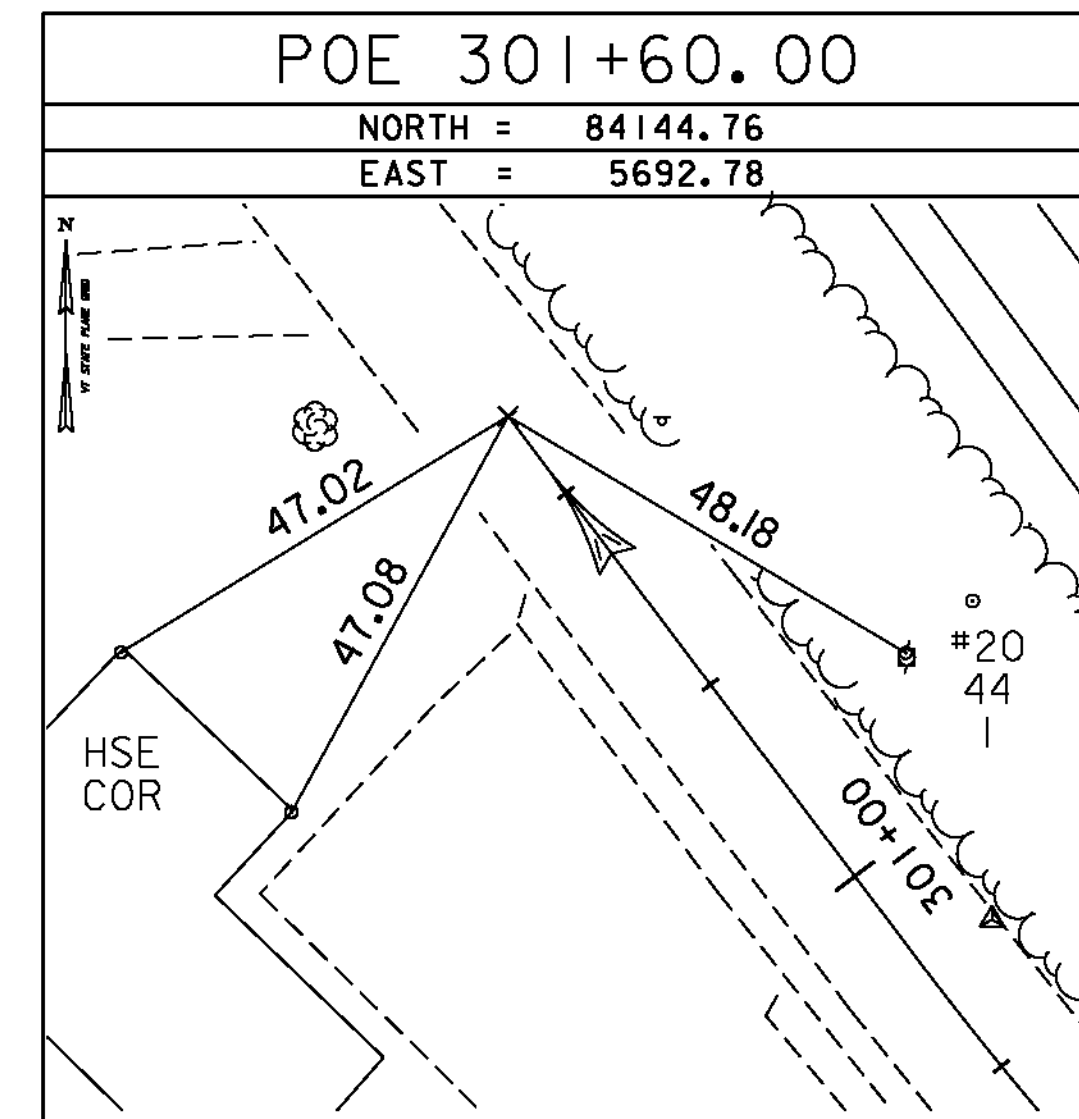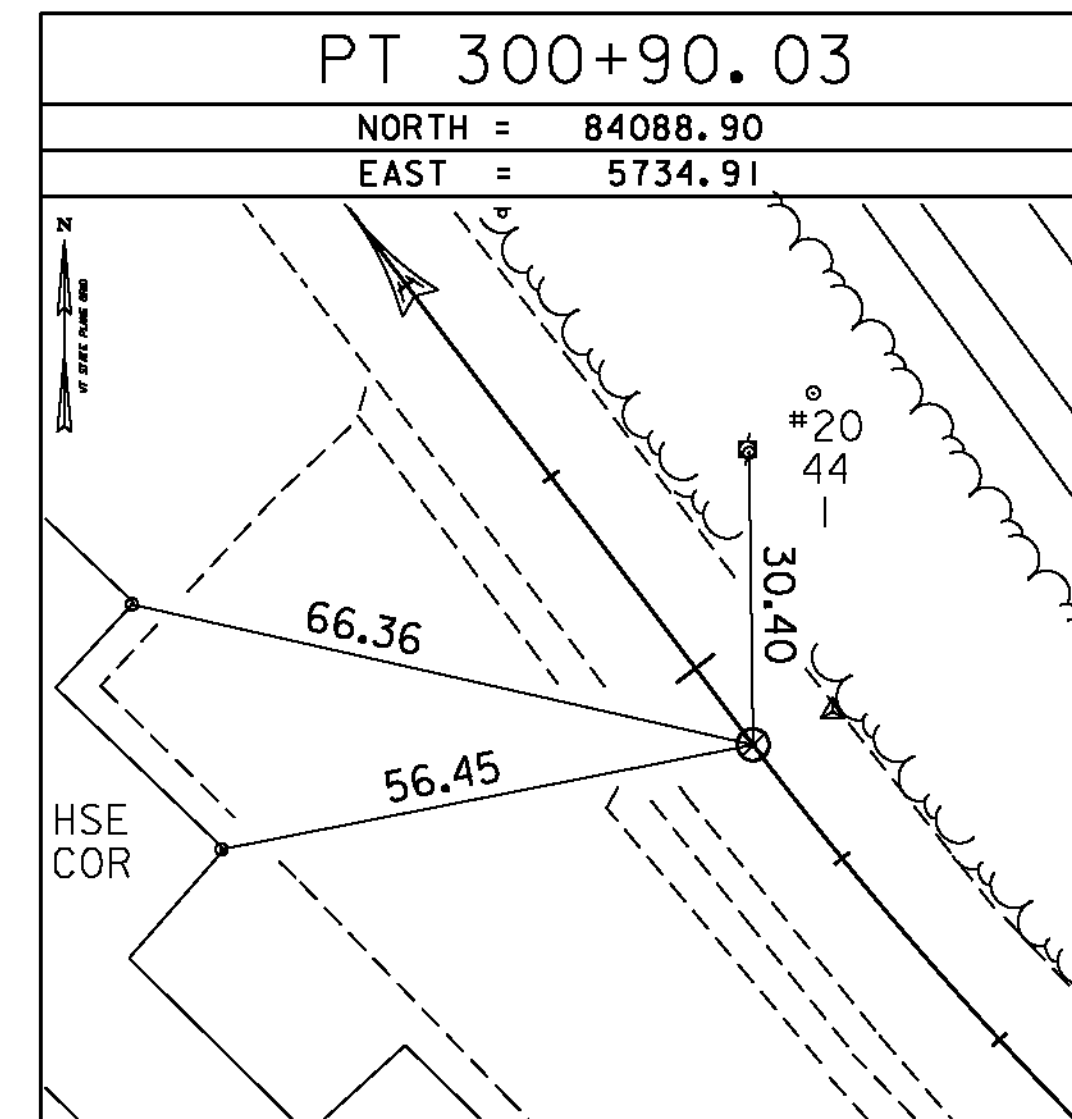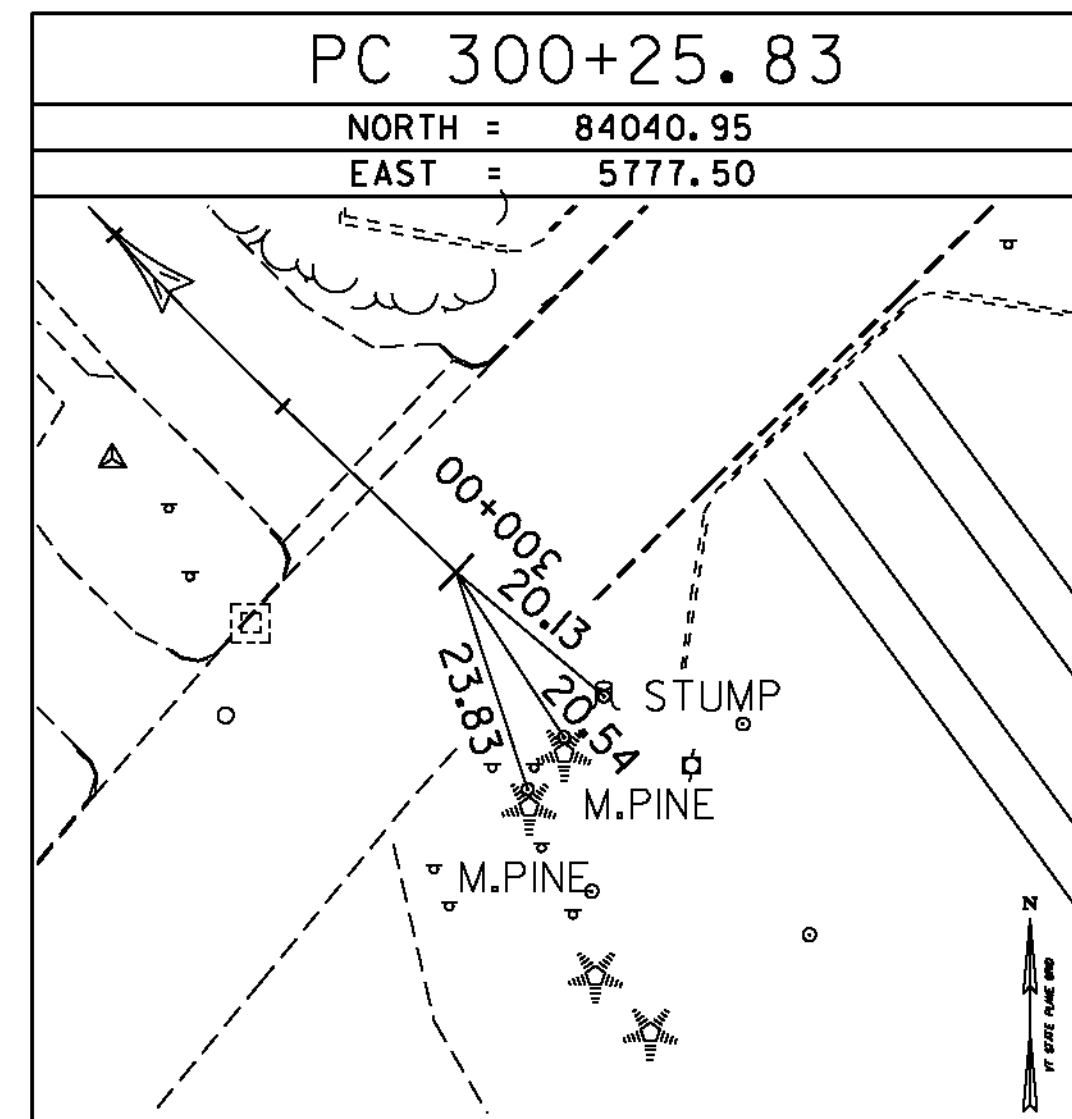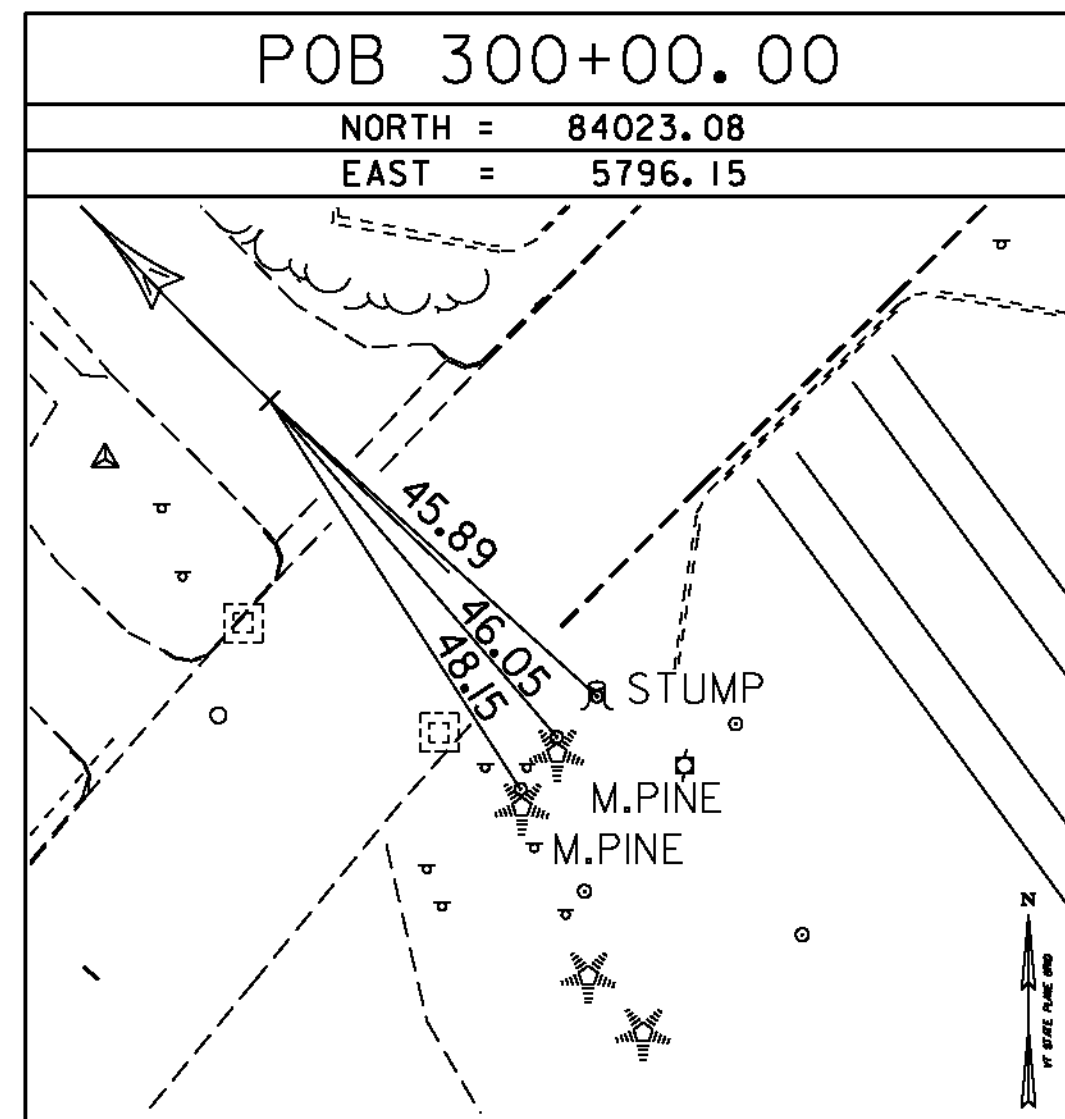

PEVINE BLVRD

DATUM	
VERTICAL	NAVD 88
HORIZONTAL	NAD 83 (92)
ADJUSTMENT	Compass

PROJECT NAME:	BETHEL
PROJECT NUMBER:	BRF 022-1(14)
FILE NAME:	78f161\survey\78f161t.dg
PROJECT LEADER:	Martha Evans-Mongeon
DESIGNED BY:	
TIE SHEET 2 OF 2	
PLOT DATE:	20-MAY-2011
DRAWN BY:	R. Bullock
CHECKED BY:	
SHEET 15	OF 148