


DRAINAGE

- ① NEW CB AT 122+50.00 LT
- ~~② VT 107 STA 122+50.00 LT ~ 122+67.00 RT
NEW 18" X 28'-0" CPEP/CAAP/PCCSP~~
- ③ VT 107 STA 122+50.00 LT ~ 123+15.00 LT
NEW 18" X ~~62'-6"~~ 60'-0" CPEP/CAAP/PCCSP
- ④ NEW CB AT 122+67.00 RT
- ⑤ NEW CB AT 123+15.00 LT
- ~~⑥ VT 107 STA 123+15.00 LT ~ 123+75.00 RT
NEW 18" X 85'-6" CPEP/CAAP/PCCSP~~
- ④A RELAY 14' OF EXISTING PIPE AT 122+47 - 122+61 RT
NEW 18" X 6' CPEP 122+61 - 122+67 RT
NEW 18" X 54' CPEP 122+67 - 123+15 RT
- ⑤A NEW CB AT 123+15 RT
- ⑥A VT 107 STA 123+15 LT - 123+15 RT
NEW 18" X 22' CPEP
- ⑥B VT 107 STA 123+15 - 124+00 RT
NEW 18" X 82' CPEP

CB = DENOTES PRECAST REINFORCED CONCRETE CATCH BASIN
DI = DENOTES DROP INLET

NOTE : SEE PIPE PROFILE SHEET 1 AND MAINLINE CROSS SECTIONS FOR ADDITIONAL INFORMATION ON STORMWATER CATCH BASINS AND PIPES.

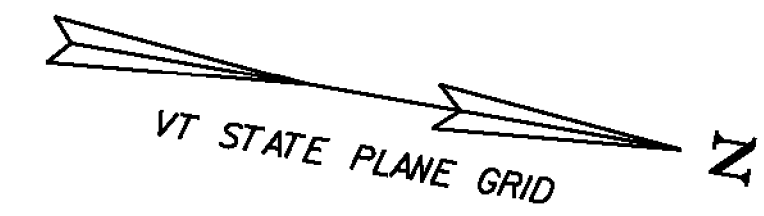

SCALE 1" = 20'-0"
20 0 20

UTILITIES AND DRAINAGE LAYOUT SHEET 1

PROJECT NAME:	BETHEL	PLOT DATE:	20-MAY-2011
PROJECT NUMBER:	BRF 022-I(14)	DRAWN BY:	G. ROKES
FILE NAME:	s78f16lutlibdr.dgn	CHECKED BY:	S. SCRIBNER
PROJECT LEADER:	M. EVANS-MONGEON	UTILITIES AND DRAINAGE LAYOUT SHEET 1	SHEET 22 OF 148