
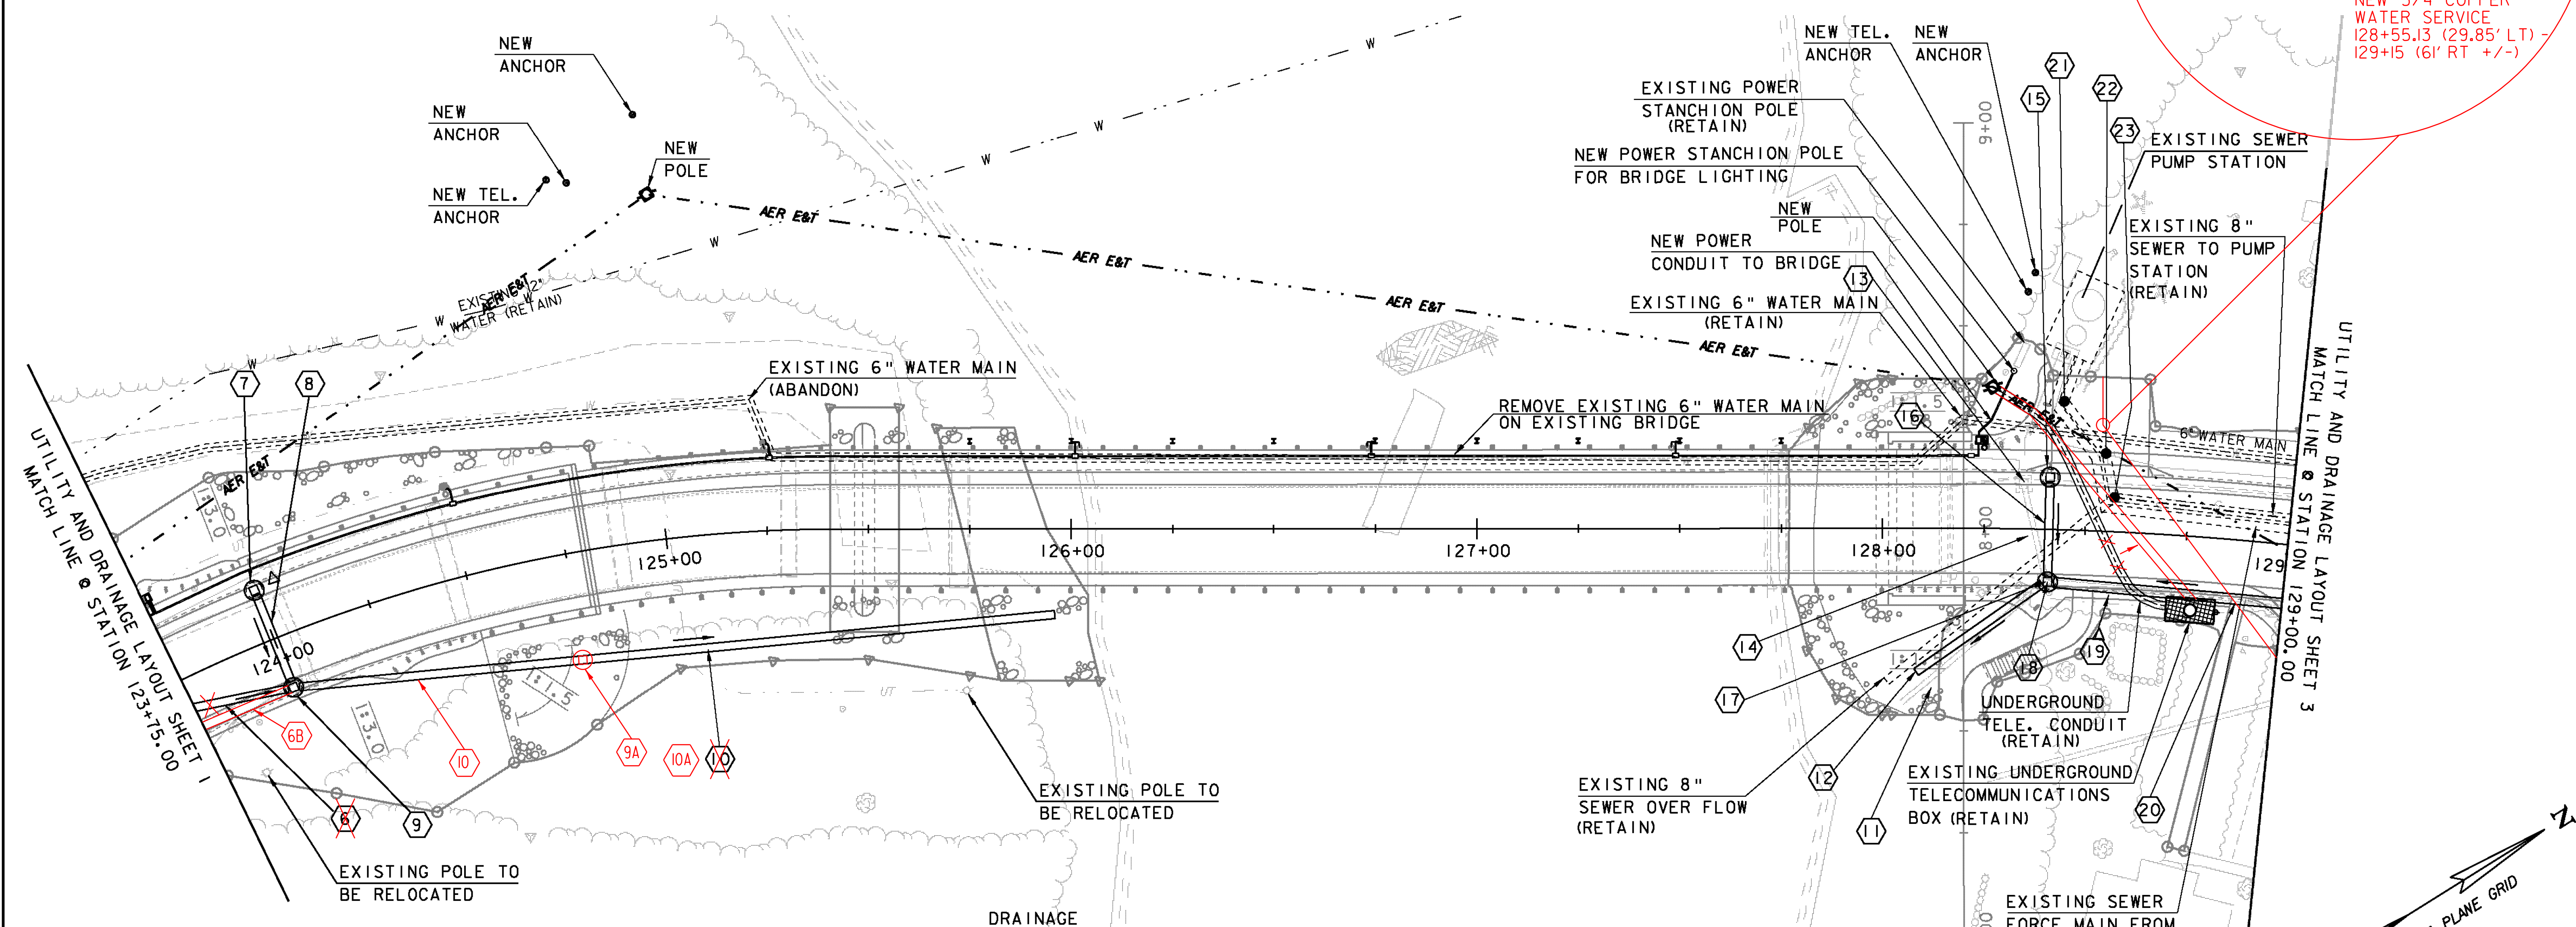


CB = DENOTES PRECAST REINFORCED CONCRETE CATCH BASIN  
 DI = DENOTES DROP INLET

NOTE : SEE PIPE PROFILE SHEET 1 AND SHEET 2, DRAINAGE  
 DETAIL SHEET, AND MAINLINE CROSS SECTIONS FOR  
 ADDITIONAL INFORMATION ON STORMWATER CATCH  
 BASINS AND PIPES.

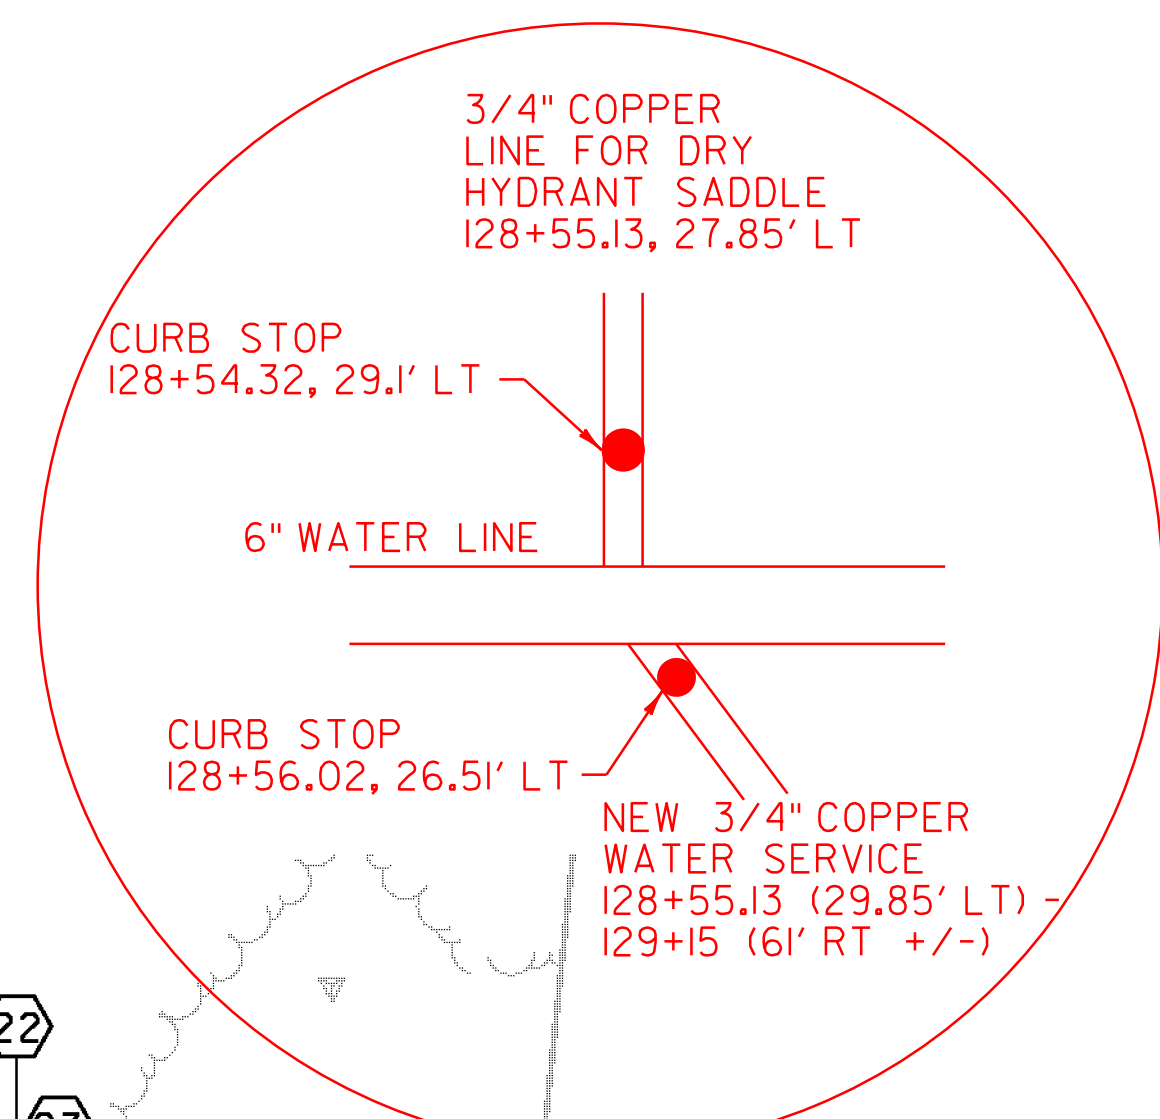

- |   |  |  |   |
|---|--|--|---|
| <p>6B VT 107 STA 123+15 -124+00 RT NEW 18" X 82" CPEP</p> <p>9A NEW CB AT STA 124+75 RT</p> <p>10A VT 107 STA 124+75.00 RT TO 125+95.90 RT PIPE OUTLET OFFSET 2'-2" 182'-0"</p> | <p>6 <del>VT 107 STA 123+75.00 RT ~ 124+00.00 RT NEW 18" LENGTH 85'-6" CPEP/CAAP/PCCSP</del></p> <p>7 NEW CB AT 124+00.00 LT</p> <p>8 VT 107 STA 124+00.00 LT ~ 124+00.00 RT NEW 18" LENGTH 23'-0" CPEP/CAAP/PCCSP</p> <p>9 NEW CB AT 124+00.00 RT</p> <p>10 VT 107 STA 124+00.00 RT ~ 124+75.00 RT PIPE OUTLET OFFSET 2'-2" NEW 18" LENGTH 187'-0" CPEP/CAAP/PCCSP</p> <p>11 VT 107 STA 128+00.00 RT ~ 128+41.00 RT REMOVE EXISTING 24" LENGTH 40'-0" RCP</p> | <p>12 VT 107 STA 128+08.00 RT ~ 128+41.00 RT NEW 24" LENGTH 38'-0" CPEP/CAAP/PCCSP</p> <p>13 VT 107 STA 128+35.00 LT REMOVE EXISTING CAST IN PLACE DI</p> <p>14 VT 107 STA 128+35.00 LT ~ 128+41.00 RT REMOVE EXISTING 12" LENGTH 25'-0" RCP</p> <p>15 NEW CB* AT 128+41.00 LT</p> <p>16 VT 107 STA 128+41.00 LT ~ 128+41.00 RT NEW 18" LENGTH 23'-0" CPEP/CAAP/PCCSP</p> <p>17 VT 107 STA 128+41.00 RT REMOVE EXISTING CAST IN PLACE DI</p> | <p>18 NEW CB AT 128+41.00 RT</p> <p>19 VT 107 STA 128+41.00 RT ~ 129+00.00 RT REMOVE EXISTING 24" LENGTH 123'-6" RCP</p> <p>20 VT 107 STA 128+41.00 RT ~ 129+00.00 RT NEW 24" LENGTH 96'-6" CPEP/CAAP/PCCSP</p> <p>21 ADJUST SEWER MANHOLE COVER ELEVATION AT VT 107 STA 128+43.90 LT</p> <p>22 ADJUST SEWER MANHOLE COVER ELEVATION AT VT 107 STA 128+54.37 LT</p> <p>23 ADJUST SEWER MANHOLE COVER ELEVATION AT VT 107 STA 128+56.87 LT</p> |
|---|--|--|---|

**UTILITIES AND DRAINAGE LAYOUT SHEET 2**

PROJECT NAME: BETHEL  
 PROJECT NUMBER: BRF 022-1(14)

FILE NAME: s78f16utlibdr.dgn PLOT DATE: 20-MAY-2011  
 PROJECT LEADER: M. EVANS-MONGEON DRAWN BY: G. ROKES  
 DESIGNED BY: G. ROKES CHECKED BY: S. SCRIBNER  
 UTILITIES AND DRAINAGE LAYOUT SHEET 2 SHEET 23 OF 148

