

RIGHT - OF - WAY DETAIL SHEET


TABLE OF PROPERTY ACQUISITION

PARCEL NO.	PROPERTY OWNER	SHEET NO.	BEGINNING STATION	ENDING STATION	TAKE AREA±	REMAINDER AREA±	RIGHT			RECORDING DATA				REMARKS	
							TYPE	(T)/(P)	AREA ±	TITLE	DATE	TOWN / CITY	BOOK		PAGE
1	FEENEY, PAUL J. & DIETRE R.	25	122+16.00 RT				DRIVE	(T)		GTR	01/06/11	BETHEL	101	317	10' PAVED MM 0317
2A	TOWN OF BETHEL	25	121+70.00 LT 121+77.00 LT 121+78.16 LT	121+94.00 LT 121+94.00 LT			APPROACH INSTALL SLOPE	(T) (T) (T)		QCD	04/17/11	BETHEL	101	563-564	TH 69, MILLER DRIVE PDF
2B	TOWN OF BETHEL	25,26	122+85.00 LT 123+89.27 LT 123+85.31 LT 123+85.31 LT 123+89.34 LT 124+00.17 LT 124+84.56 LT 125+40.50 LT 125+48.95 LT	125+73.53 LT 125+99.56 LT 125+99.56 LT 125+99.56 LT 124+00.56 LT 124+84.73 LT 125+02.87 LT 125+57.50 LT			DRIVE UE ACCESS CONST SLOPE SLOPE INSTALL & MAINTAIN CHANNEL INSTALL & MAINTAIN	(T) (P) (T) (T) (T) (P) (P) (P)	4,270 SF						15' GRAVEL MM 0319; IN COMMON WITH PARCEL 4 FOR CONSTRUCTION VEHICLES 6,112 SF±, INC. EC, PDF&BF, CRANE PAD GUY WIRES BRIDGE PIER & FOOTING
2C	TOWN OF BETHEL	25,26	123+43.99 RT 123+42.86 RT 123+64.03 RT 124+50.32 RT 125+79.03 RT	126+09.36 RT 126+09.41 RT 125+82.61 RT 125+67.87 RT 126+06.99 RT			DETOUR CONST SLOPE CULVERT CHANNEL	(T) (T) (P) (P) (P)	0.38A 0.11A 2,768 SF 310 SF						TWO WAY VEHICULAR/PEDESTRIAN WALKWAY 4,960 SF±, INC. EC, PDF & BF
2D	TOWN OF BETHEL	26	127+91.48 RT 127+82.48 RT 128+07.72 RT 127+97.71 RT 127+97.28 RT 128+52.76 RT	128+46.28 RT 128+37.78 RT 128+24.66 RT 128+08.88 RT 128+15.18 RT 128+20.99 RT			DETOUR CONST. CULVERT DRAINAGE CHANNEL INSTALL	(T) (T) (P) (P) (P) (T)	2,966 SF 1,586 SF						TWO WAY VEHICULAR/PEDESTRIAN WALKWAY INCLUDES EC & BF SIDEWALK AND STAIRS
2E		27	129+78.00 LT				APPROACH	(T)							TH 5 PEAVINE BOULEVARD
3	PIELA, MICHAEL W. & LESLIE K.	25	122+40.00 RT 122+49.00 RT 122+77.00 RT 122+98.69 RT 122+98.69 RT	122+69.00 RT 123+00.00 RT 123+45.13 RT 123+42.86 RT			DRIVE INSTALL INSTALL CONST. DETOUR	(T) (T) (T) (T) (T)	1,231 SF 726 SF	GTR	03/16/11	BETHEL	101	517	18' GRAVEL MM 0318 EC EC INCLUDES EC & PDF TWO WAY VEHICULAR/PEDESTRIAN WALKWAY
4	MILLER, HELEN	25,26	121+94.00 LT 121+94.00 LT 121+94.00 LT 122+25.00 LT 122+26.46 LT 122+71.55 LT 122+85.00 LT 122+85.00 LT 123+00.00 LT	122+10.00 LT 122+20.59 LT 123+93.41 LT 122+71.55 LT 123+89.34 LT 123+86.18 LT 123+89.55 LT			SLOPE INSTALL UE WALK INSTALL CONST DRIVE ACCESS SLOPE	(T) (T) (P) (T) (T) (T) (T) (T) (T)	19 SF 1,846 SF 3,641 SF 911 SF	WDOE	03/26/11	BETHEL	101	550-551	PDF 6' CONCRETE PDF INCLUDES PDF & EC 15' GRAVEL MM 0319. IN COMMON WITH PARCEL 2B FOR CONSTRUCTION VEHICLES

TABLE OF REVISIONS

REVISION NO.	SHEET NO.	DESCRIPTION	DATE
1	24	PARCEL NO. 6 RICHARDSON. CHANGE WHAT WAS INITIALLY A TAKING OF 336 SF± TO A "HIGHWAY (P)" 336 SF± MADE BY: MR PER C.O. 9611 APPROVED BY: HP	05/03/10
2	23	PARCEL NO. 2 TOWN OF BETHEL. CHANGE AREA OF CHANNEL RIGHT AT STATION 127+97.28 RT ~ 128+15.18 RT FROM 604 SF TO 318 SF. MADE BY: MR PER C.O. 9615 APPROVED BY: HP	05/27/10
3	23, 26	PARCEL NO. 2B TOWN OF BETHEL - AMEND BEGINNING STATION 123+89.10 LT TO 123+89.27 LT; AMEND END STATION 125+62.76 LT TO 125+73.53 LT; AMEND SF FROM 4,147 TO 4,270 SF; AMEND GUY WIRE BEGIN STATION FROM 125+06.18 TO 124+84.56 LT AND END STATION FROM 125+20.50 LT TO 125+02.87 LT. MADE BY: MT PER C.O. 9714 APPROVED BY: HP	05/18/11

PLOT DATE 05/18/11

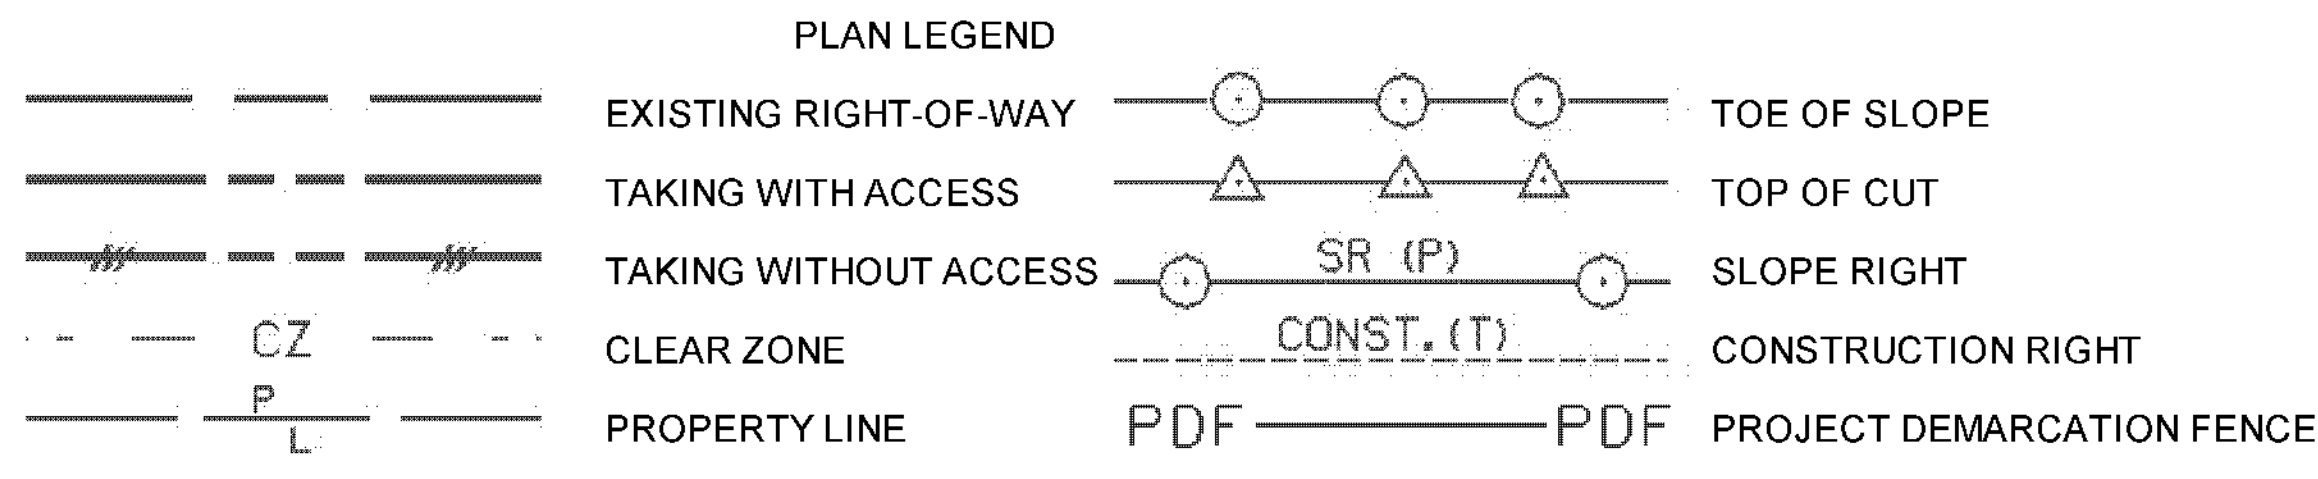

- EC - EROSION CONTROL
- (P) - PERMANENT
- (T) - TEMPORARY
- DR - DRAINAGE RIGHT
- DIT. - DITCHING RIGHT
- CH. - CHANNEL RIGHT
- DRIVE - DRIVE RIGHT
- CUL. - CULVERT RIGHT
- C&T - CLEARING & TRIMMING RIGHT
- SR - SLOPE RIGHT
- UE - UTILITY EASEMENT

APPROVED: HARRY PETROVS DATE: 02-01-10
CHIEF, PLANS & TITLES

PROJECT NAME: **BETHEL**
PROJECT NUMBER: **BRF 022-1(14)**
FILE NAME: **r 78f161 Detail Sheet.xls**
PROJECT LEADER: **M. EVANS-MONGEON**
DESIGNED BY: **S. SCRIBNER**
ROW DETAIL SHEET 1

PLOT DATE:
DRAWN BY: **MR**
CHECKED BY: **JB**
SHEET **28** OF **148**