


SOIL CLASSIFICATION  
 WINDSOR-AGAWAM COMPLEX  
 SLOPE 0-8%  
 "K FACTOR" 0.17  
 LOW ERODIBILITY

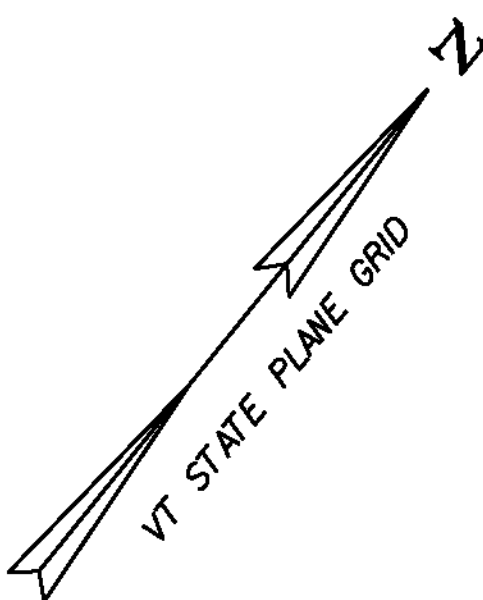

LEGEND

SOIL BOUNDARY	-----
WETLAND	▲▲▲▲
HISTORIC DISTRICT	----- HISTORIC DIST
AGRICULTURAL LAND	AG ----- AG
HISTORIC BUILDING	(H)

**EPSC EXISTING CONDITIONS SHEET 3**

PROJECT NAME: BETHEL	PLOT DATE: 20-MAY-2011
PROJECT NUMBER: BRF 022-1(14)	DRAWN BY: G. ROKES
FILE NAME: sfi61erobdr.dgn	CHECKED BY: S.S. SCRIBNER
PROJECT LEADER: M. EVANS-MONGEON	SHEET 36 OF 148
DESIGNED BY: S.S. SCRIBNER	
EPSC EXISTING CONDITIONS SHEET 3	