


LEGEND

RIPARIAN BUFFER	WETLAND	TEMP. CONSTRUCTION LIMITS	EROSION MATTING	PROJECT DEMARCATION FENCE	SILT FENCE	PERM. CONSTRUCTION LIMITS	DROP INLET PROTECTION	WOVEN WIRE SILT FENCE	BARRIER FENCE	FILTER CURTAIN	STABILIZED CONSTRUCTION ENTRANCE	STONE FILL, TYPE IV	ORDINARY HIGH WATER	HISTORIC DISTRICT	AGRICULTURAL LAND	HISTORIC BUILDING	DE-WATERING STRUCTURE
---	▲	○---△	▨	—PDF—	□	○---△	▩	□---X	BF ---X---	○---○---○	▩	○	---	---	AG	H	▨

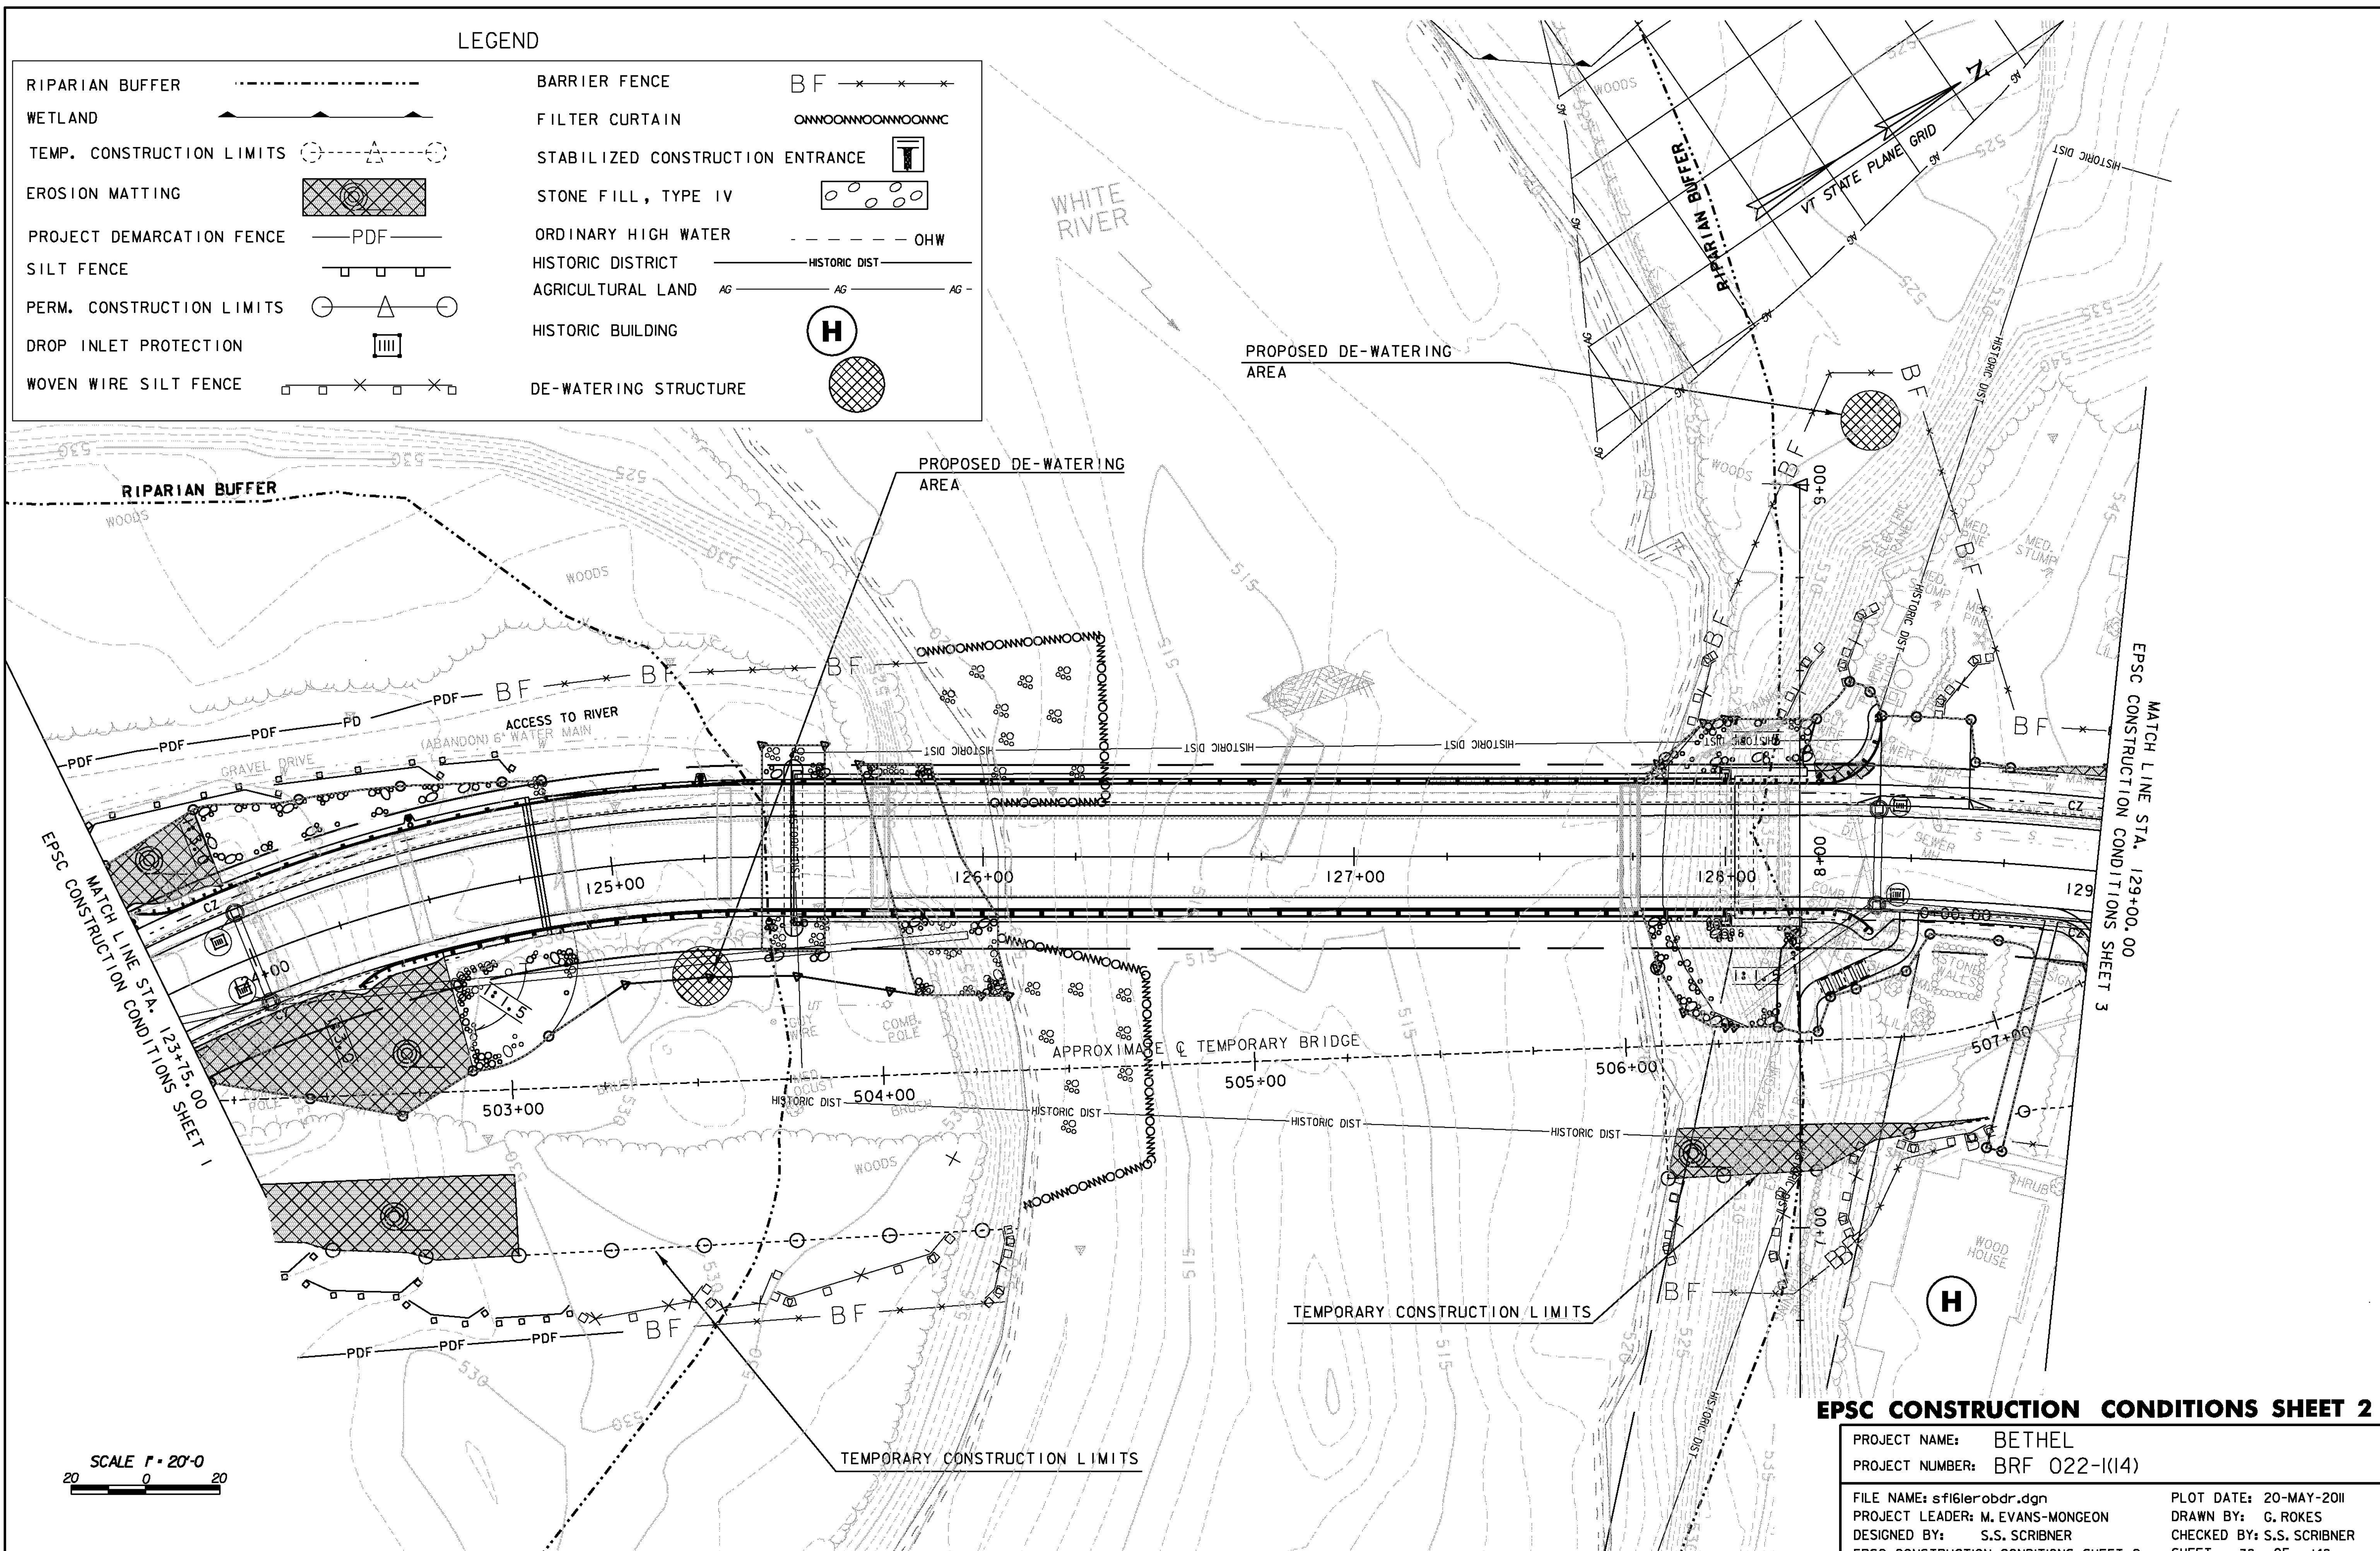

SCALE 1" = 20'-0"
 20 0 20

EPSC CONSTRUCTION CONDITIONS SHEET 2

PROJECT NAME: BETHEL
 PROJECT NUMBER: BRF 022-1(14)
 FILE NAME: sfi61erobdr.dgn
 PROJECT LEADER: M. EVANS-MONGEON
 DESIGNED BY: S.S. SCRIBNER
 EPSC CONSTRUCTION CONDITIONS SHEET 2

PLOT DATE: 20-MAY-2011
 DRAWN BY: G. ROKES
 CHECKED BY: S.S. SCRIBNER
 SHEET 38 OF 148