


LEGEND

EROSION CONTROL MATTING	
SILT FENCE	
PROJECT DEMARCATION FENCE	PDF — PDF
LIMITS OF SOIL DISTURBANCE	
DROP INLET PROTECTION	
STABILIZED CONSTRUCTION ENTRANCE	
HISTORIC BUILDING	

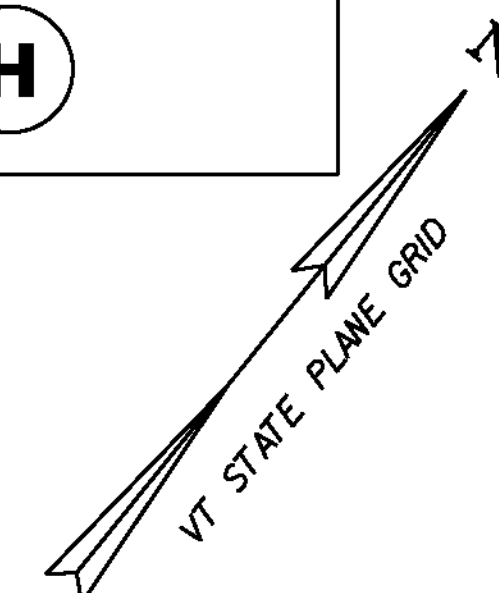

EPSC CONSTRUCTION CONDITIONS SHEET 3

PROJECT NAME:	BETHEL
PROJECT NUMBER:	BRF 022-1(14)
FILE NAME:	sf161erobdr.dgn
PROJECT LEADER:	M. EVANS-MONGEON
DESIGNED BY:	S.S. SCRIBNER
EPSC CONSTRUCTION CONDITIONS SHEET 3	
PLOT DATE:	20-MAY-2011
DRAWN BY:	G. ROKES
CHECKED BY:	S.S. SCRIBNER
SHEET 39 OF 148	