
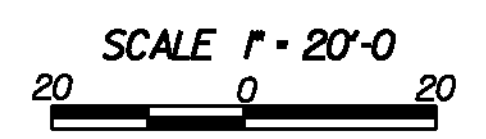


LEGEND

EROSION MATTING	
DISTURBED AREAS REQUIRING RE-VEGETATION	
LIMITS OF SOIL DISTURBANCE	

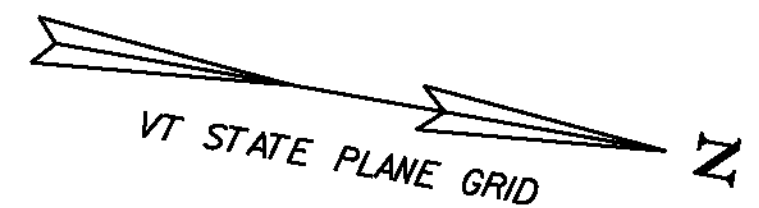

EPSC FINAL CONDITIONS SHEET 1

PROJECT NAME:	BETHEL
PROJECT NUMBER:	BRF 022-1(14)
FILE NAME:	sf161erob 196/236 r.196/236 gn
PROJECT LEADER:	M. EVANS-MONGEON
DESIGNED BY:	S. SCRIBNER
EPSC FINAL CONDITIONS SHEET 1	
PLOT DATE:	20-MAY-2011
DRAWN BY:	G. ROKES
CHECKED BY:	S. SCRIBNER
SHEET	40 OF 148