
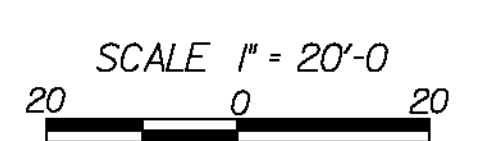


WHITE RIVER

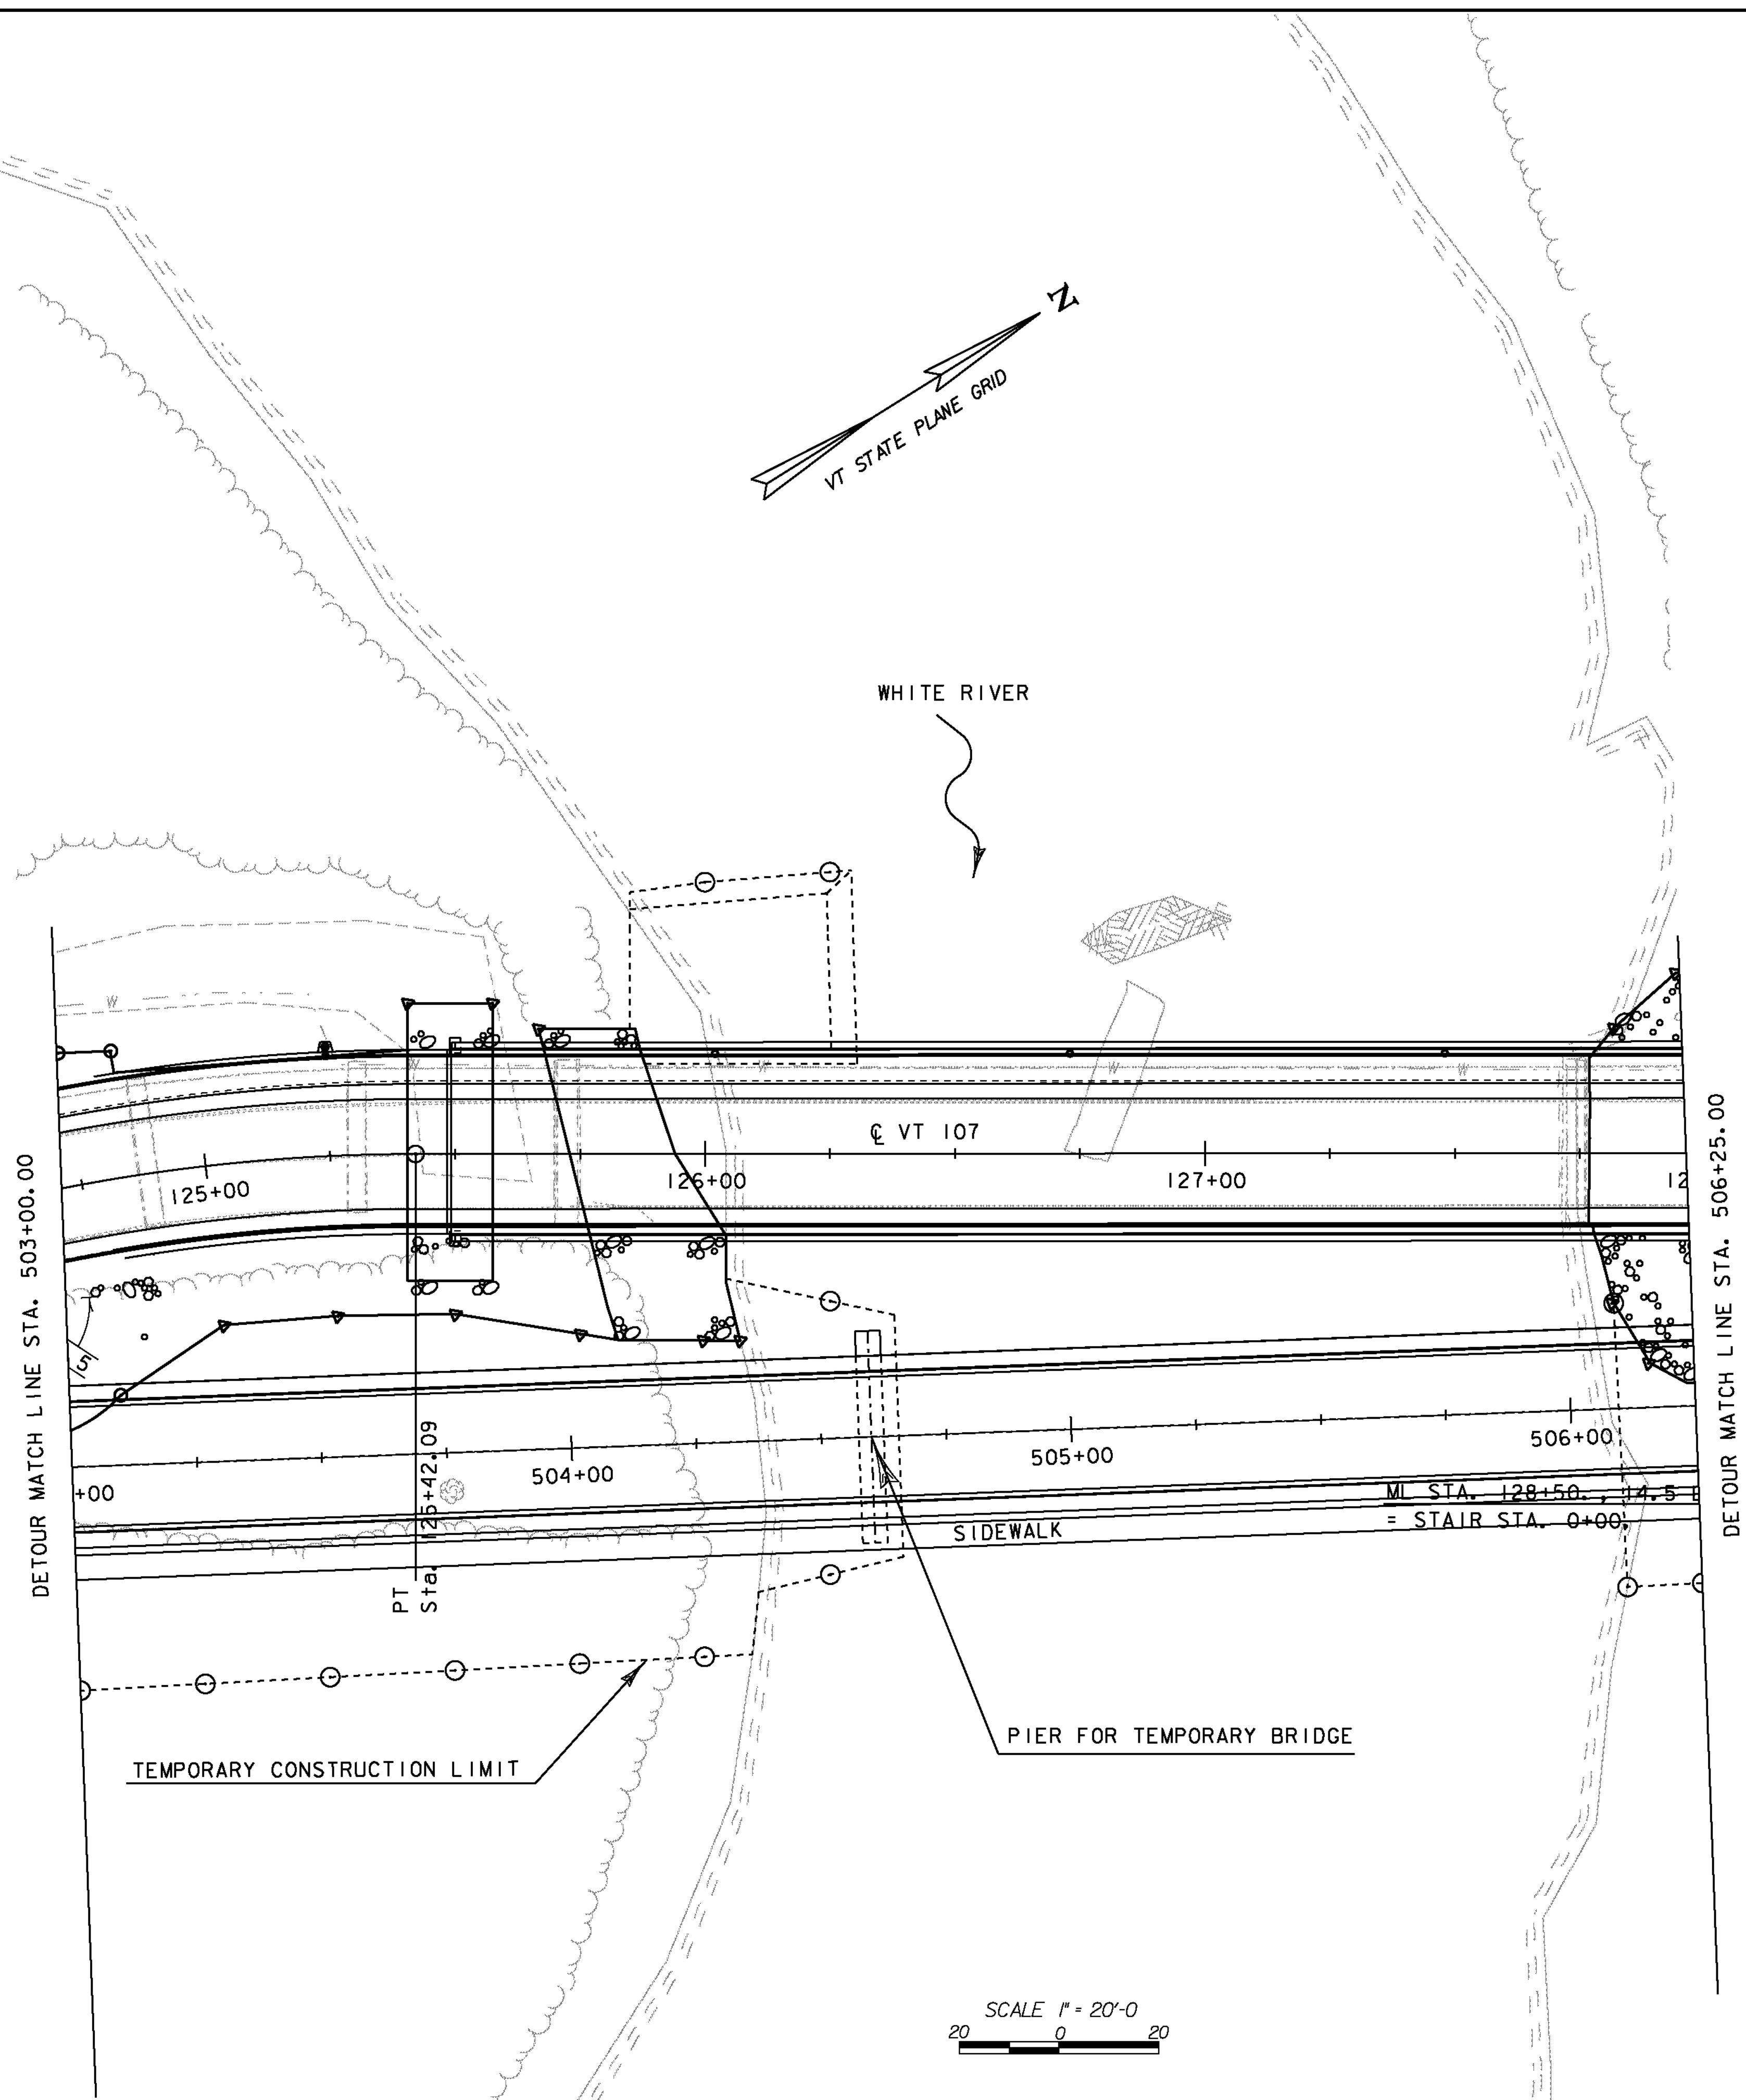

TEMPORARY DETOUR SHEET 2

PROJECT NAME: BETHEL	PLOT DATE: 20-MAY-2011
PROJECT NUMBER: BRF 022-1(14)	DRAWN BY: G. ROKES
FILE NAME: sf16idetbdr.dgn	CHECKED BY: S. SCRIBNER
PROJECT LEADER: M. EVANS-MONGEON	SHEET 47 OF 148
DESIGNED BY: G. ROKES	
TEMPORARY DETOUR SHEET 2	