



ABUTMENT #2 TYPICAL SECTION A-A

SCALE 1/4" = 1'-0"

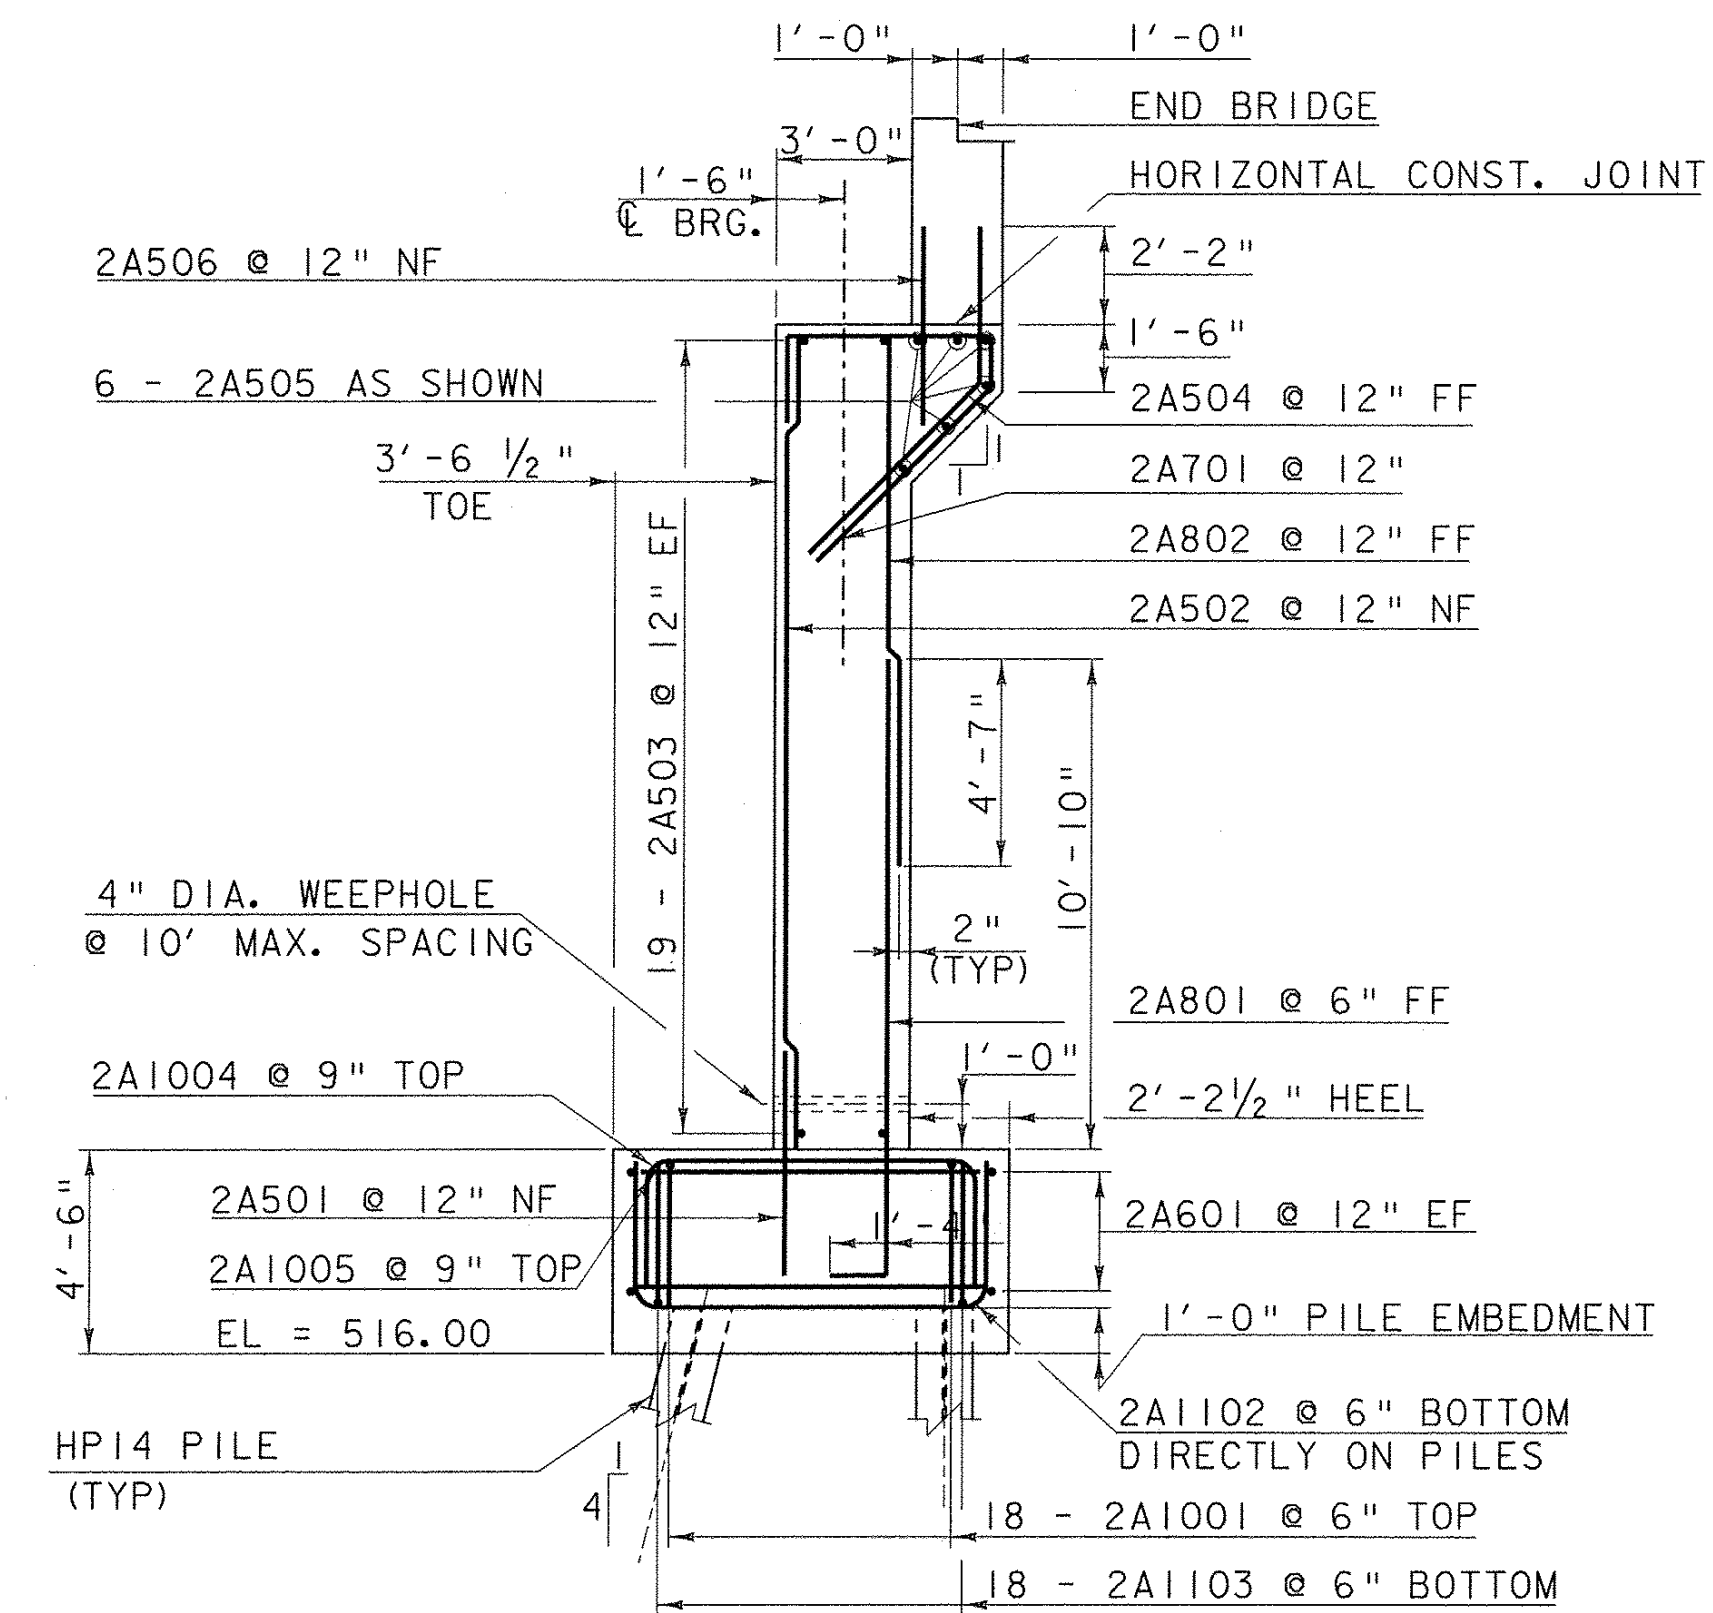


ABUTMENT #2 TYPICAL SECTION B-B

SCALE 1/4" = 1'-0"

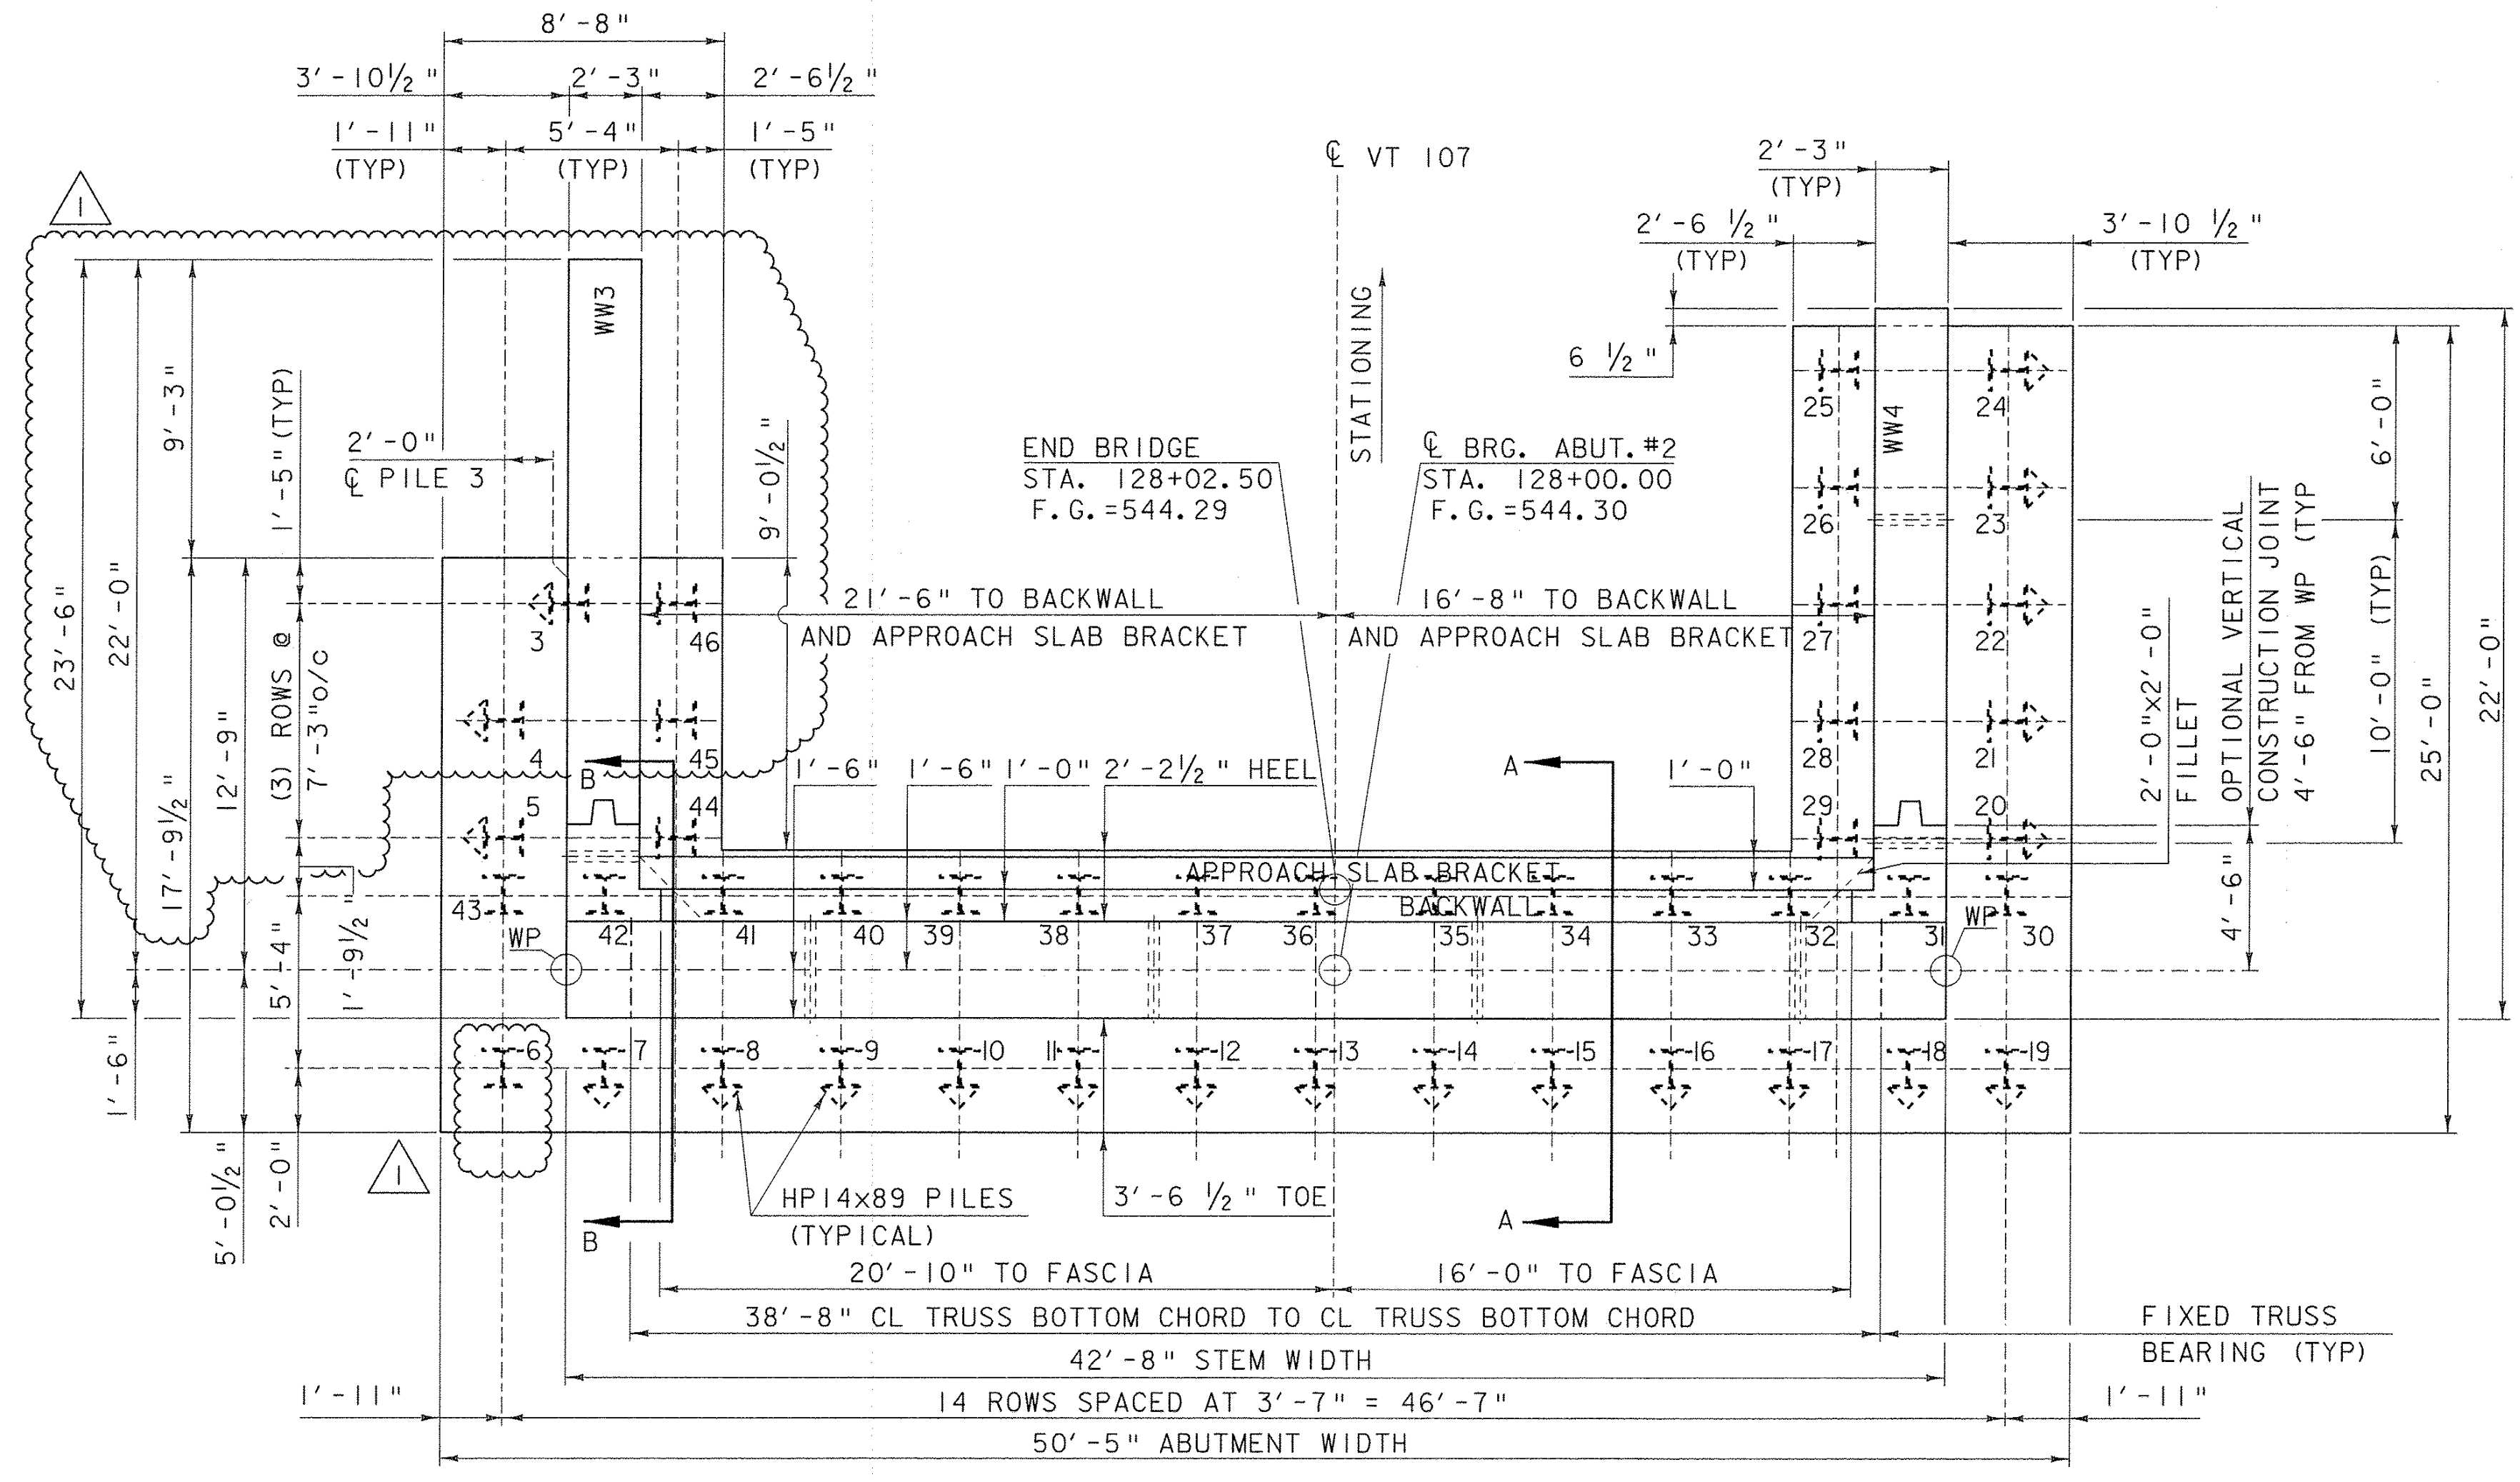

ABUTMENT #2 PLAN VIEW

SCALE 1/4" = 1'-0"

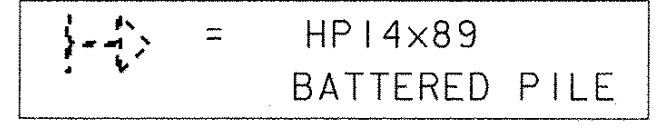

NOTE:

- NF = NEAR FACE
- FF = FAR FACE
- EF = EACH FACE
- ▲ = CUT TO FIT IN FIELD
- 3" CLEAR, UNLESS OTHERWISE SPECIFIED ON THE PLANS.
- 2'-2" BAR LAP UNLESS OTHERWISE SPECIFIED ON THE PLANS.

REVISION	DATE	DESCRIPTION	BY
1	01-27-2012	MODIFY WW3 FTG, REMOVE (4) PILES, RELOCATE PILE #3, CANTILEVER WW3	MCL

PROJECT NAME:	BETHEL	FILE NAME:	s78f16isub2.dgn	PLOT DATE:	30-JAN-2012
PROJECT NUMBER:	BRF 022-1(14)	PROJECT LEADER:	M. EVANS-MONGEON	DRAWN BY:	S. SCRIBNER
		DESIGNED BY:	S. SCRIBNER	CHECKED BY:	S. SCRIBNER
		ABUTMENT # 2 PLAN & TYPICALS		SHEET	66 OF 148