



W36x247 FLOOR BEAM  
CAMBER DIAGRAM

NTS

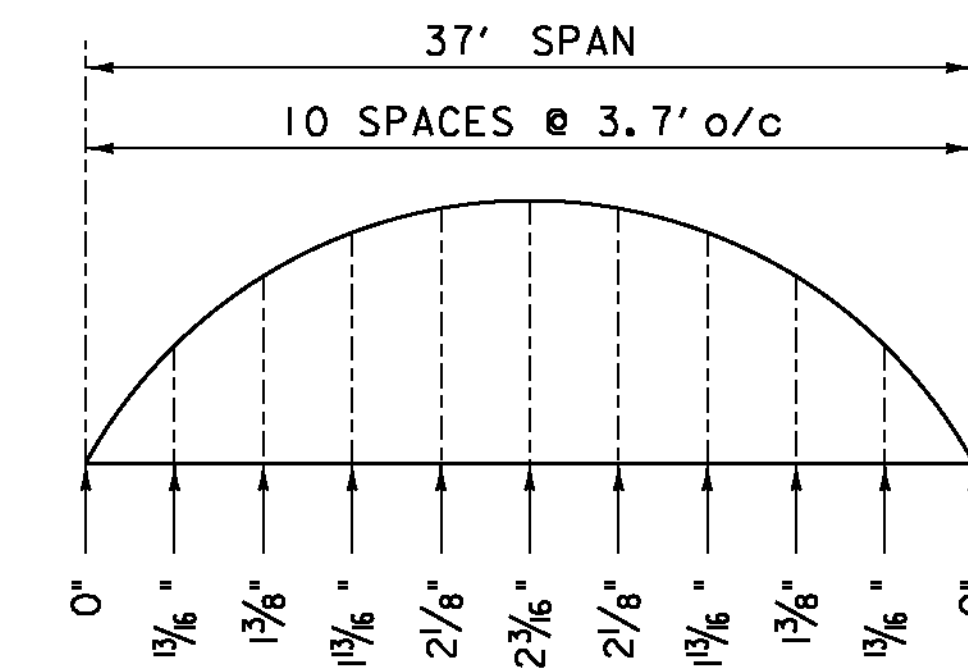

31" PLATE GIRDER  
CAMBER DIAGRAM

NTS

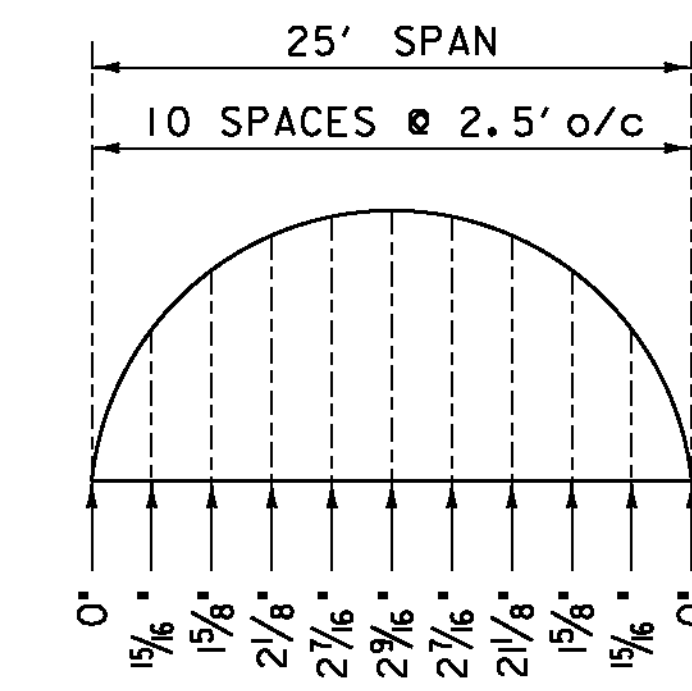

W24x55 STRINGER  
CAMBER DIAGRAM

NTS

PROJECT NAME: BETHEL	PLOT DATE: 20-MAY-2011
PROJECT NUMBER: BRF 022-1(14)	DRAWN BY: M. LONGSTREET
FILE NAME: s78f161truss.dgn	CHECKED BY: S.SCRIBNER
PROJECT LEADER: M. EVANS-MONGEON	SHEET 89 OF 148
DESIGNED BY: S. SCRIBNER	TRUSS FRAMING DETAIL SHEET 3